

ADDENDUM NO. D

BIDDING AND CONTRACT DOCUMENTS

FOR

**FALKIRK APARTMENTS SITE AND
SEISMIC IMPROVEMENT PROJECT**

PROJECT NO. 956390

CONTRACT NO. 956390-LF-2019-139



July 3, 2019

The following changes, additions, or deletions shall be made to the following documents as indicated for this Project; and all other terms and conditions shall remain the same. Each bidder is responsible for transmitting this information to all affected subcontractors and suppliers before the Bid Deadline.

1. ADVERTISEMENT FOR BIDS

Replace the existing Request for Bids with the one issued in this Addendum.

2. SPECIFICATIONS

- a. Replace the existing Specification Table of Contents with the one issued in this Addendum.
- b. Replace the existing Specification Section 05 52 13 Pipe and Tube Railings with the one issued in this Addendum.
- c. Add Specification Section 07 81 23 Intumescent Fireproofing issued in this Addendum.

3. LIST OF DRAWINGS

- a. Replace the existing List of Drawings with the one issued in this Addendum.

4. DRAWINGS

Replace existing Drawings with the ones issued in this Addendum.

SHEET NO.	TITLE	DATE
<u>T0.01</u>	<u>Title Sheet</u>	06/14/2019 <u>Addendum 2</u> <u>06/28/2019</u>
<u>A1.1</u>	<u>Overall Site Plan</u>	06/14/2019 <u>Addendum 2</u> <u>06/28/2019</u>
<u>A7-2.1</u>	<u>Building 7 – Floor Plan- Demolition</u>	06/14/2019 <u>Addendum 2</u> <u>06/28/2019</u>
<u>A7-2.2</u>	<u>Building 7 – Floor Plans</u>	06/14/2019 <u>Addendum 2</u> <u>06/28/2019</u>
<u>A8-2.1</u>	<u>Building 8 – Floor Plan - Demolition</u>	06/14/2019 <u>Addendum 2</u> <u>06/28/2019</u>
<u>A8-2.2</u>	<u>Building 8 – Floor Plans</u>	06/14/2019 <u>Addendum 2</u> <u>06/28/2019</u>
<u>A9-2.1</u>	<u>Building 9 – Floor Plan – Demolition</u>	06/14/2019 <u>Addendum 2</u> <u>06/28/2019</u>

<u>A9-2.2</u>	<u>Building 9 – Floor Plans</u>	06/14/2019 <u>Addendum 2</u> <u>06/28/2019</u>
<u>A14-2.1</u>	<u>Building 14 – Floor Plan – Demolition</u>	06/14/2019 <u>Addendum 2</u> <u>06/28/2019</u>
<u>A14-2.2</u>	<u>Building 14 – Floor Plans</u>	06/14/2019 <u>Addendum 2</u> <u>06/28/2019</u>
<u>A15-2.1</u>	<u>Building 15- Floor Plan Demolition</u>	06/14/2019 <u>Addendum 2</u> <u>06/28/2019</u>
<u>A15-2.2</u>	<u>Building 15 – Floor Plans</u>	06/14/2019 <u>Addendum 2</u> <u>06/28/2019</u>
<u>A16-2.1</u>	<u>Building 16 – Floor Plan – Demolition</u>	06/14/2019 <u>Addendum 2</u> <u>06/28/2019</u>
<u>A16-2.2</u>	<u>Building 16 – Floor Plans</u>	06/14/2019 <u>Addendum 2</u> <u>06/28/2019</u>
<u>A20-2.1</u>	<u>Building 20 – Floor Plan Demolition</u>	06/14/2019 <u>Addendum 2</u> <u>06/28/2019</u>
<u>A20-2-2</u>	<u>Building 20 – Floor Plan</u>	06/14/2019 <u>Addendum 2</u> <u>06/28/2019</u>
<u>A9.1</u>	<u>Enlarged Stair Plans & Sections</u>	06/14/2019 <u>Addendum 2</u> <u>06/28/2019</u>
<u>A9.2</u>	<u>Exterior Details</u>	06/14/2019 <u>Addendum 2</u> <u>06/28/2019</u>
<u>A9.3</u>	<u>Enlarged Balcony Plans & Details</u>	06/14/2019 <u>Addendum 2</u> <u>06/28/2019</u>
<u>E-0.1</u>	<u>Electrical Legends & Notes</u>	06/14/2019 <u>Addendum 2</u> <u>06/28/2019</u>
<u>E-0.2</u>	<u>Luminaire Schedule & Title 24 Forms</u>	06/14/2019 <u>Addendum 2</u> <u>06/28/2019</u>
<u>E-0.3</u>	<u>Single Line Diagram & Panel Schedules</u>	06/14/2019 <u>Addendum 2</u> <u>06/28/2019</u>

<u>E-1.0</u>	<u>Electrical Site Plan</u>	06/14/2019 <u>Addendum 2</u> <u>06/28/2019</u>
<u>E-2.1</u>	<u>Electrical Details</u>	06/14/2019 <u>Addendum 2</u> <u>06/28/2019</u>
<u>S0.1</u>	<u>General Notes</u>	06/14/2019 <u>Addendum 2</u> <u>06/28/2019</u>
<u>S1.1</u>	<u>Typical Details</u>	06/14/2019 <u>Addendum 2</u> <u>06/28/2019</u>
<u>S7-2.1</u>	<u>Building 7 Foundation & 2nd Floor Framing Plans</u>	06/14/2019 <u>Addendum 2</u> <u>06/28/2019</u>
<u>S8-2.1</u>	<u>Building 8 Foundation & 2nd Floor Framing Plans</u>	06/14/2019 <u>Addendum 2</u> <u>06/28/2019</u>
<u>S9-2.1</u>	<u>Building 9 Foundation & 2nd Floor Framing Plans</u>	06/14/2019 <u>Addendum 2</u> <u>06/28/2019</u>
<u>S14-2.1</u>	<u>Building 14 Foundation & 2nd Floor Framing Plans</u>	06/14/2019 <u>Addendum 2</u> <u>06/28/2019</u>
<u>S15-2.1</u>	<u>Building 15 Foundation & 2nd Floor Framing Plans</u>	06/14/2019 <u>Addendum 2</u> <u>06/28/2019</u>
<u>S16-2.1</u>	<u>Building 16 Foundation & 2nd Floor Framing Plans</u>	06/14/2019 <u>Addendum 2</u> <u>06/28/2019</u>
<u>S20-2.1</u>	<u>Building 20 (Rec Ctr) Foundation & Roof Framing Plans</u>	06/14/2019 <u>Addendum 2</u> <u>06/28/2019</u>
<u>S3.1</u>	<u>Stair Framing Plans & Details</u>	06/14/2019 <u>Addendum 2</u> <u>06/28/2019</u>
<u>S3.2</u>	<u>Balcony Framing Plans & Details</u>	06/14/2019 <u>Addendum 2</u> <u>06/28/2019</u>
<u>S4.1</u>	<u>Foundation Details</u>	06/14/2019 <u>Addendum 2</u> <u>06/28/2019</u>
<u>S5.1</u>	<u>Framing Details</u>	06/14/2019 <u>Addendum 2</u> <u>06/28/2019</u>

<u>MF-1</u>	<u>Frame Elevation Drawing</u>	08/17/2018 <u>Addendum 2</u> <u>06/28/2019</u>
<u>MF-2</u>	<u>Frame Elevation Drawing</u>	08/17/2018 <u>Addendum 2</u> <u>06/28/2019</u>
<u>SMF2</u>	<u>SMF Foundation Details</u>	08/17/2018 <u>Addendum 2</u> <u>06/28/2019</u>
<u>SMF3</u>	<u>SMF Installation Details</u>	08/17/2018 <u>Addendum 2</u> <u>06/28/2019</u>
<u>SMF4</u>	<u>SMF Installation Details</u>	08/17/2018 <u>Addendum 2</u> <u>06/28/2019</u>
<u>FA-0.1</u>	<u>Fire Alarm Legends & Notes</u>	06/14/2019 <u>Addendum 2</u> <u>06/28/2019</u>
<u>FA-0.2</u>	<u>Riser Diagram</u>	06/14/2019 <u>Addendum 2</u> <u>06/28/2019</u>
<u>FA-0.3</u>	<u>Fire Alarm Calculations</u>	06/14/2019 <u>Addendum 2</u> <u>06/28/2019</u>
<u>FA-1.0</u>	<u>Fire Alarm Site Plan</u>	06/14/2019 <u>Addendum 2</u> <u>06/28/2019</u>
<u>FA7-2.1</u>	<u>Fire Alarm Floor Plan – Building 7</u>	06/14/2019 <u>Addendum 2</u> <u>06/28/2019</u>
<u>FA8-2.1</u>	<u>Fire Alarm Floor Plan – Building 8</u>	06/14/2019 <u>Addendum 2</u> <u>06/28/2019</u>
<u>FA9-2.1</u>	<u>Fire Alarm Floor Plan – Building 9</u>	06/14/2019 <u>Addendum 2</u> <u>06/28/2019</u>
<u>FA20-2.1</u>	<u>Fire Alarm Floor Plan – Building 20</u>	06/14/2019 <u>Addendum 2</u> <u>06/28/2019</u>
<u>FA-3.1</u>	<u>Fire Alarm Details</u>	06/14/2019 <u>Addendum 2</u> <u>06/28/2019</u>

5. REQUESTS FOR CLARIFICATION

RFI No.	QUESTIONS / ANSWERS
1-6	<p>Question: Please confirm that all buildings are empty when construction starts.</p> <p>Answer: Residences will be vacated in buildings 7-9, & 15-16.</p>
1-7	<p>Question: Please advise of total amount of permits and fees to be paid by the General Contractor.</p> <p>Answer: Please review Division 1 Specifications for this information.</p>

END OF ADDENDUM

ADVERTISEMENT FOR BIDS

Subject to conditions prescribed by the University of California, Riverside, sealed bids for a lump sum contract are invited for the following Project:

Falkirk Apartments Site and Seismic Improvement Project

PROJECT NO. 956390
CONTRACT NO. 956390-LF-2019-139
UNIVERSITY OF CALIFORNIA, RIVERSIDE
RIVERSIDE, CALIFORNIA

The University of California, Riverside is requiring ADA Accessibility, Fire Alarm Upgrade, and Seismic improvements of the Falkirk Apartments complex buildings 7, 8, 9, 14, 15, 16 and the Community Room. The fire alarm system will be upgraded to current code, as well as fully addressable. The decks and stairs will be improved and strengthened to a new standard that extends their useful life, while minimizing risk. The seismic improvements of the soft story units of 14 thru 16 will meet the University of California Seismic Safety Policy ("UCSSP").

Estimated construction cost: **\$2,000,000**

Bidding and Contract Documents will be available at **Tuesday, June 18, 2019, at 2:00 PM**, and will issued only at:

IB Reprographics

3363 Durahart Street
Riverside, CA 92507
Phone: (951) 682-1850
Fax: (951) 682-2315
www.ibrepro.com

Each set of Bidding and Contract Documents will require a non-refundable payment to **IB Reprographics**. If paying by check, make your checks payable to "**IB Reprographics**." Bidding and Contract Documents will be mailed/shipped at the requestor's expense.

PRE-BID CONFERENCE & SITE VISIT

Bidders must attend a **mandatory** Pre-Bid Conference and Site Visit at, **Wednesday, June 19, 2019 on 10:00 AM**, at:

UNIVERSITY OF CALIFORNIA, RIVERSIDE
1223 University Avenue, Suite 210-16
Riverside, CA 92507

(Located in University Village, corner of University Avenue and Iowa Avenue.)

Phone: (951) 827-2528 Fax: (951) 827-4556

Bidders must provide their contact information and sign the Pre-Bid Conference and Site Visit attendance sheet. Only bidders who sign the attendance sheet will be eligible to submit bids for the Project as prime contractors.

Any bidder who enters the Pre-Bid Conference after 10:10 AM will be precluded from bidding as a prime contractor and may only bid as a subcontractor. Subcontractors are not required to attend; however we encourage their attendance.

UCR Planning, Design & Construction, will provide parking validation to anyone attending the Conference. We suggest that you arrive early to allow time to park and walk to the Conference location.

BID DEADLINE

Sealed bids must be received on or before **2:00 PM**, on ~~Tuesday, July 9, 2019~~, **Thursday, July 11, 2019**,
Bids will be received only at:

Planning, Design & Construction
UNIVERSITY OF CALIFORNIA, RIVERSIDE
1223 University Avenue, Suite 240
Riverside, CA 92507

Immediately following the Bid Deadline, bids will be opened at the same location.

Bid Security in the amount of 10% of the Lump Sum Base Bid shall accompany each Bid. The Surety issuing the Bid Bond shall be, on the Bid Deadline, an admitted surety insurer (as defined in California Code of Civil Procedure Section 995.120).

The successful Bidder and its subcontractors will be required to follow the nondiscrimination requirements set forth in the Bidding and Contract Documents and to pay prevailing wage rates at the location of the Work.

Every effort will be made to ensure that all persons have equal access to contracts and other business opportunities with the University within the limits imposed by law or University policy. Each Bidder may be required to show evidence of its equal employment opportunity policy. The successful Bidder and its subcontractors will be required to follow the nondiscrimination requirements set forth in the Bidding Documents and to pay prevailing wage at the location of the work.

The successful Bidder must have the following State of California Contractor's license current and active at the time of submission of the Bid: **B General Building**.

The work described in the contract is a public work subject to section 1771 of the California Labor Code.

No contractor or subcontractor, regardless of tier, may be listed on a Bid for, or engage in the performance of, any portion of this project, unless registered with the Department of Industrial Relations pursuant to Labor Code section 1725.5 and 1771.1.

This project is subject to compliance monitoring and enforcement by the Department of Industrial Relations.

The successful Bidder shall pay all persons providing construction services and/or any labor on site, including any University location, no less than the UC Fair Wage (defined as \$13 per hour as of 10/1/15, \$14 per hour as of 10/1/16, and \$15 per hour as of 10/1/17) and shall comply with all applicable federal, state and local working condition requirements.

THE REGENTS OF THE UNIVERSITY OF CALIFORNIA
University of California, Riverside
Publication Dates: May 22, 2019 – June 5, 2019

SPECIFICATIONS

TABLE OF CONTENTS

Division 01 – General Requirements

<u>Initial Issue</u>	<u>Revision</u>	<u>Section #</u>	<u>Title</u>
		01 1100	Summary of Work
		01 1400	Work Restrictions
		01 2300	Alternates
		01 2500	Product Options, Requirements & Substitution Procedures
		01 2613	Requests for Information & Instructions (RFI) Procedures
		01 3113	Coordination
		01 3119	Project Meetings
		01 3200	Document Control
		01 3216	Schedules
		01 3280	Electronic Data Transfer
		01 3300	Submittals
		01 3520	Design Assist Procedures
		01 3543	Environmental Procedures
		01 3546	Indoor Air Quality Procedures & Requirements
		01 4100	Regulatory Requirements
		01 4200	References
		01 4300	Inspection of Work
		01 4500	Quality Control
		01 4516	Contractor's Quality Control Program
		01 4520	Concrete Moisture Testing
		01 5500	Vehicular Access and Parking
		01 5600	Temporary Barriers and Enclosures
		01 5700	Temporary Controls
		01 6000	Product Requirements

<u>Initial Issue</u>	<u>Revision</u>	<u>Section #</u>	<u>Title</u>
		01 7100	Examination and Preparation
		01 7123	Field Engineering
		01 7329	Cutting and Patching
		01 7400	Cleaning and Waste Management
		01 7700	Contract Closeout
		01 7839	As-Built Documents
		01 9113	General Commissioning Requirements
Division 2 – Existing Conditions			
		02 4116	Structure Demolition
		02 4119	Selective Demolition
Division 3 – Concrete			
		03 2000	Concrete Reinforcement
		03 3300	Cast-In-Place Concrete
		03 4800	Precast Concrete Stair Treads
Division 5 – Metals			
		05 1200	Structural Steel Framing
	<u>Addendum D</u>	<u>05 5213</u>	<u>Pipe and Tube Railings</u>
Division 6 – Wood, Plastic, and Composites			
		06 1000	Rough Carpentry
Division 7 – Thermal and Moisture Protection			
		07 1800	Traffic-Bearing Roof Deck Surfacing
		07 6200	Sheet Metal Flashing and Trim
		07 8413	Penetration Firestopping
	<u>Addendum D</u>	<u>07 8123</u>	<u>Intumescent Fireproofing</u>
		07 9200	Joint Sealants
Division 9 – Finishes			
		09 2116	Gypsum Board Assemblies
		09 2400	Portland Cement Plastering
		09 9113	Exterior Painting

Initial Issue Revision Section # Title

Division 26 – Electrical

26 0100	Basic Electrical Requirements
26 0519	Low-Voltage Electrical Power Conductors and Cables
26 0530	Grounding and Bonding for Electrical Systems
26 0533	Raceway and Boxes Fitting and Supports

**Division 28 – Electronic
Safety and Security**

28 3100	Fire Alarm
----------------	-------------------

Division 31 - Earthwork

31 1000	Site Clearing
----------------	----------------------

**Division 32 – Exterior
Improvements**

32 1216	Asphalt Paving
32 1313	Concrete Paving
32 1723	Pavement Markings

END OF SPECIFICATIONS
TABLE OF CONTENTS

**SECTION 05 52 13
PIPE AND TUBE RAILINGS**

PART 1 GENERAL

1.1 SUMMARY

- A. Section Includes:
 - 1. Steel pipe and tube railings.

1.2 ACTION SUBMITTALS

- A. Product Data: For the following:
 - 1. Manufacturer's product lines of mechanically connected railings.
 - 2. Railing brackets.
 - 3. Grout, anchoring cement, and paint products.
- B. Shop Drawings: Include plans, elevations, sections, details, and attachments to other work.
- C. Samples: For each type of exposed finish required.

1.3 INFORMATIONAL SUBMITTALS

- A. Product Test Reports: For pipe and tube railings, for tests performed by a qualified testing agency, according to ASTM E894 and ASTM E935.

PART 2 PRODUCTS

2.1 MANUFACTURERS

- A. Steel Pipe and Tube Railings:
 - 1. Basis-of-Design Product: Subject to compliance with requirements, provide product indicated on Drawings or comparable product by one of the following:
 - a. Wagner, R & B, Inc.

2.2 PERFORMANCE REQUIREMENTS

- A. Structural Performance: Railings, including attachment to building construction, shall withstand the effects of gravity loads and the following loads and stresses within limits and under conditions indicated:
 - 1. Handrails and Top Rails of Guards:
 - a. Uniform load of 50 lbf/ ft. applied in any direction.
 - b. Concentrated load of 200 lbf applied in any direction.
 - c. Uniform and concentrated loads need not be assumed to act concurrently.
 - 2. Infill of Guards:
 - a. Concentrated load of 50 lbf applied horizontally on an area of 1 sq. ft..

- b. Infill load and other loads need not be assumed to act concurrently.

2.3 STEEL AND IRON

- A. Tubing: ASTM A500 (cold formed) or ASTM A513.
- B. Pipe: ASTM A53/A53M, Type F or Type S, Grade A, Standard Weight (Schedule 40), unless another grade and weight are required by structural loads.
- C. Plates, Shapes, and Bars: ASTM A36/A36M.

2.4 MISCELLANEOUS MATERIALS

- A. Welding Rods and Bare Electrodes: Select according to AWS specifications for metal alloy welded.
- B. Etching Cleaner for Galvanized Metal: Complying with MPI#25.
- C. Galvanizing Repair Paint: High-zinc-dust-content paint complying with SSPC-Paint 20 and compatible with paints specified to be used over it.
- D. Shop Primers: Provide primers that comply with Section 099113 "Exterior Painting".
- E. Shop Primer for Galvanized Steel: Primer formulated for exterior use over zinc-coated metal and compatible with finish paint systems indicated.
- F. Epoxy Intermediate Coat: Complying with MPI #77 and compatible with primer and topcoat.
- G. Polyurethane Topcoat: Complying with MPI #72 and compatible with undercoat.
- H. Bituminous Paint: Cold-applied asphalt emulsion complying with ASTM D1187/D1187M.
- I. Non-shrink, Nonmetallic Grout: Factory-packaged, non-staining, noncorrosive, nongaseous grout complying with ASTM C1107/C1107M. Provide grout specifically recommended by manufacturer for interior and exterior applications.

2.5 MISCELLANEOUS MATERIALS

- A. Cut, drill, and punch metals cleanly and accurately. Remove burrs and ease edges to a radius of approximately 1/32 inch unless otherwise indicated. Remove sharp or rough areas on exposed surfaces.
- B. Form work true to line and level with accurate angles and surfaces.
- C. Welded Connections: Cope components at connections to provide close fit, or use fittings designed for this purpose. Weld all around at connections, including at fittings.
 - 1. Use materials and methods that minimize distortion and develop strength and corrosion resistance of base metals.
 - 2. Obtain fusion without undercut or overlap.
 - 3. Remove flux immediately.

4. At exposed connections, finish exposed surfaces smooth and blended so no roughness shows after finishing and welded surface matches contours of adjoining surfaces.
- D. Nonwelded Connections: Connect members with concealed mechanical fasteners and fittings. Fabricate members and fittings to produce flush, smooth, rigid, hairline joints.
- E. Form changes in direction by bending.
- F. For changes in direction made by bending, use jigs to produce uniform curvature for each repetitive configuration required. Maintain cross section of member throughout entire bend without buckling, twisting, cracking, or otherwise deforming exposed surfaces of components.
- G. Close exposed ends of railing members with prefabricated end fittings.
- H. Provide wall returns at ends of wall-mounted handrails unless otherwise indicated.
- I. Brackets, Flanges, Fittings, and Anchors: Provide wall brackets, flanges, miscellaneous fittings, and anchors to interconnect railing members to other work unless otherwise indicated.

2.6 MISCELLANEOUS MATERIALS

- A. Galvanized Railings:
 1. Hot-dip galvanize exterior steel railings, including hardware, after fabrication.
 2. Comply with ASTM A123/A123M for hot-dip galvanized railings.
 3. Comply with ASTM A153/A153M for hot-dip galvanized hardware.
- B. Preparing Galvanized Railings for Shop Priming: After galvanizing, thoroughly clean railings of grease, dirt, oil, flux, and other foreign matter, and treat with etching cleaner.
- C. Preparation for Shop Priming: Prepare uncoated ferrous-metal surfaces to comply with SSPC-SP6/NACE No. 3, "Commercial Blast Cleaning."
- D. Primer Application: Apply shop primer to prepared surfaces of railings unless otherwise indicated. Comply with requirements in SSPC-PA 1, "Shop, Field, and Maintenance Painting of Steel," for shop painting. Primer need not be applied to surfaces to be embedded in concrete or masonry.

PART 3 EXECUTION

3.1 INSTALLATION, GENERAL

- A. Set railings accurately in location, alignment, and elevation; measured from established lines and levels and free of rack.
 1. Do not weld, cut, or abrade surfaces of railing components that are coated or finished after fabrication and that are intended for field connection by mechanical or other means without further cutting or fitting.
 2. Set posts plumb within a tolerance of 1/16 inch in 3 feet.
 3. Align rails so variations from level for horizontal members and variations from parallel with

rake of steps and ramps for sloping members do not exceed 1/4 inch in 12 feet.

- B. Control of Corrosion: Prevent galvanic action and other forms of corrosion by insulating metals and other materials from direct contact with incompatible materials.
 - 1. Coat, with a heavy coat of bituminous paint, concealed surfaces of aluminum that are in contact with grout, concrete, masonry, wood, or dissimilar metals.

3.2 ANCHORING POSTS

- A. Use metal sleeves preset and anchored into concrete for installing posts. After posts are inserted into sleeves, fill annular space between post and sleeve with non-shrink, nonmetallic grout, mixed and placed to comply with anchoring material manufacturer's written instructions.
- B. Form or core-drill holes not less than 5 inches deep and 3/4 inch larger than OD of post for installing posts in concrete. Clean holes of loose material, insert posts, and fill annular space between post and concrete with non-shrink, nonmetallic grout, mixed and placed to comply with anchoring material manufacturer's written instructions.
- C. Anchor posts to metal surfaces with oval flanges, angle type, or floor type as required by conditions, connected to posts and to metal supporting members.

3.3 ADJUSTING AND CLEANING

- A. Touchup Painting: Immediately after erection, clean field welds, bolted connections, and abraded areas of shop paint, and paint exposed areas with the same material as used for shop painting to comply with SSPC-PA 1 requirements for touching up shop-painted surfaces.
- B. Galvanized Surfaces: Clean field welds, bolted connections, and abraded areas, and repair galvanizing to comply with ASTM A780/A780M.

END OF SECTION

**SECTION 07 81 23
INTUMESCENT FIREPROOFING**

PART 1 GENERAL

1.1 RELATED DOCUMENTS

- A. Drawings and general provisions of the contract, including General and Supplementary Conditions Specification Sections apply to this section.

1.2 DEFINITIONS

- A. Intumescent coatings: Material or combination of fireproofing materials used to help retain the structural integrity of steel members by maintaining an effective thermal barrier to provide fire resistance rating as documented by listings from accredited test laboratories.

1.3 GENERAL DESCRIPTION OF THE WORK IN THIS SECTION

- A. Intumescent coatings applied to primary and secondary structural steel members to provide specified fire resistance rating.

1.4 RELATED WORK

- A. Coordinate work of this section with work of other sections as required to properly execute the work and as necessary to maintain satisfactory progress of the work of other sections, including:
 1. Section 03 30 00 – Cast-In-Place Concrete
 2. Section 05 12 00 – Structural Steel Framing
 3. Section 09 91 13 – Exterior Painting

1.5 REFERENCES

- A. Underwriters Laboratories Inc. (UL) Fire Resistance Directory
- B. Test Requirements and Reference Standards:
 1. ASTM E119, "Standard Test Methods for Fire Tests of Building Construction and Materials"
 2. ASTM E84, "Standard Test Method for Surface Burning Characteristics of Building Materials"
 3. ASTM D2240, "Standard Test Method for Rubber Property—Durometer Hardness"
 4. ASTM D2794, "Standard Test Method for Resistance of Organic Coatings to the Effects of Rapid Deformation (Impact)"
 5. ASTM D4060, "Standard Test Method for Abrasion Resistance of Organic Coatings by the Taber Abraser"
 6. ASTM D4541, "Standard Test Method for Pull-Off Strength of Coatings Using Portable Adhesion Testers"
 7. ASTM E329-09, "Standard Specification for Agencies Engaged in Construction Inspection and Testing"
 8. National Fire Protection Association, NFPA 251

9. Underwriters Laboratories Inc. (UL) ANSI/UL263
 10. Underwriters Laboratories of Canada (ULc) CAN/ULC S101-M
 11. Association of the Wall and Ceiling Industry, AWCI Technical Manual 12-B, current edition.
- C. Building codes: International Building Code (IBC)
- D. Industry References:
1. Underwriters Laboratories (UL), www.ul.com
 2. National Fireproofing Contractors Association (NFCA), www.nfca-online.org/
 3. The Society for Protective Coatings (SSPC), www.sspc.org/
 4. Association of the Wall and Ceiling Industry (AWCI), www.awci.org

1.6 QUALITY ASSURANCE

- A. Manufacturer Qualifications: Company responsible for the manufacture of fire protection materials with local direct technical employee(s) (as distinct from distributors or authorized agents) readily available at the project site. Intumescent coatings shall be manufactured under the follow-up services program of Underwriter's Laboratories (UL) or UL Canada (ULc) and bear the UL (and/or ULc) label (mark). Manufacturer's technical representative to be on site during start of installation and be generally available on site as requested during the application process.
- B. Installer Qualifications: Engage experienced Installer certified, licensed, or otherwise qualified by the intumescent coatings manufacturer as having the necessary training to install manufacturer's products, and otherwise have the experience and staff to properly perform the installation. Installer shall be trained by the intumescent coatings manufacturer's direct employee(s) (as distinct from distributors or authorized agents).
- C. Installation: Verify steel members have been properly prepared, including the use of a compatible primer, and install intumescent coatings in accordance with manufacturer's written recommendations published in their product technical literature and/or provided by manufacturer.
- D. Product Identification: Label packages (pail or bucket) with manufacturer name, product name, expiration date, freeze tag, UL or ULc label (mark).
- E. Special Inspection: Owner to employ a qualified independent inspection and testing agency to perform field quality control testing services in accordance with AWCI Technical Manual 12-B, local building code and Authority Having Jurisdiction requirements.
- F. Inspection and Testing Agency Qualifications: ASTM E329-09, "Standard Specification for Agencies Engaged in Construction Inspection and Testing" and AWCI Technical Manual 12-B.
- G. Field Constructed Mockups: Prior to installing intumescent coatings, Installer shall apply products specified for exposed applications to demonstrate aesthetic qualities and workmanship. Build mockups to comply with the following requirements, using materials indicated for final unit of Work.

1. Location: As indicated on drawings.
2. Extent of Mockups: Approximately 5 sq. ft. of surface for each product indicated.
3. Notify architect one week in advance of the dates and times when mockups will be built.
4. Obtain architect's written acceptance of mockups before start of actual unit of work.
5. Retain and maintain mockups during construction in undisturbed condition as a standard for judging completed units of work.
 - a. Accepted mockups in undisturbed condition at time of substantial completion may become part of completed unit of work.

1.7 SUBMITTALS

- A. Product data for each intumescent coating indicated on drawings.
- B. Product certificates from manufacturer documenting intumescent coatings comply with specified requirements including those for fire test response characteristics and compatibility with adhesives, primers, and other surface coatings on substrates indicated to receive intumescent coatings.
- C. Fire Resistance Rating Listings: UL, ULc, or other accredited testing agency indicating type and size of steel member to receive intumescent coatings and minimum dry thickness (mils) to achieve specified fire resistance rating.
- D. Qualification Data: Installer to demonstrate capabilities and experience on completed projects which are comparable in size and scope by providing the following information:
 1. Project location: City, State, and Country
 2. Scope of work: project type, contract valuation
 3. Completion date
 4. Architect: firm and contact information
 5. Owner: name and contact information
- E. LEED Submittals:
 1. Product Data for Credit EQ c4.2: Low emitting materials – Adhesives and sealants, documentation including printed statement of VOC content.
 2. VOC content: 0 g/L according to EPA method 24.

1.8 DELIVERY, STORAGE, AND HANDLING

- A. Deliver products to Project site in original, unopened packages with manufacturer's labels intact and legible.
- B. Install intumescent coatings prior to expiration date included on packaging. Properly discard expired product.
- C. Store intumescent coatings protected from direct sunlight and maintained at a temperature as specified by the manufacturer. The product must not be frozen, or stored at freezing temperatures. Verify proper storage of material as indicated by the freeze indicator label attached to the pail. Identify and label material damaged due to improper storage, remove

from Project site and properly discard.

1.9 PROJECT CONDITIONS

A. Environmental Conditions:

1. Do not install Intumescent Coatings when ambient or substrate temperatures are, or prior to full cure will be, outside the manufacturer's recommended installation temperatures, unless temporary protection and heating/cooling is provided to maintain temperatures within the prescribed range for the period specified by the manufacturer.
2. Do not install intumescent coatings when relative humidity is outside the limits established by the manufacturer. Consult manufacturer to determine precautions that may be implemented to prevent condensation from forming on the steel during application of fireproofing.
3. Do not install intumescent coatings when relative humidity exceeds 80%. Consult manufacturer to determine precautions that may be implemented to prevent condensation from forming on the steel during application of fireproofing.

- ### B. Ventilation: Ventilate areas where intumescent coatings will be installed by natural means or, where this is inadequate, forced air circulation during and after application until fireproofing dries thoroughly.

1.10 SEQUENCING

A. Sequence and coordinate application of intumescent coatings with related work specified in other Sections to comply with the following requirements:

1. Coordinate installation of intumescent coatings with other items of work that may interfere with proper installation of coatings.
2. Do not begin applying intumescent coatings until clips, hangers, supports, and other welded connections have been installed. Intumescent coatings manufacturer must approve in writing any clips, hangers, supports or connections that may be installed over coating using mechanical or adhesive devices.
3. Provide temporary enclosures as necessary to prevent deterioration of intumescent coatings due to exposure to unfavorable environmental conditions.
4. Take appropriate steps to avoid abrasion and other damage to the applied intumescent coatings during construction operations.
5. Do not protect or conceal structural members to which intumescent coatings have been applied until each area has been inspected, tested, and corrections have been made to any deficient areas.

PART 2 PRODUCTS

2.1 FIREPROOFING

- ### A. Intumescent coatings: Factory mixed formulation consisting of a modified heavy bodied coating, water based, with inorganic reinforcing fibers (non-asbestos, non fiber-glass) for spray application.

1. Products: Subject to compliance with requirements, provide the following:
 - a. Hilti Fire Finish CFP-SP WB by Hilti, Inc., (800) 879-8000, www.us.hilti.com or equal approved product.

B. Physical Characteristics:

1. Surface Burning Characteristics of Building Materials, ASTM E 84 (UL 723, CAN/ULC-S102): Class A Rating.
 - a. Flame Spread: 0
 - b. Smoke Development 45
2. Durometer Hardness, ASTM D2240: 96 Shore A
3. Impact Resistance, ASTM D2794: 93 in-lb
4. Abrasion Resistance, ASTM D4060: 0.140 g/1000 cycles
5. Adhesion, ASTM D4541: 507 psi

2.2 AUXILIARY FIREPROOFING MATERIALS

- A. General: Provide auxiliary fireproofing materials that are compatible with intumescent coating products and substrates and are approved by UL or other accredited testing agencies acceptable to authorities having jurisdiction for use in the fire resistive designs indicated.
- B. Substrate Primers: For use on each different substrate, provide primer that complies with the following requirements:
 1. Primer approved in writing by manufacturer of intumescent coatings, and applied in full compliance with the primer manufacturer's recommendations. Primer must be fully cured prior to installation of the intumescent coating.
- C. Topcoats: Suitable for application over applied intumescent coatings; of type recommended in writing by intumescent coatings manufacturer for each fire resistance design. Color of topcoat shall be as selected by the architect. Colors shall not be limited to manufacturer's standard colors.

PART 3 EXECUTION

3.1 PREPARATION

- A. Cover other work subject to damage from fall out or overspray of intumescent coatings materials during application. Provide temporary enclosure as required to confine spraying operations, protect the environment, and ensure maintaining adequate ambient conditions for temperature and ventilation.
- B. Clean substrates of substances that could impair bond of fireproofing, including oil, grease, rolling compounds, incompatible primers, and loose mill scale.
- C. Prime substrates except where compatible shop primer has been applied and is in satisfactory condition to receive intumescent coatings. Primer must be fully cured prior to applying intumescent coatings.

- D. Apply intumescent coatings: Protect intumescent coatings from rain, direct sunlight, high humidity, strong wind (with dirt, dust or sand) during the application and drying phases. Do not apply an additional coat of intumescent coating until previous layer has fully cured.
- E. For applications visible upon completion of project, repair substrates to remove surface imperfections that could affect uniformity of texture and thickness in finished surface of fireproofing. Remove minor projections that would telegraph through fire resistive products after application.

3.2 INSTALLATION, GENERAL

- A. Coordinate application of intumescent coatings with other construction to allow for proper application and minimize need to repair damage.
- B. Comply with intumescent coatings manufacturer's instructions for mixing materials, application procedures, and types of equipment used to convey and install products, as applicable to the particular conditions of installation and as required to achieve fire resistance ratings indicated.
- C. Coat substrates with primer and allow proper cure time prior to applying intumescent coatings as recommended by intumescent coatings manufacturer for material and application indicated.
- D. Apply intumescent coatings identical to mock-ups.

3.3 INSTALLING INTUMESCENT FIREPROOFING

- A. Apply intumescent coatings in thicknesses required to achieve fire resistance ratings designated for each condition.
- B. Provide a uniform finish complying with description indicated for type of material and matching finish approved for field erected mockup.

3.4 FIELD QUALITY CONTROL

- A. Inspection and Testing Agency: Coordinate installation of fireproofing with owner's independent inspection and testing agency.
- B. Inspection & testing shall be in accordance with AWCI Technical Manual 12-B.
- C. Testing agency will promptly report test results in writing to the installer and architect.
- D. Remove and replace intumescent coatings where test results indicate that fireproofing does not comply with specified requirements for adhesion.
- E. Apply additional intumescent coatings per manufacturer's directions where test results indicate that the thickness does not comply with specified requirements.
- F. Additional Testing: Where intumescent coatings are removed and replaced or repaired, Owner's inspection and testing agency shall perform additional testing to determine compliance with specified requirements.

3.5 CLEANING, REPAIR, AND PROTECTION

- A. Cleaning: Immediately after completing spraying operations in each containable area of Project, remove product over spray and fall out from surfaces of other construction and clean exposed surfaces to remove evidence of soiling.
- B. Cure intumescent coatings according to manufacturer's recommendations.
- C. Protect intumescent coatings from damage during construction.
- D. Repair or replace work that was not properly protected from damage during construction in accordance with manufacturer's recommendations.
- E. Ensure full curing of intumescent coating prior to application of top coat.

END OF SECTION

LIST OF DRAWINGS

SHEET NO.	TITLE	DATE
<u>T0.01</u>	<u>Title Sheet</u>	06/14/2019 <u>Addendum 2</u> 06/28/2019
<u>A1.1</u>	<u>Overall Site Plan</u>	06/14/2019 <u>Addendum 2</u> 06/28/2019
<u>A7-2.1</u>	<u>Building 7 – Floor Plan- Demolition</u>	06/14/2019 <u>Addendum 2</u> 06/28/2019
<u>A7-2.2</u>	<u>Building 7 – Floor Plans</u>	06/14/2019 <u>Addendum 2</u> 06/28/2019
<u>A8-2.1</u>	<u>Building 8 – Floor Plan - Demolition</u>	06/14/2019 <u>Addendum 2</u> 06/28/2019
<u>A8-2.2</u>	<u>Building 8 – Floor Plans</u>	06/14/2019 <u>Addendum 2</u> 06/28/2019
<u>A9-2.1</u>	<u>Building 9 – Floor Plan – Demolition</u>	06/14/2019 <u>Addendum 2</u> 06/28/2019
<u>A9-2.2</u>	<u>Building 9 – Floor Plans</u>	06/14/2019 <u>Addendum 2</u> 06/28/2019
<u>A14-2.1</u>	<u>Building 14 – Floor Plan – Demolition</u>	06/14/2019 <u>Addendum 2</u> 06/28/2019
<u>A14-2.2</u>	<u>Building 14 – Floor Plans</u>	06/14/2019 <u>Addendum 2</u> 06/28/2019
<u>A15-2.1</u>	<u>Building 15- Floor Plan Demolition</u>	06/14/2019 <u>Addendum 2</u> 06/28/2019
<u>A15-2.2</u>	<u>Building 15 – Floor Plans</u>	06/14/2019 <u>Addendum 2</u> 06/28/2019
<u>A16-2.1</u>	<u>Building 16 – Floor Plan – Demolition</u>	06/14/2019 <u>Addendum 2</u> 06/28/2019
<u>A16-2.2</u>	<u>Building 16 – Floor Plans</u>	06/14/2019 <u>Addendum 2</u> 06/28/2019

<u>A20-2.1</u>	<u>Building 20 – Floor Plan Demolition</u>	06/14/2019 <u>Addendum 2</u> <u>06/28/2019</u>
<u>A20-2-2</u>	<u>Building 20 – Floor Plan</u>	06/14/2019 <u>Addendum 2</u> <u>06/28/2019</u>
<u>A9.1</u>	<u>Enlarged Stair Plans & Sections</u>	06/14/2019 <u>Addendum 2</u> <u>06/28/2019</u>
<u>A9.2</u>	<u>Exterior Details</u>	06/14/2019 <u>Addendum 2</u> <u>06/28/2019</u>
<u>A9.3</u>	<u>Enlarged Balcony Plans & Details</u>	06/14/2019 <u>Addendum 2</u> <u>06/28/2019</u>
<u>E-0.1</u>	<u>Electrical Legends & Notes</u>	06/14/2019 <u>Addendum 2</u> <u>06/28/2019</u>
<u>E-0.2</u>	<u>Luminaire Schedule & Title 24 Forms</u>	06/14/2019 <u>Addendum 2</u> <u>06/28/2019</u>
<u>E-0.3</u>	<u>Single Line Diagram & Panel Schedules</u>	06/14/2019 <u>Addendum 2</u> <u>06/28/2019</u>
<u>E-1.0</u>	<u>Electrical Site Plan</u>	06/14/2019 <u>Addendum 2</u> <u>06/28/2019</u>
<u>E-2.1</u>	<u>Electrical Details</u>	06/14/2019 <u>Addendum 2</u> <u>06/28/2019</u>
<u>S0.1</u>	<u>General Notes</u>	06/14/2019 <u>Addendum 2</u> <u>06/28/2019</u>
<u>S1.1</u>	<u>Typical Details</u>	06/14/2019 <u>Addendum 2</u> <u>06/28/2019</u>
<u>S7-2.1</u>	<u>Building 7 Foundation & 2nd Floor Framing Plans</u>	06/14/2019 <u>Addendum 2</u> <u>06/28/2019</u>
<u>S8-2.1</u>	<u>Building 8 Foundation & 2nd Floor Framing Plans</u>	06/14/2019 <u>Addendum 2</u> <u>06/28/2019</u>
<u>S9-2.1</u>	<u>Building 9 Foundation & 2nd Floor Framing Plans</u>	06/14/2019 <u>Addendum 2</u> <u>06/28/2019</u>

<u>S14-2.1</u>	<u>Building 14 Foundation & 2nd Floor Framing Plans</u>	06/14/2019 <u>Addendum 2</u> <u>06/28/2019</u>
<u>S15-2.1</u>	<u>Building 15 Foundation & 2nd Floor Framing Plans</u>	06/14/2019 <u>Addendum 2</u> <u>06/28/2019</u>
<u>S16-2.1</u>	<u>Building 16 Foundation & 2nd Floor Framing Plans</u>	06/14/2019 <u>Addendum 2</u> <u>06/28/2019</u>
<u>S20-2.1</u>	<u>Building 20 (Rec Ctr) Foundation & Roof Framing Plans</u>	06/14/2019 <u>Addendum 2</u> <u>06/28/2019</u>
<u>S3.1</u>	<u>Stair Framing Plans & Details</u>	06/14/2019 <u>Addendum 2</u> <u>06/28/2019</u>
<u>S3.2</u>	<u>Balcony Framing Plans & Details</u>	06/14/2019 <u>Addendum 2</u> <u>06/28/2019</u>
<u>S4.1</u>	<u>Foundation Details</u>	06/14/2019 <u>Addendum 2</u> <u>06/28/2019</u>
<u>S5.1</u>	<u>Framing Details</u>	06/14/2019 <u>Addendum 2</u> <u>06/28/2019</u>
<u>MF-1</u>	<u>Frame Elevation Drawing</u>	08/17/2018 <u>Addendum 2</u> <u>06/28/2019</u>
<u>MF-2</u>	<u>Frame Elevation Drawing</u>	08/17/2018 <u>Addendum 2</u> <u>06/28/2019</u>
<u>SMF2</u>	<u>SMF Foundation Details</u>	08/17/2018 <u>Addendum 2</u> <u>06/28/2019</u>
<u>SMF3</u>	<u>SMF Installation Details</u>	08/17/2018 <u>Addendum 2</u> <u>06/28/2019</u>
<u>SMF4</u>	<u>SMF Installation Details</u>	08/17/2018 <u>Addendum 2</u> <u>06/28/2019</u>
<u>FA-0.1</u>	<u>Fire Alarm Legends & Notes</u>	06/14/2019 <u>Addendum 2</u> <u>06/28/2019</u>
<u>FA-0.2</u>	<u>Riser Diagram</u>	06/14/2019 <u>Addendum 2</u> <u>06/28/2019</u>

<u>FA-0.3</u>	<u>Fire Alarm Calculations</u>	06/14/2019 <u>Addendum 2</u> <u>06/28/2019</u>
<u>FA-1.0</u>	<u>Fire Alarm Site Plan</u>	06/14/2019 <u>Addendum 2</u> <u>06/28/2019</u>
<u>FA7-2.1</u>	<u>Fire Alarm Floor Plan – Building 7</u>	06/14/2019 <u>Addendum 2</u> <u>06/28/2019</u>
<u>FA8-2.1</u>	<u>Fire Alarm Floor Plan – Building 8</u>	06/14/2019 <u>Addendum 2</u> <u>06/28/2019</u>
<u>FA9-2.1</u>	<u>Fire Alarm Floor Plan – Building 9</u>	06/14/2019 <u>Addendum 2</u> <u>06/28/2019</u>
<u>FA20-2.1</u>	<u>Fire Alarm Floor Plan – Building 20</u>	06/14/2019 <u>Addendum 2</u> <u>06/28/2019</u>
<u>FA-3.1</u>	<u>Fire Alarm Details</u>	06/14/2019 <u>Addendum 2</u> <u>06/28/2019</u>


END OF LIST OF DRAWINGS




TYP. STAIR "B" - BLDG 7



TYP. STAIR "B" - BLDG 7

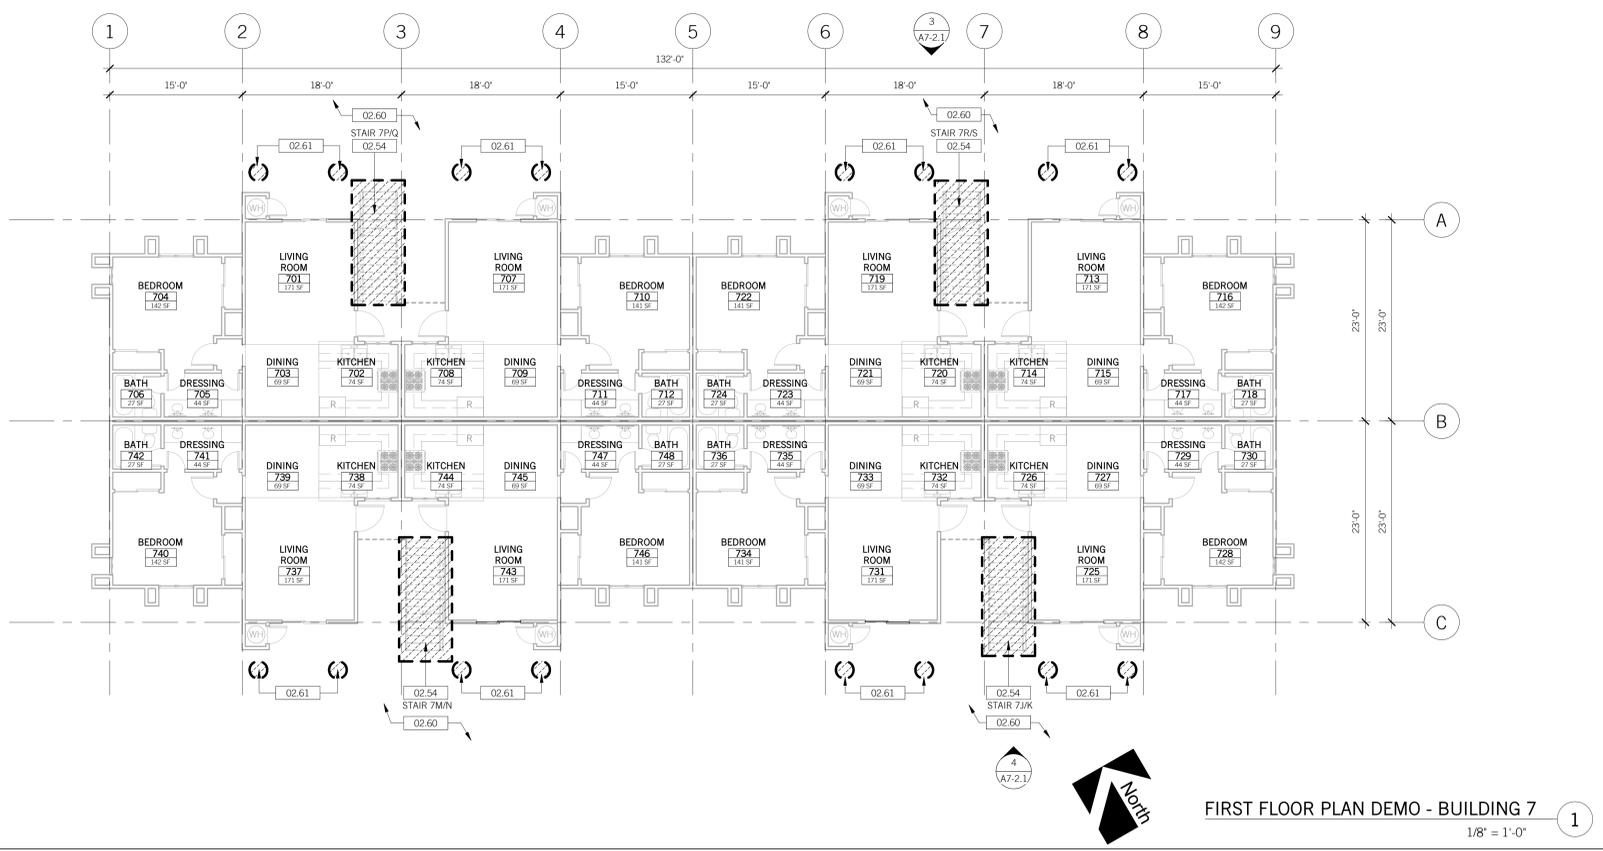

FIRST FLOOR PLAN DEMO - BUILDING 7

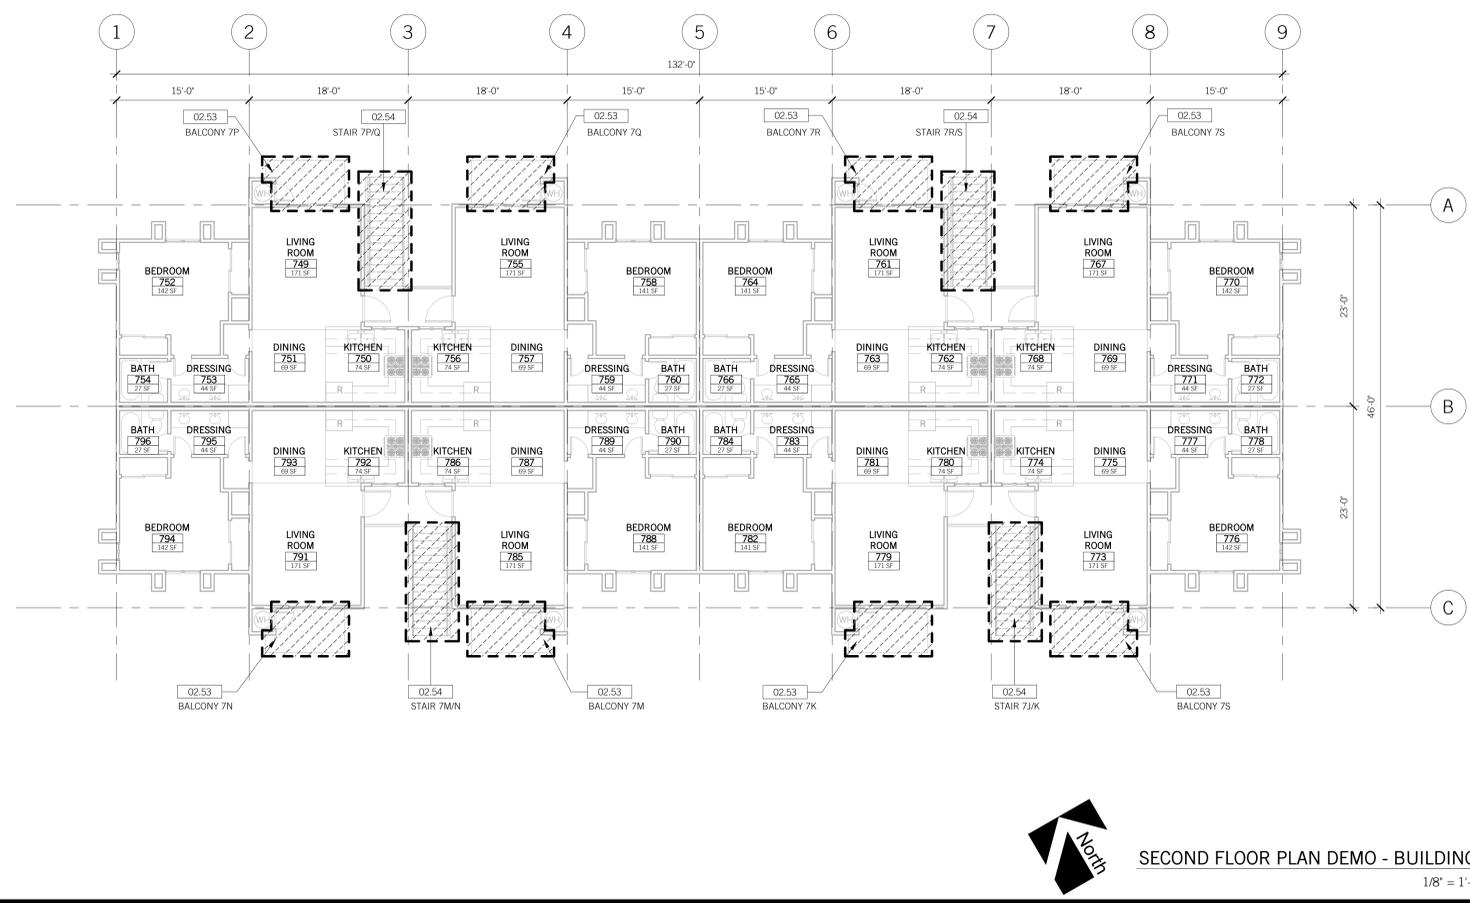

SECOND FLOOR PLAN DEMO - BUILDING 7

KEYNOTES

- 02.53 REMOVE (E) WOOD DECK. SEE STRUCTURAL DRAWINGS.
- 02.54 REMOVE (E) STAIRS, (E) FOOTING, (E) STEEL ATTACHMENTS AND WOOD HANDRAILS ATTACHED TO STUCCO AND WOOD SIDING CONDITIONS. DO NOT DEMO ANY SECOND FLOOR LANDING FRAMING OR POSTS. NOTIFY SEOR FOR ANY EXISTING MEMBERS IN QUESTION. PATCH AND REPAIR WALL FINISH AND (E) WALKWAY SLAB AFFECTED BY DEMO WORK TO MATCH EXISTING.
- 02.60 REMOVE AND REROUTE (E) SPRINKLER LINES AS NECESSARY.
- 02.61 REMOVE (E) PAVEMENT AS NECESSARY FOR NEW POST FOOTINGS. SEE STRUCTURAL DRAWINGS.

WALL LEGEND

(E) STUD WALL, PROTECT IN PLACE.

LEGEND

(E) DOOR, FRAME AND ALL HARDWARE, PROTECT IN PLACE.

(E) WINDOWS AND SYSTEMS, PROTECT IN PLACE.

AREA OF DEMOLITION.

miyamoto.
 1901 East Alhambra Avenue, Suite 100
 Santa Ana, CA 92705
 T: (949) 570-1170
 myamotointernational.com

LEONARD ARCHITECT
 Member A, B, C
 3080 12th Street, Suite 105
 Riverside, California 92507
 O: (951) 530-8278
 E: info@formillus.com
 W: formillus.com

Formillus
 ARCHITECTURE
 Building relationships. Transforming environments.

UNIVERSITY OF CALIFORNIA, RIVERSIDE
 FALKIRK SITE AND SEISMIC IMPROVEMENTS - SUMMER 2019
 3429 CANYON CREST DRIVE
 RIVERSIDE, CA 92507

REVISIONS

ADDENDUM 1	01/19
ADDENDUM 2	02/19

UCR PROJECT #: 956390
 UCR CAAN #: P5673
 DATE: 06-28-2019
 DRAWN: LR

BUILDING 7 - FLOOR PLAN - DEMOLITION A7-2.1


KEY PLAN

INSPECTIONS REQUIRED
 UC RIVERSIDE
 Office of Planning, Design & Construction
 Signed CEO: Blair E. Bellows
 Building, Safety and Compliance Division
 CAMPUS BUILDING PERMIT
 ALL WORK SHALL BE IN ACCORDANCE WITH UCRRS PERMITS


APPROVED
 UC RIVERSIDE
 Planning, Design and Construction
 Campus Building Division
 Signature: [Signature]
 Building & Safety Division
 Campus Building Permit

OFFICE OF THE STATE FIRE MARSHAL
 APPROVED FIRE AND PANIC ONLY
07/02/2019
 Approval of this plan does not authorize or approve any erection or deviation from applicable regulations. Final approval is subject to field inspection. One set of approved plans shall be available on the project site at all times.
 Reviewed by: [Signature]
 Fire and Life Safety Division

PLOTTED BY: LR
 PLOT DATE: 6/28/2019 8:46:31 AM

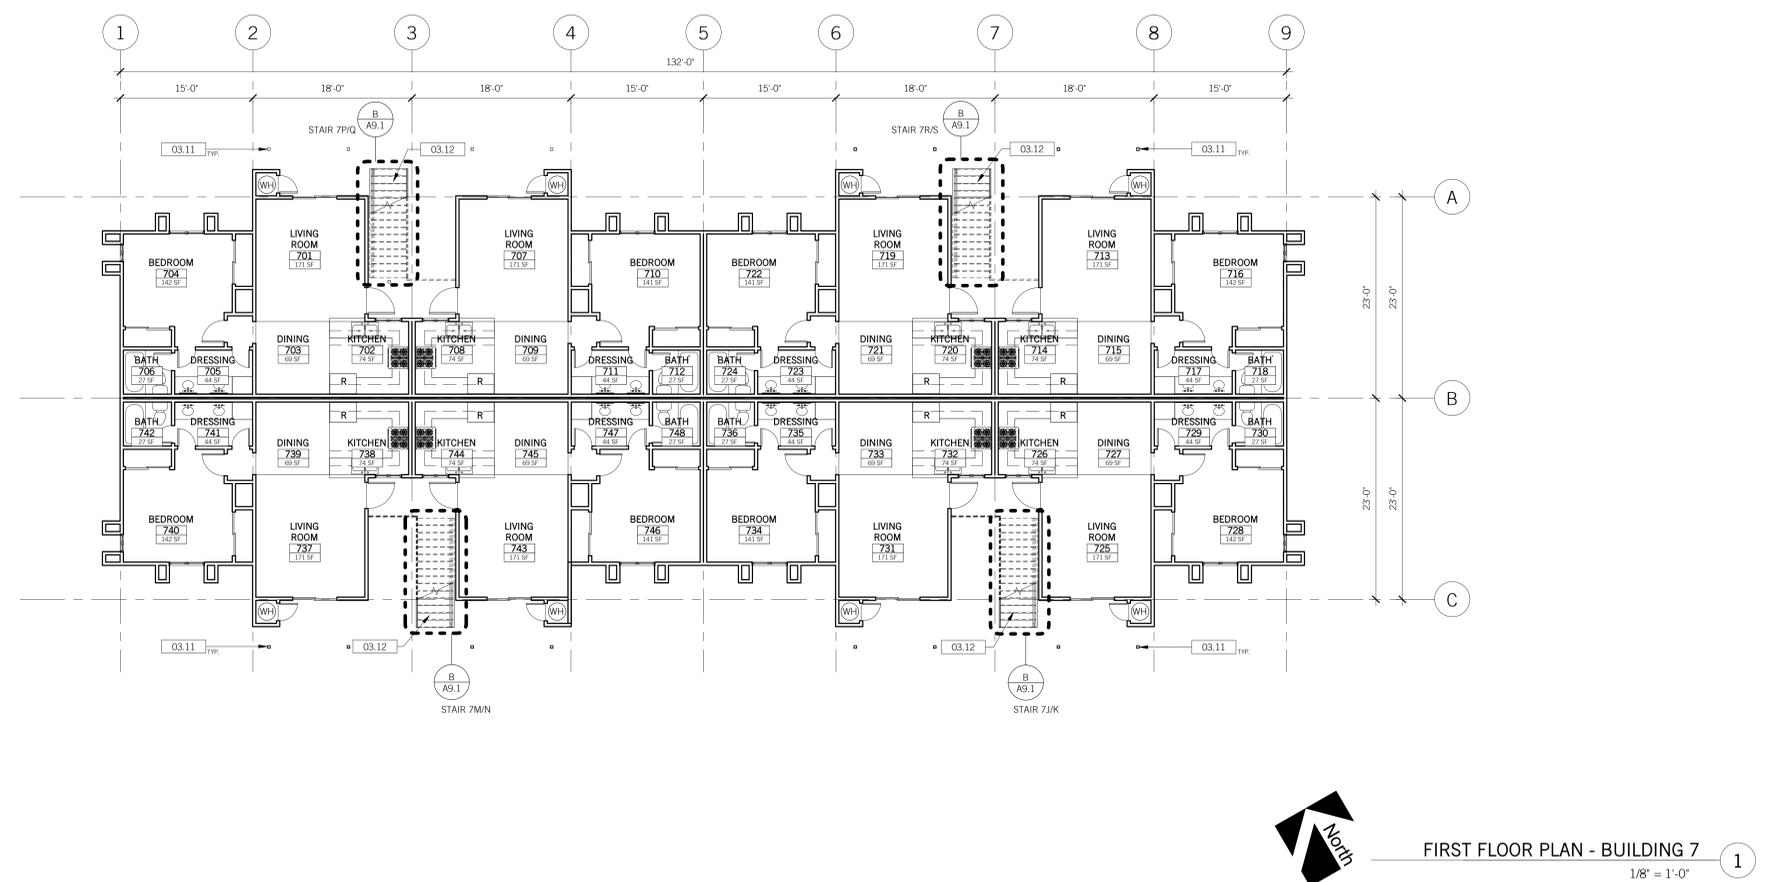

FIRST FLOOR PLAN - BUILDING 7
1/8" = 1'-0" 1

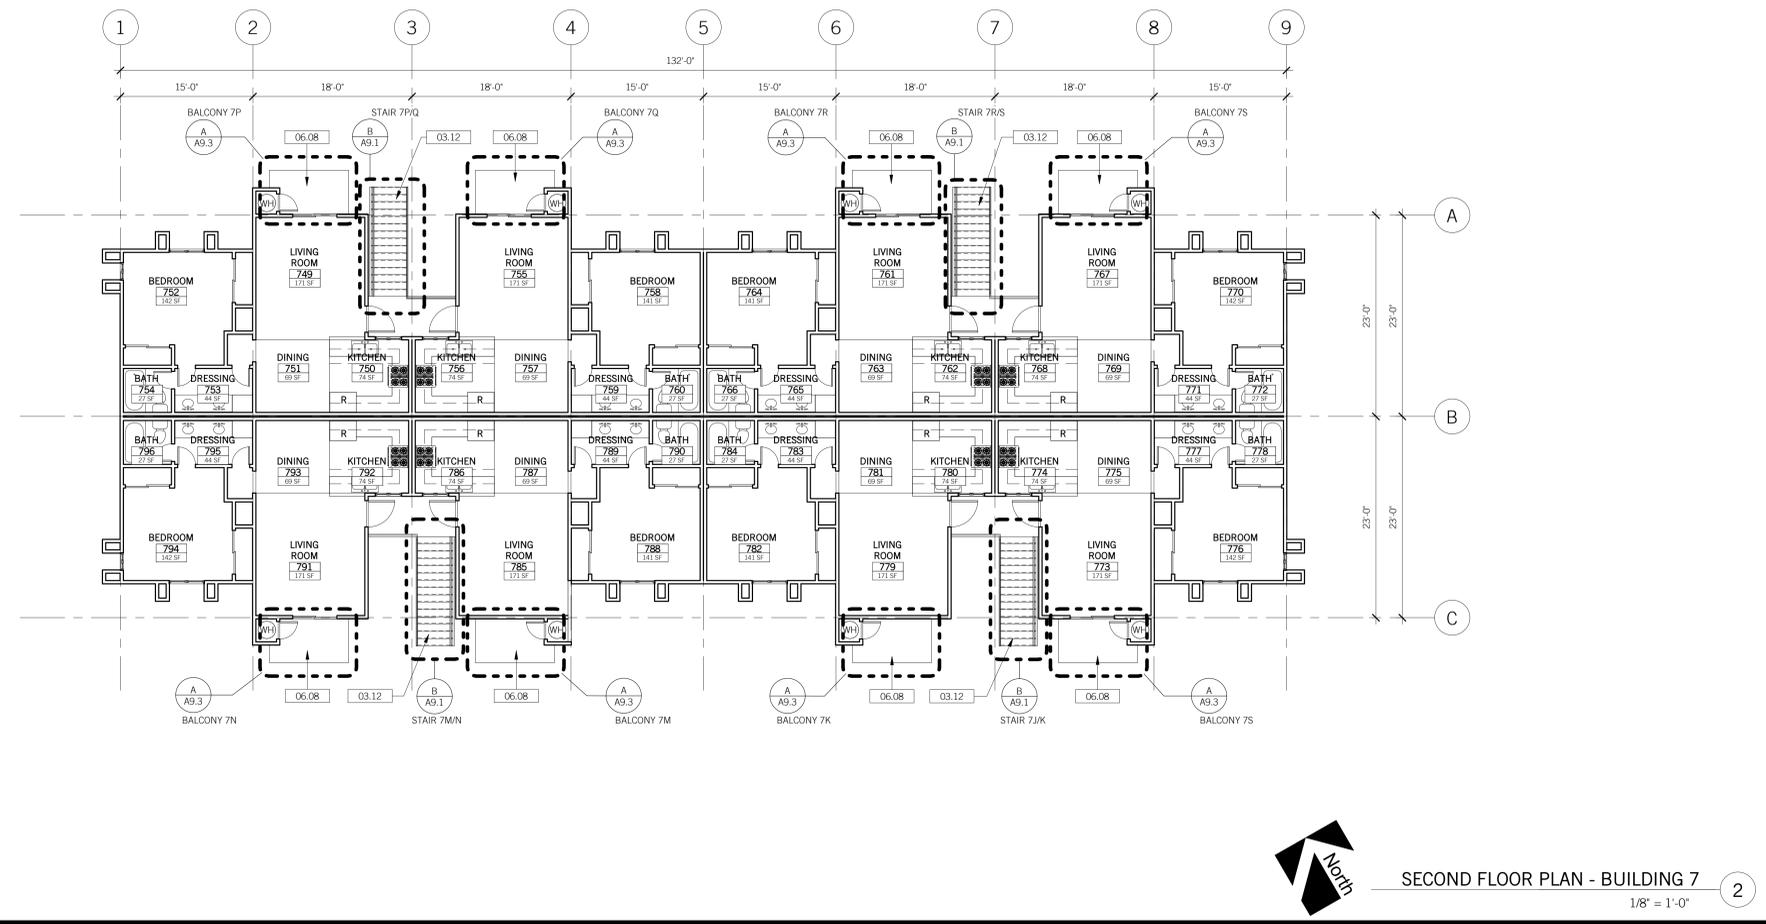

SECOND FLOOR PLAN - BUILDING 7
1/8" = 1'-0" 2

KEYNOTES 00.00

- 03.11 (N) CONCRETE FOOTING AND COLUMN. SEE STRUCTURAL DRAWINGS.
- 03.12 (N) CONCRETE PRECAST STAIR TREADS. SEE STRUCTURAL DRAWINGS.
- 06.08 (N) WOOD BALCONY DECKING. PROVIDE NEW WATER-PROOFING, FLASHING AND DEK-DEX, SLIP-RESISTANT FINISH OVER NEW BALCONY DECKING. SEE STRUCTURAL DRAWINGS.

WALL LEGEND

(E) STUD WALL, PROTECT IN PLACE.

LEGEND

(E) DOOR, FRAME AND ALL HARDWARE, PROTECT IN PLACE.

(E) WINDOWS AND SYSTEMS, PROTECT IN PLACE.

FINISH REPAIR NOTE


1. WHERE EXISTING EXTERIOR/INTERIOR FINISHES HAVE BEEN DISTURBED AS A RESULT OF THE WORK SCOPE REQUIRED HEREIN, THE CONTRACTOR SHALL REPAIR THOSE FINISHES TO MATCH AS CLOSELY AS POSSIBLE, EXISTING ADJACENT FINISH. IN ADDITION, THE CONTRACTOR SHALL PREP, PRIME AND PAINT THE ENTIRE WALL, FLOOR OR CEILING SURFACE, TO THE NEAREST PAINT BREAK. THIS MAY INCLUDE, BUT NOT BE LIMITED TO: INSIDE OR OUTSIDE-WALL CORNERS, WALL TO CEILING OR FLOOR, LEDGER BEAMS, DIFFERENT MATERIALS NOT DISTURBED BY THE WORK, ETC... IT SHALL BE THE BIDDING CONTRACTOR'S RESPONSIBILITY TO REVIEW ALL SCENARIOS AND CONDITIONS, AND WALK THE SITE BEFORE PROVIDING HIS/HER BID.

KEY PLAN

INSPECTIONS REQUIRED
 UC RIVERSIDE
 Office of Planning, Design & Construction
 Signed CBO: Blair S. Bellows
 Building, Safety and Compliance Division
 CAMPUS BUILDING PERMIT
 ALL INFORMATION SUBJECT TO THE 2019 CALIFORNIA BUILDING CODE

APPROVED
 UC RIVERSIDE
 Planning, Design and Construction
 Campus Building Permit
 Signature: [Signature]
 Building & Safety Division
 Campus Building Permit

OFFICE OF THE STATE FIRE MARSHAL
 APPROVED FIRE AND PANIC ONLY
07/02/2019
 Approval of this plan does not authorize or approve any erection or alteration from applicable regulations. Final approval is subject to field inspection. One set of approved plans shall be available on the project site at all times.
 Reviewed by: [Signature]
 Fire and Life Safety Division

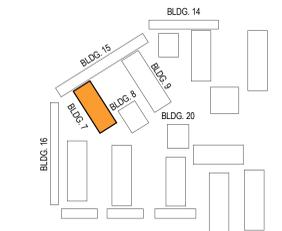

miyamoto.
 LEANED ARCHITECT
 Member A, B, C
 1901 East Alhambra Avenue, Suite 100
 Santa Ana, CA 92705
 T: (949) 570-1770
 mmiyamotointernational.com
 M1904011.00

Formillus
 ARCHITECTURE
 Building relationships. Transforming environments.
 3080 12th Street, Suite 105
 Riverside, California 92507
 O: 951.530.8278
 E: info@formillus.com
 W: formillus.com

UNIVERSITY OF CALIFORNIA, RIVERSIDE
 FALKIRK SITE AND SEISMIC IMPROVEMENTS - SUMMER 2019
 3429 CANYON CREST DRIVE
 RIVERSIDE, CA 92507

REVISIONS

ADDENDUM 1	6/14/19
ADDENDUM 2	6/28/19

UCR PROJECT #: 956390
 UCR CAAN #: P5673
 DATE: 06-28-2019
 DRAWN: LR

BUILDING 7 - FLOOR PLANS



A7-2.2



TYP. STAIR "B" - BLDG 8 3



TYP. STAIR "B" - BLDG 8 4

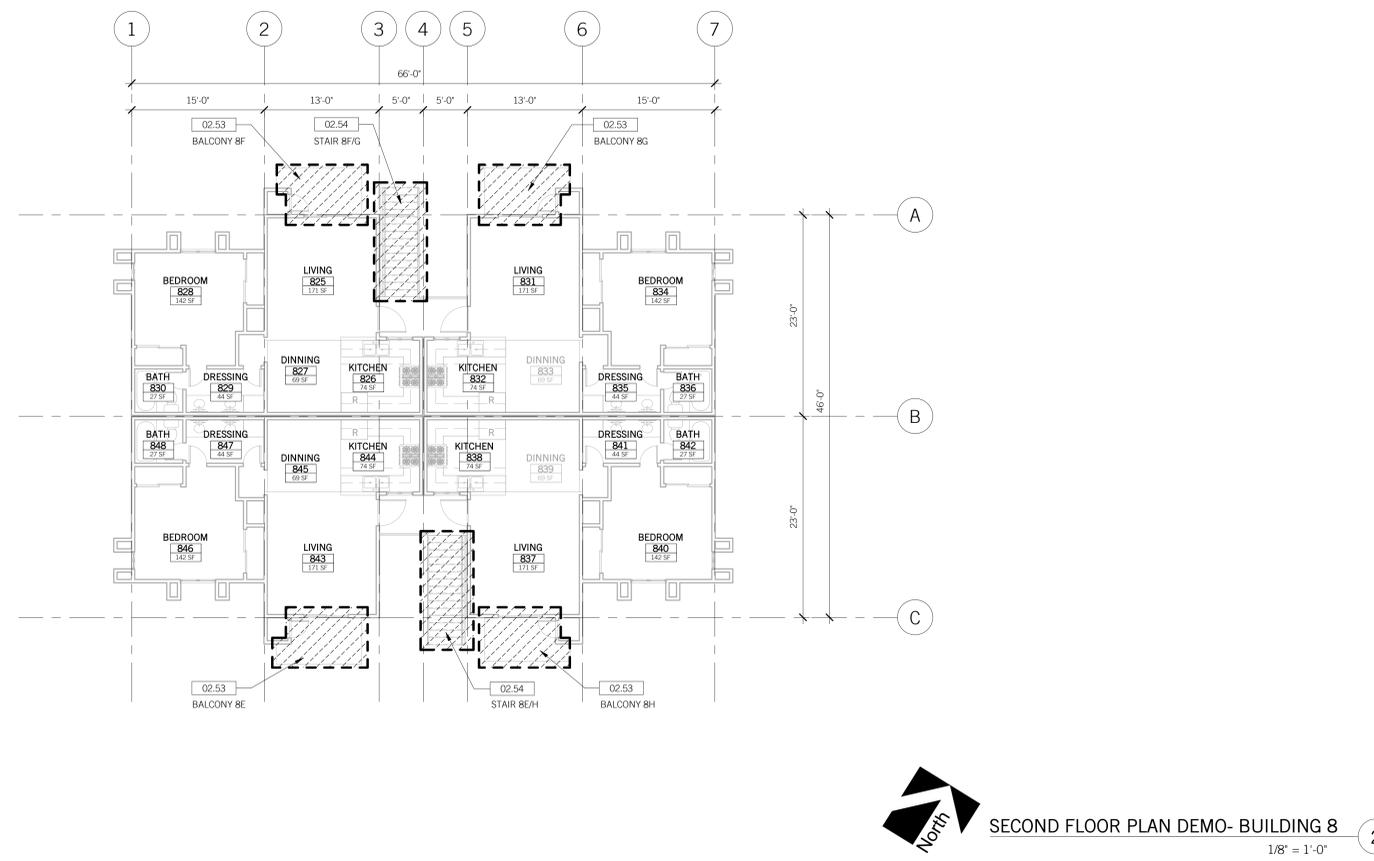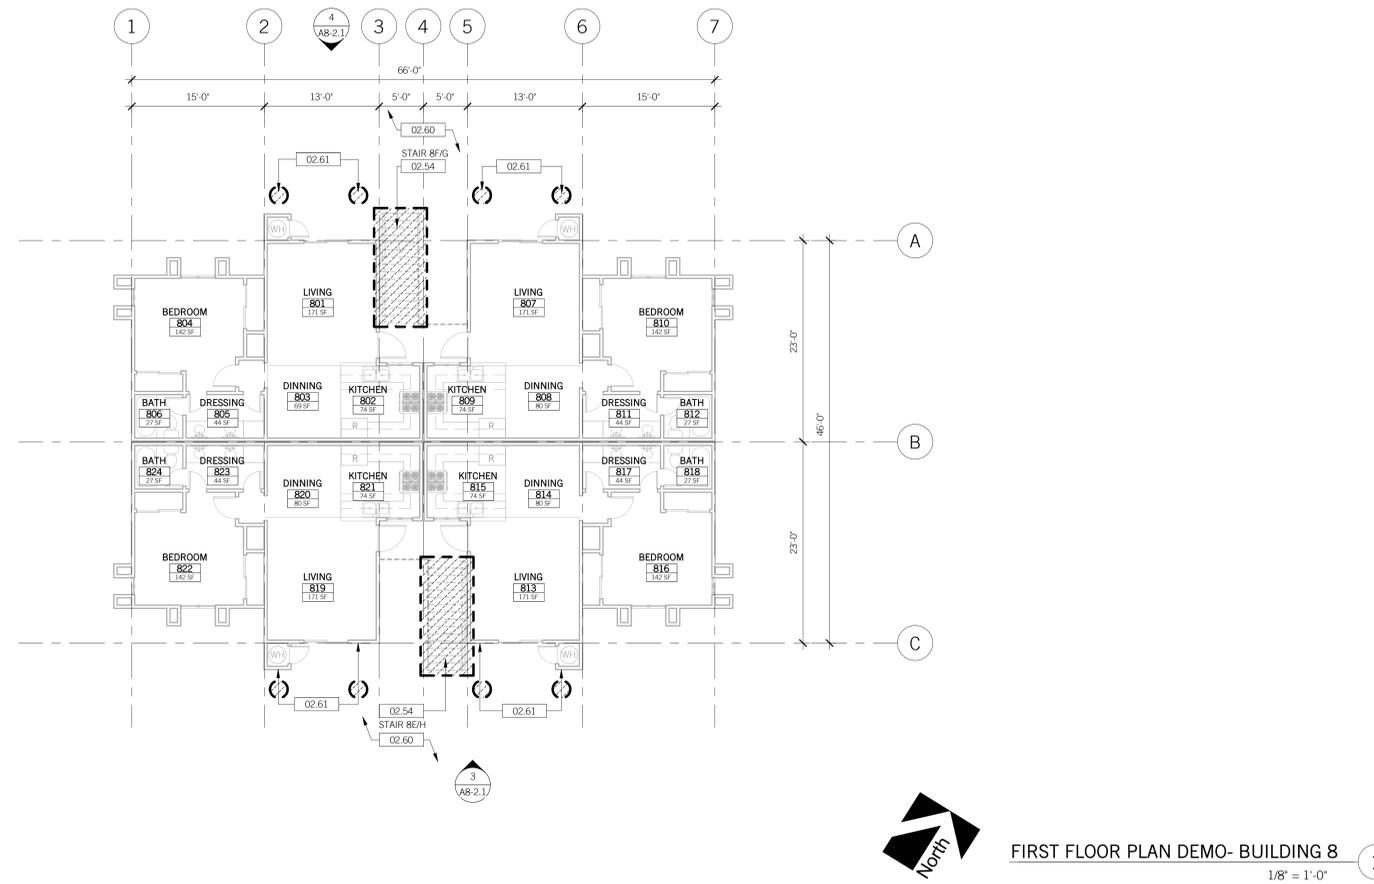

KEYNOTES 00.00

- 02.53 REMOVE (E) WOOD DECK. SEE STRUCTURAL DRAWINGS.
- 02.54 REMOVE (E) STAIRS, (E) FOOTING, (E) STEEL ATTACHMENTS AND WOOD HANDRAILS ATTACHED TO STUCCO AND WOOD SIDING CONDITIONS. DO NOT DEMO ANY SECOND FLOOR LANDING FRAMING OR POSTS. NOTIFY SEOR FOR ANY EXISTING MEMBERS IN QUESTION. PATCH AND REPAIR WALL FINISH AND (E) WALKWAY SLAB AFFECTED BY DEMO WORK TO MATCH EXISTING.
- 02.60 REMOVE AND REROUTE (E) SPRINKLER LINES AS NECESSARY.
- 02.61 REMOVE (E) PAVEMENT AS NECESSARY FOR NEW POST FOOTINGS. SEE STRUCTURAL DRAWINGS.

WALL LEGEND

(E) STUD WALL, PROTECT IN PLACE.

LEGEND

(E) DOOR, FRAME AND ALL HARDWARE, PROTECT IN PLACE.

(E) WINDOWS AND SYSTEMS, PROTECT IN PLACE.

AREA OF DEMOLITION.

miyamoto.
1901 East Alhambra Avenue, Suite 100
Santa Ana, CA 92705
T: (949) 570-1770
myamotointernational.com

LEONARD ARCHITECT
Member A, Ben
1901 East Alhambra Avenue, Suite 100
Santa Ana, CA 92705
T: (949) 570-1770
myamotointernational.com

Formillus
ARCHITECTURE
Building relationships. Transforming environments.
3080 12th Street, Suite 105
Riverside, California 92507
O: 951.530.8278
E: info@formillus.com
W: formillus.com


UNIVERSITY OF CALIFORNIA, RIVERSIDE
FALKIRK SITE AND SEISMIC IMPROVEMENTS - SUMMER 2019
3429 CANYON CREST DRIVE
RIVERSIDE, CA 92507

REVISIONS

ADDENDUM 1	01/19
ADDENDUM 2	02/19

UCR PROJECT #: 956390
UCR CAAN #: P5673
DATE: 06-28-2019
DRAWN: LR

BUILDING 8 - FLOOR PLAN - DEMOLITION A8-2.1

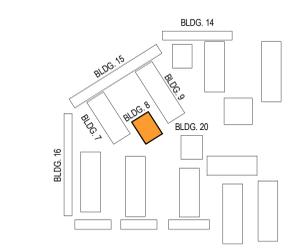


KEY PLAN


INSPECTIONS REQUIRED
UC RIVERSIDE
Office of Planning, Design & Construction
Signed CEO: Blair S. Bellows
Building, Safety and Compliance Division
CAMPUS BUILDING PERMIT
ALL INFORMATION IS TO BE KEPT CONFIDENTIAL

APPROVED
UC RIVERSIDE
Office of Planning, Design & Construction
Signed: Blair S. Bellows
Building & Safety Division
Campus Building Permit

OFFICE OF THE STATE FIRE MARSHAL
APPROVED FIRE AND PANIC ONLY
07/02/2019
Approval of this plan does not authorize or approve any emission or deviation from applicable regulations. Final approval is subject to field inspection. One set of approved plans shall be available on the project site at all times.
Reviewed by: *Heath Johnson*
Fire and Life Safety Division

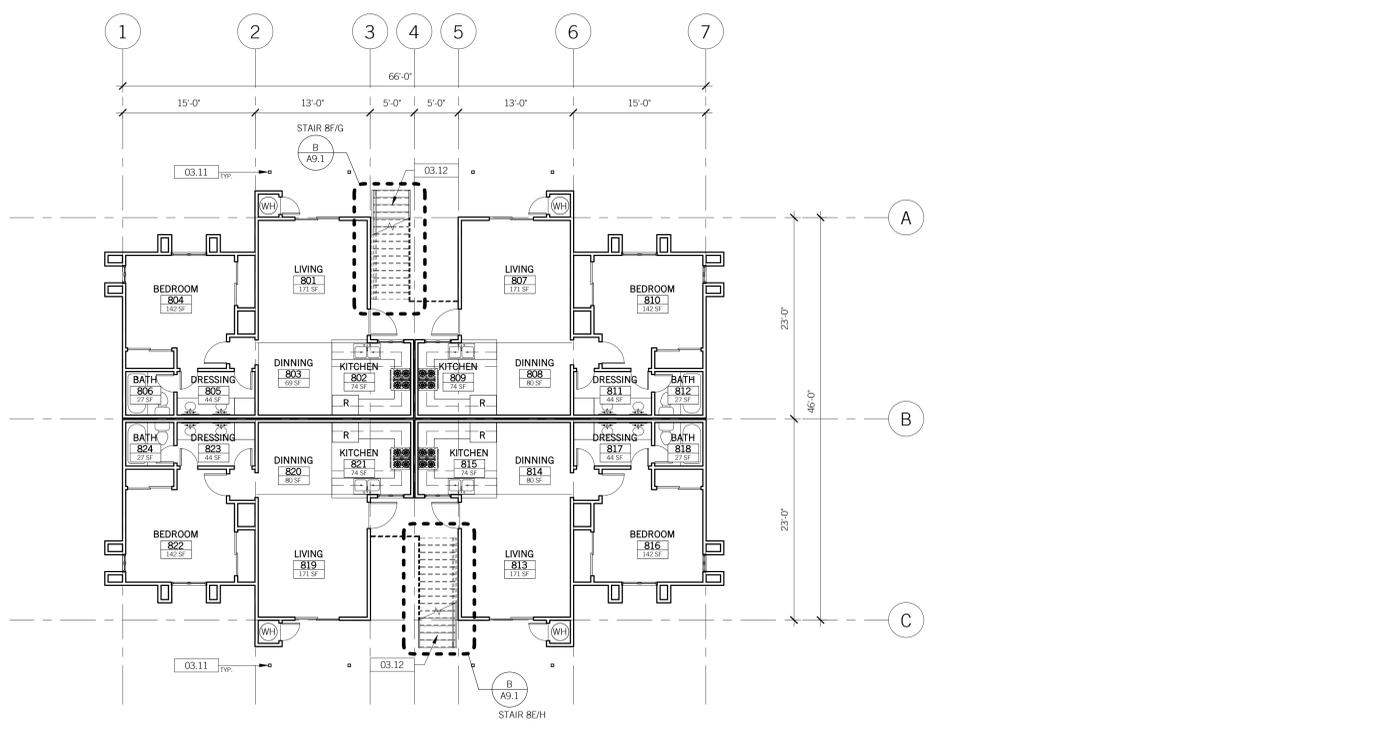

FIRST FLOOR PLAN - BUILDING 8
1/8" = 1'-0" 1

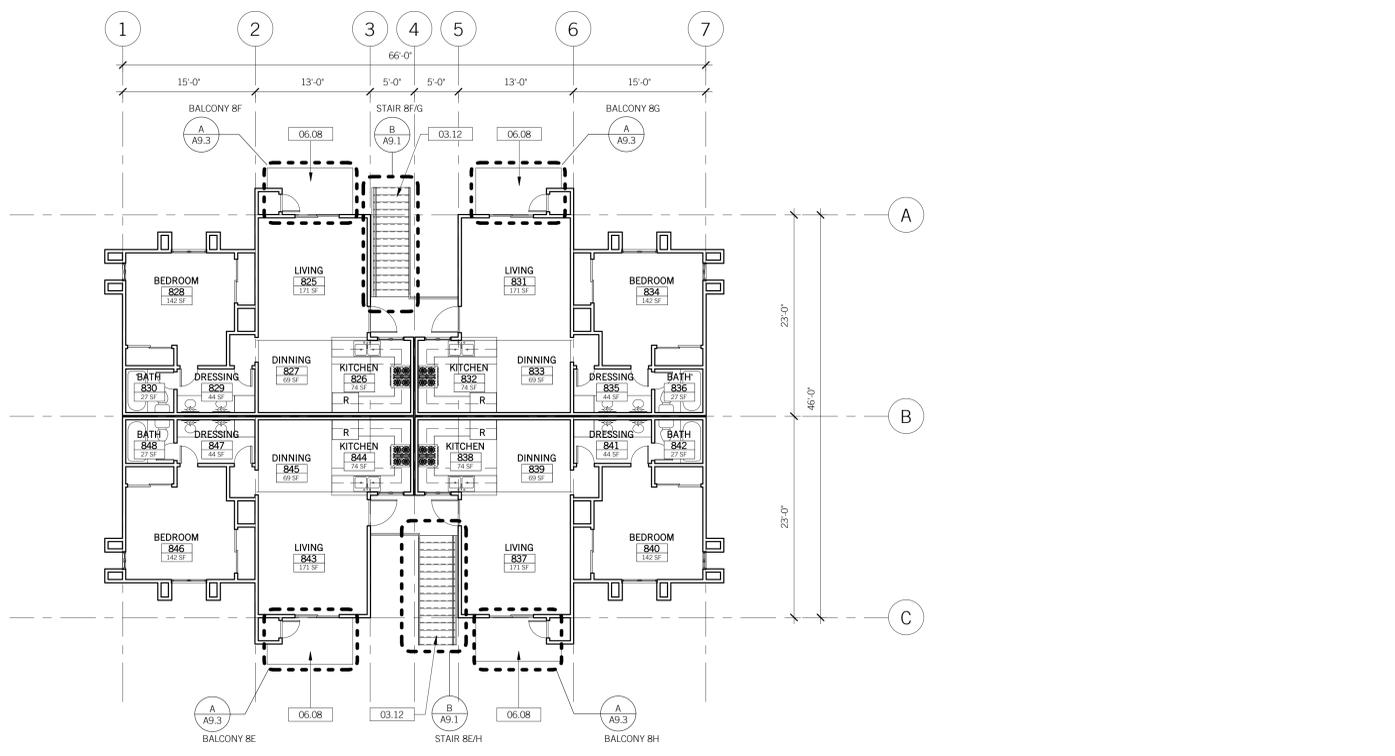

SECOND FLOOR PLAN - BUILDING 8
1/8" = 1'-0" 2

KEYNOTES 00.00

- 03.11 (N) CONCRETE FOOTING AND COLUMN. SEE STRUCTURAL DRAWINGS.
- 03.12 (N) CONCRETE PRECAST STAIR TREADS. SEE STRUCTURAL DRAWINGS.
- 06.08 (N) WOOD BALCONY DECKING. PROVIDE NEW WATER-PROOFING, FLASHING AND DEK-DEK-TEX, SLIP-RESISTANT FINISH OVER NEW BALCONY DECKING. SEE STRUCTURAL DRAWINGS.

WALL LEGEND

(E) STUD WALL, PROTECT IN PLACE.

LEGEND

(E) DOOR, FRAME AND ALL HARDWARE, PROTECT IN PLACE.

(E) WINDOWS AND SYSTEMS, PROTECT IN PLACE.

FINISH REPAIR NOTE

1. WHERE EXISTING EXTERIOR/INTERIOR FINISHES HAVE BEEN DISTURBED AS A RESULT OF THE WORK SCOPE REQUIRED HEREIN, THE CONTRACTOR SHALL REPAIR THOSE FINISHES TO MATCH AS CLOSELY AS POSSIBLE, EXISTING ADJACENT FINISH. IN ADDITION, THE CONTRACTOR SHALL PREP, PRIME AND PAINT THE ENTIRE WALL, FLOOR OR CEILING SURFACE, TO THE NEAREST PAINT BREAK. THIS MAY INCLUDE, BUT NOT BE LIMITED TO, INSIDE OR OUTSIDE WALL CORNERS, WALL TO CEILING OR FLOOR, LEDGER BEAMS, DIFFERENT MATERIALS NOT DISTURBED BY THE WORK, ETC.. IT SHALL BE THE BIDDING CONTRACTOR'S RESPONSIBILITY TO REVIEW ALL SCENARIOS AND CONDITIONS, AND WALK THE SITE BEFORE PROVIDING HIS/HER BID.

miyamoto.
1901 East Alhambra Avenue, Suite 100
Santa Ana, CA 92705
T: (949) 579-1770
miyamotointernational.com

LEBBEED ARCHITECT
Member A, Ben
1901 East Alhambra Avenue, Suite 100
Santa Ana, CA 92705
T: (949) 579-1770
miyamotointernational.com

3080 12th Street, Suite 105
Riverside, California 92507
O: 951.530.8278
E: info@formillus.com
W: formillus.com

Formillus
ARCHITECTURE
Building relationships. Transforming environments.


UNIVERSITY OF CALIFORNIA, RIVERSIDE
FALKIRK SITE AND SEISMIC IMPROVEMENTS - SUMMER 2019
3429 CANYON CREST DRIVE
RIVERSIDE, CA 92507

REVISIONS

ADDENDUM 1	01/18
ADDENDUM 2	02/18

UCR PROJECT #: 956390
UCR CAAN #: P5673
DATE: 06-28-2019
DRAWN: LR

BUILDING 8 - FLOOR PLANS
A8-2.2

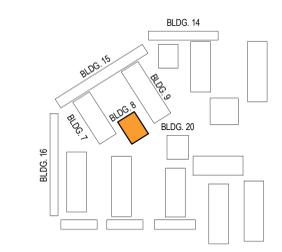

KEY PLAN

INSPECTIONS REQUIRED
UC RIVERSIDE
Office of Planning, Design & Construction
Signed CEO: Blair S. Reiter
Building, Safety and Compliance Division
CAMPUS BUILDING PERMIT
ALL WORK SHALL BE IN ACCORDANCE WITH THE CALIFORNIA PERMITS

APPROVED
UC RIVERSIDE
Planning, Design and Construction
Campus Building Permit
Signature: [Signature]
Building & Safety Division
Campus Building Permit

OFFICE OF THE STATE FIRE MARSHAL
APPROVED FIRE AND PANIC ONLY
07/02/2019
Approval of this plan does not authorize or approve any emission or deviation from applicable regulations. Final approval is subject to field inspection. One set of approved plans shall be available on the project site at all times.
Reviewed by: [Signature]
Fire and Life Safety Division

REVISIONS		
△	ADDENDUM 1	01/19
△	ADDENDUM 2	02/19

UCR PROJECT #: 956390
UCR CAAN #: P5673
DATE: 06-28-2019
DRAWN: LR

BUILDING 14 - FLOOR PLAN - DEMOLITION A14-2.1

KEYNOTES 00.00

- 02.01 (E) STAIRS TO REMAIN, PROTECT IN PLACE.
- 02.02 (E) COLUMN, PROTECT IN PLACE.
- 02.03 (E) CONCRETE PAVING, PROTECT IN PLACE.
- 02.04 (E) ASPHALTIC PAVING, PROTECT IN PLACE.
- 02.51 REMOVE (E) WOOD EYEBROW AND ALL FASTENERS. USE WEATHER-RESISTANT, PAINTABLE WOOD FILLER TO PATCH HOLES.
- 02.52 REMOVE (E) POT SHELF AND ALL FASTENERS. USE WEATHER-RESISTANT, PAINTABLE WOOD FILLER TO PATCH HOLES.
- 02.55 SAWCUT AND REMOVE (E) CONCRETE SLAB AS REQUIRED FOR NEW FOOTINGS. SEE STRUCTURAL DRAWINGS.
- 02.56 REMOVE (E) GYPSUM BOARD AND/OR WALL FINISH 12" MIN. BEYOND WORK OR TO CLOSEST CONTROL JOINT TO ALLOW FOR INSTALLATION OF NEW STRUCTURAL WORK. SEE STRUCTURAL DRAWINGS.

WALL LEGEND


(E) STUD WALL, PROTECT IN PLACE.

LEGEND


(E) DOOR, FRAME AND ALL HARDWARE, PROTECT IN PLACE.

(E) WINDOWS AND SYSTEMS, PROTECT IN PLACE.

AREA OF DEMOLITION.

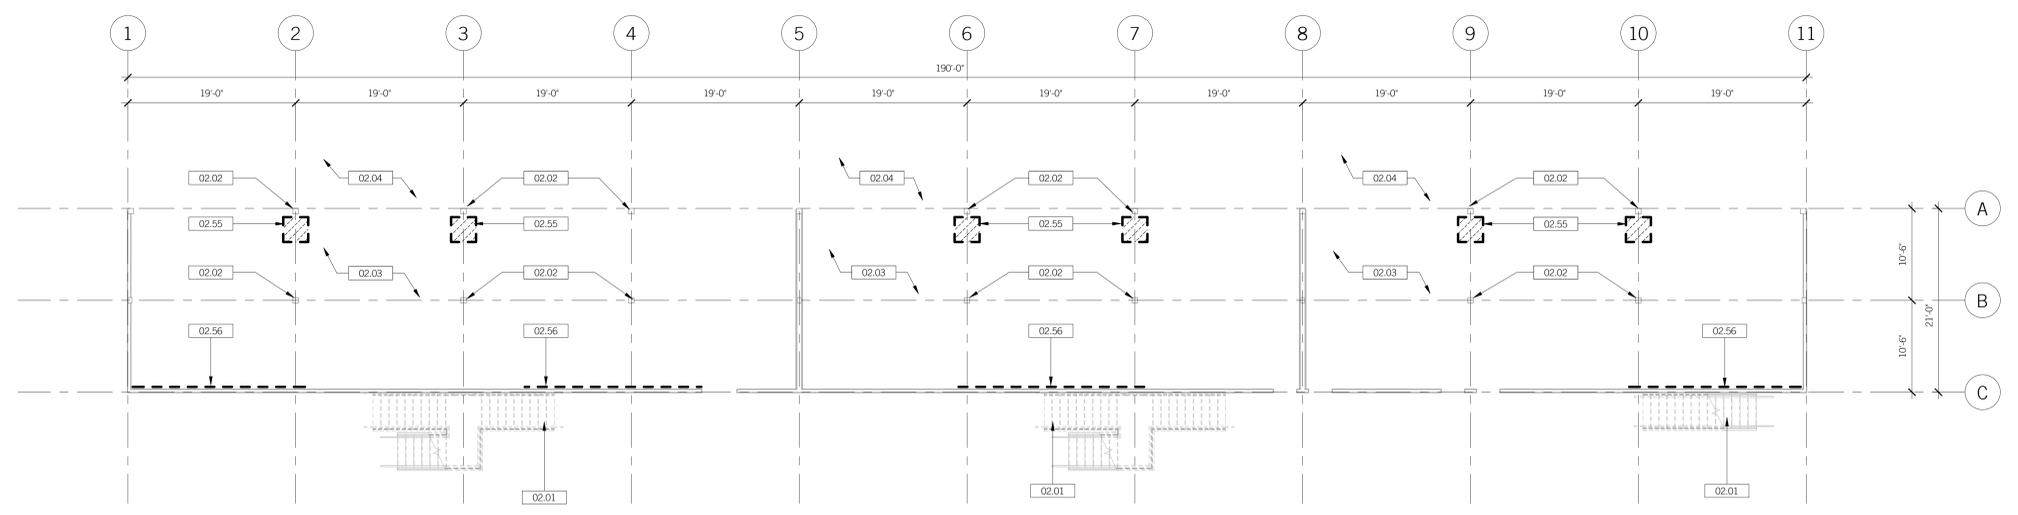

North
FIRST FLOOR PLAN DEMO - BUILDING 14
1/8" = 1'-0"

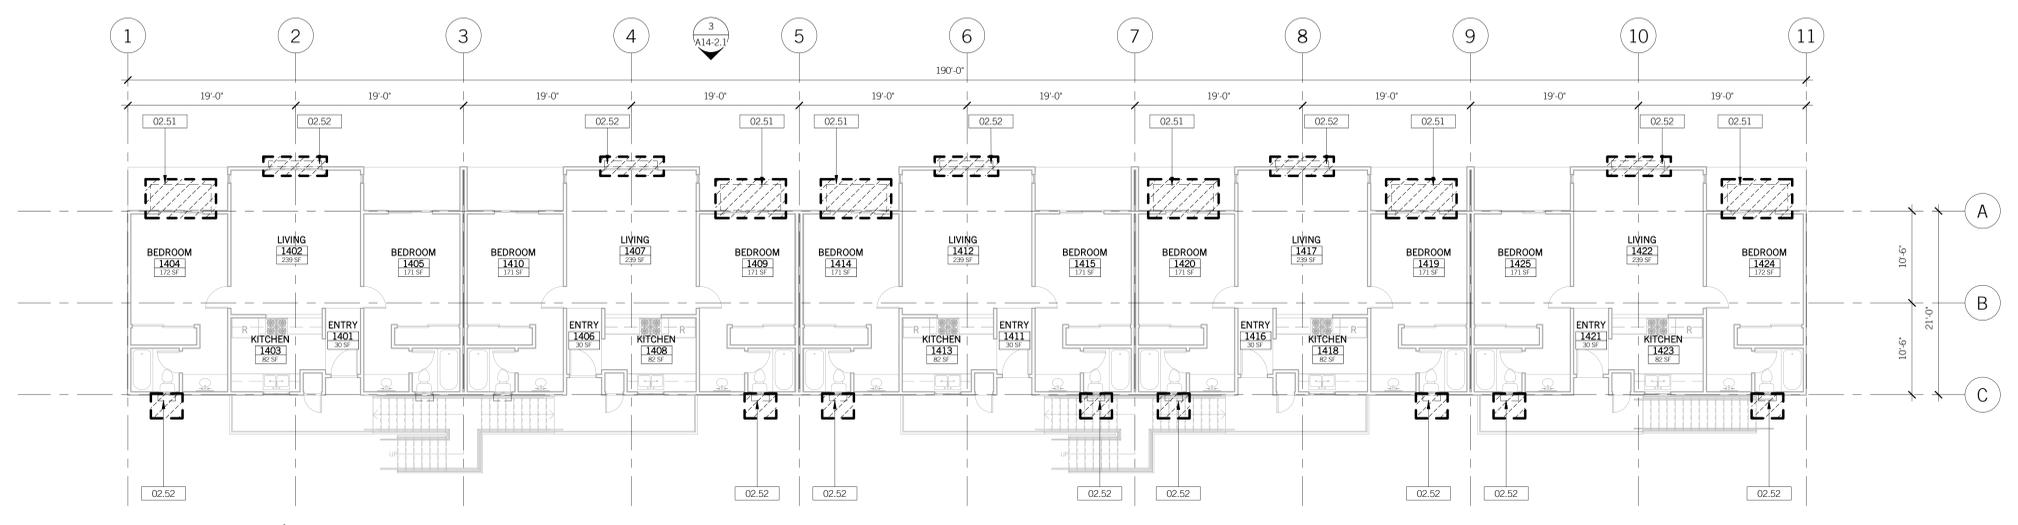


North
SECOND FLOOR PLAN DEMO - BUILDING 14
1/8" = 1'-0"



ROOF EYEBROW & POT SHELF
12" = 1'-0"



TYP. ROOF EYEBROW & POT SHELF

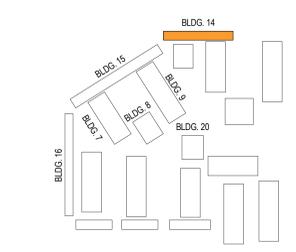

KEY PLAN

INSPECTIONS REQUIRED
UCR RIVERSIDE
Office of Planning, Design & Construction
Signed CEO: Blair S. Bell
Building, Safety and Compliance Division
CAMPUS BUILDING PERMIT
ALL WORK SHALL BE IN ACCORDANCE WITH THE CALIFORNIA PERMITS

APPROVED
UCR Riverside
Planning, Design and Construction
Campus Building Division
Signature: [Signature]
Building & Safety Division
Campus Building Permit

OFFICE OF THE STATE FIRE MARSHAL
APPROVED FIRE AND PANIC ONLY
07/02/2019
Approval of this plan does not authorize or approve any erection or deviation from applicable regulations. Final approval is subject to field inspection. One set of approved plans shall be available on the project site at all times.
Reviewed by: [Signature]
Fire and Life Safety Division

REVISIONS	DATE
ADDENDUM 1	07/19/19
ADDENDUM 2	02/28/19

UCR PROJECT #: 956390
UCR CAAN #: P5673
DATE: 06-28-2019
DRAWN: LR

BUILDING 14 - FLOOR PLANS

A14-2.2

KEYNOTES 00.00

- 02.01 (E) STAIRS TO REMAIN, PROTECT IN PLACE.
- 02.03 (E) CONCRETE PAVING, PROTECT IN PLACE.
- 02.04 (E) ASPHALTIC PAVING, PROTECT IN PLACE.
- 03.10 (N) CONCRETE FOOTINGS FOR STRUCTURAL COLUMN REPAIR WORK. PATCH TO MATCH (E) CONC. SLOPES. SEE: STRUCTURAL DRAWINGS.
- 05.01 ALL EXPOSED COLUMN AND BRACING TO RECEIVE INTUMESCENT PAINT. ARCHITECT TO SELECT COLOR. SEE: STRUCTURAL DRAWINGS.
- 06.06 (N) SIMPSON "HOLDOWN" PER PLAN. SEE: STRUCTURAL DRAWINGS.
- 06.09 (N) PLYWOOD SHEAR PANEL. REPAIR & PAINT TO MATCH (E) ADJACENT WALL SURFACE. SEE: STRUCTURAL DRAWINGS.

WALL LEGEND

(E) STUD WALL, PROTECT IN PLACE.

LEGEND

(E) DOOR, FRAME AND ALL HARDWARE, PROTECT IN PLACE.


(E) WINDOWS AND SYSTEMS, PROTECT IN PLACE.

FINISH REPAIR NOTE


1. WHERE EXISTING EXTERIOR/INTERIOR FINISHES HAVE BEEN DISTURBED AS A RESULT OF THE WORK SCOPE REQUIRED HEREIN, THE CONTRACTOR SHALL REPAIR THOSE FINISHES TO MATCH AS CLOSELY AS POSSIBLE EXISTING ADJACENT FINISH. IN ADDITION, THE CONTRACTOR SHALL PREP, PRIME AND PAINT THE ENTIRE WALL, FLOOR OR CEILING SURFACE, TO THE NEAREST PAINT BREAK. THIS MAY INCLUDE, BUT NOT BE LIMITED TO; INSIDE OR OUTSIDE WALL CORNERS, WALL TO CEILING OR FLOOR, LEDGER BEAMS, DIFFERENT MATERIALS NOT DISTURBED BY THE WORK, ETC. IT SHALL BE THE BIDDING CONTRACTOR'S RESPONSIBILITY TO REVIEW ALL SCENARIOS AND CONDITIONS, AND WALK THE SITE BEFORE PROVIDING HIS/HER BID.

FIRE FINISH NOTE:

1. ALL BUILDING STRUCTURAL STEEL FRAME WITHIN GARAGE SPACE TO BE COATED WITH INTUMESCENT PAINT TO ACHIEVE 1-HR FIRE RATING.

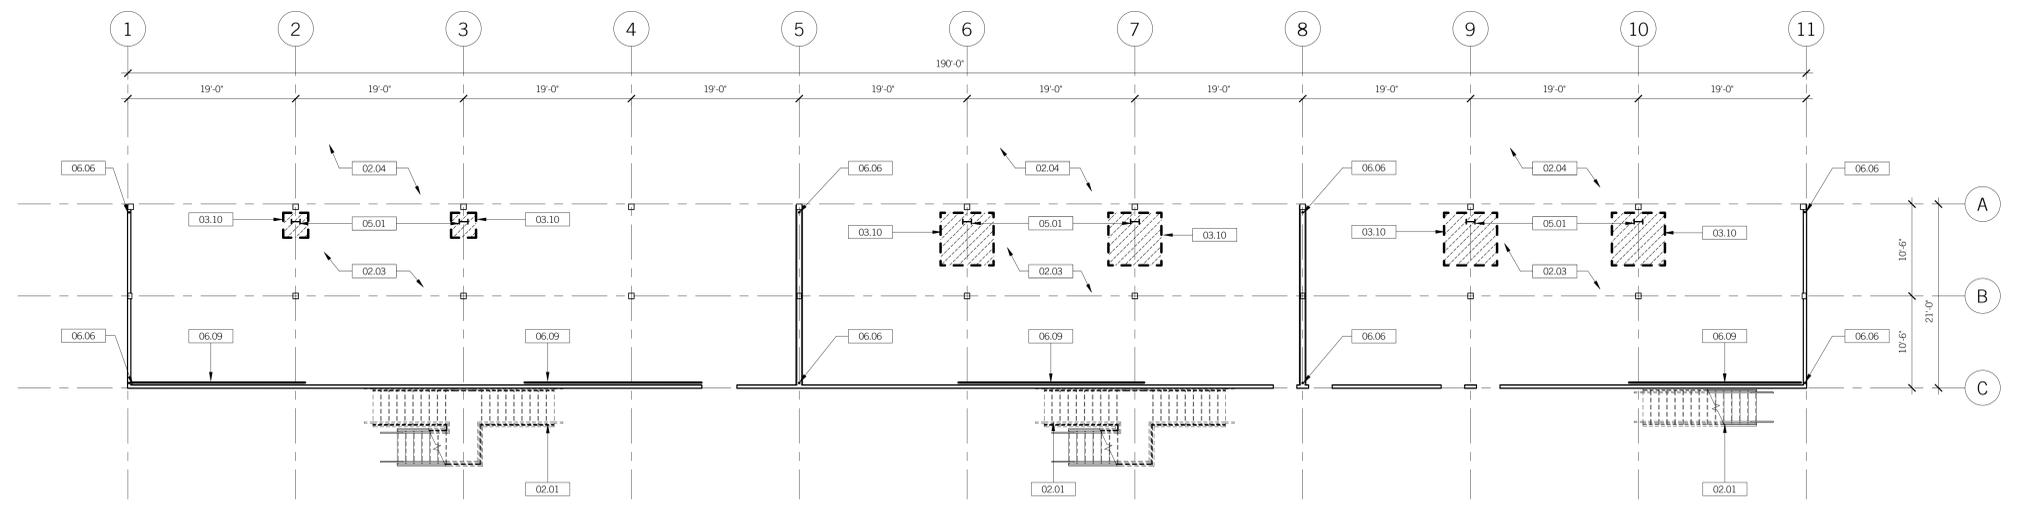

FIRST FLOOR PLAN - BUILDING 14
1/8" = 1'-0"

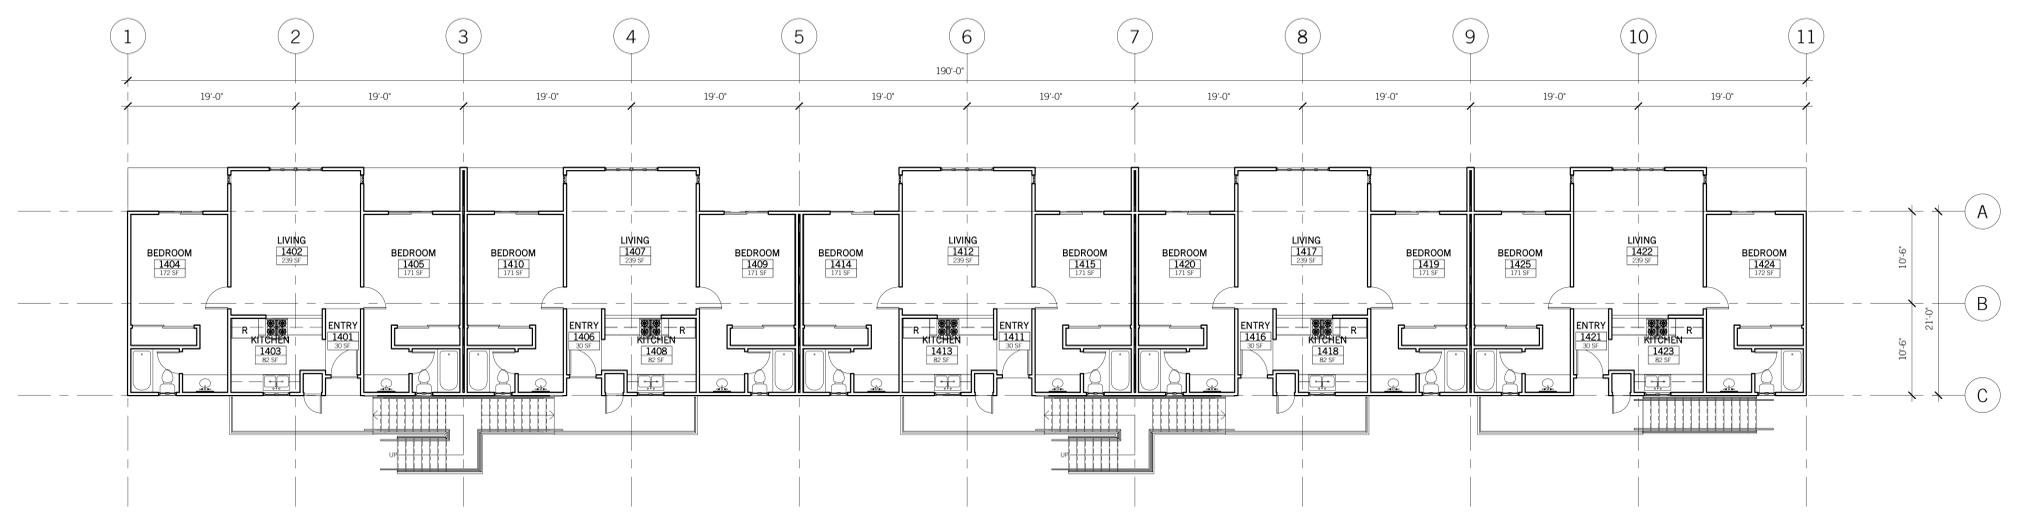

SECOND FLOOR PLAN - BUILDING 14
1/8" = 1'-0"

KEY PLAN

INSPECTIONS REQUIRED
UCR RIVERSIDE
Office of Planning, Design & Construction
Signed CEO: Blair S. Bellows
Building & Safety Division
CAMPUS BUILDING PERMIT
ALL WORK SHALL BE SUBJECT TO THE 2019 CALIFORNIA FIRE AND LIFE SAFETY CODE

APPROVED
UCR RIVERSIDE
Planning, Design & Construction
Campus Building Permit
Signature: Blair S. Bellows
Building & Safety Division
Campus Building Permit

OFFICE OF THE STATE FIRE MARSHAL
APPROVED FIRE AND PANIC ONLY
07/02/2019
Approval of this plan does not authorize or approve any omission or deviation from applicable regulations. Final approval is subject to field inspection. One set of approved plans shall be available on the project site at all times.
Reviewed by: [Signature]




PLOTTED BY: LR
PLOT DATE: 6/28/2019 8:53:27 AM

REVISIONS

ADDENDUM 1	01/18
ADDENDUM 2	02/18

UCR PROJECT #: 956390
UCR CAAN #: P5673
DATE: 06-28-2019
DRAWN: LR

BUILDING 15 - FLOOR PLAN DEMOLITION A15-2.1

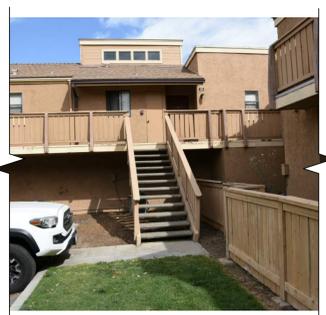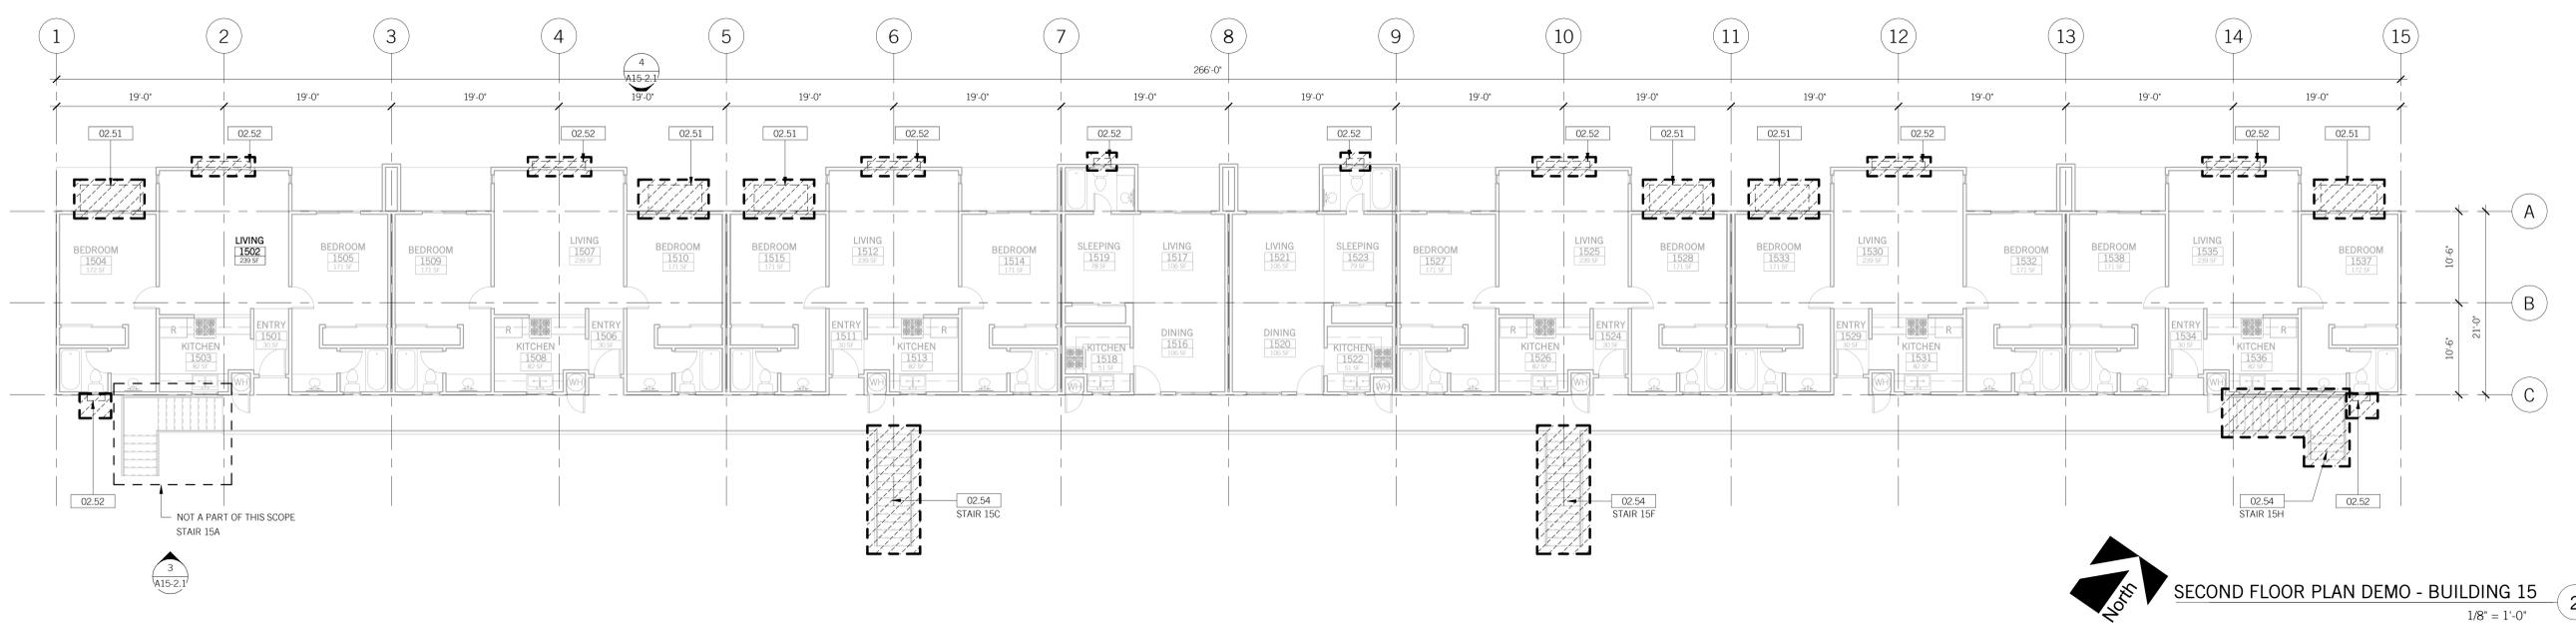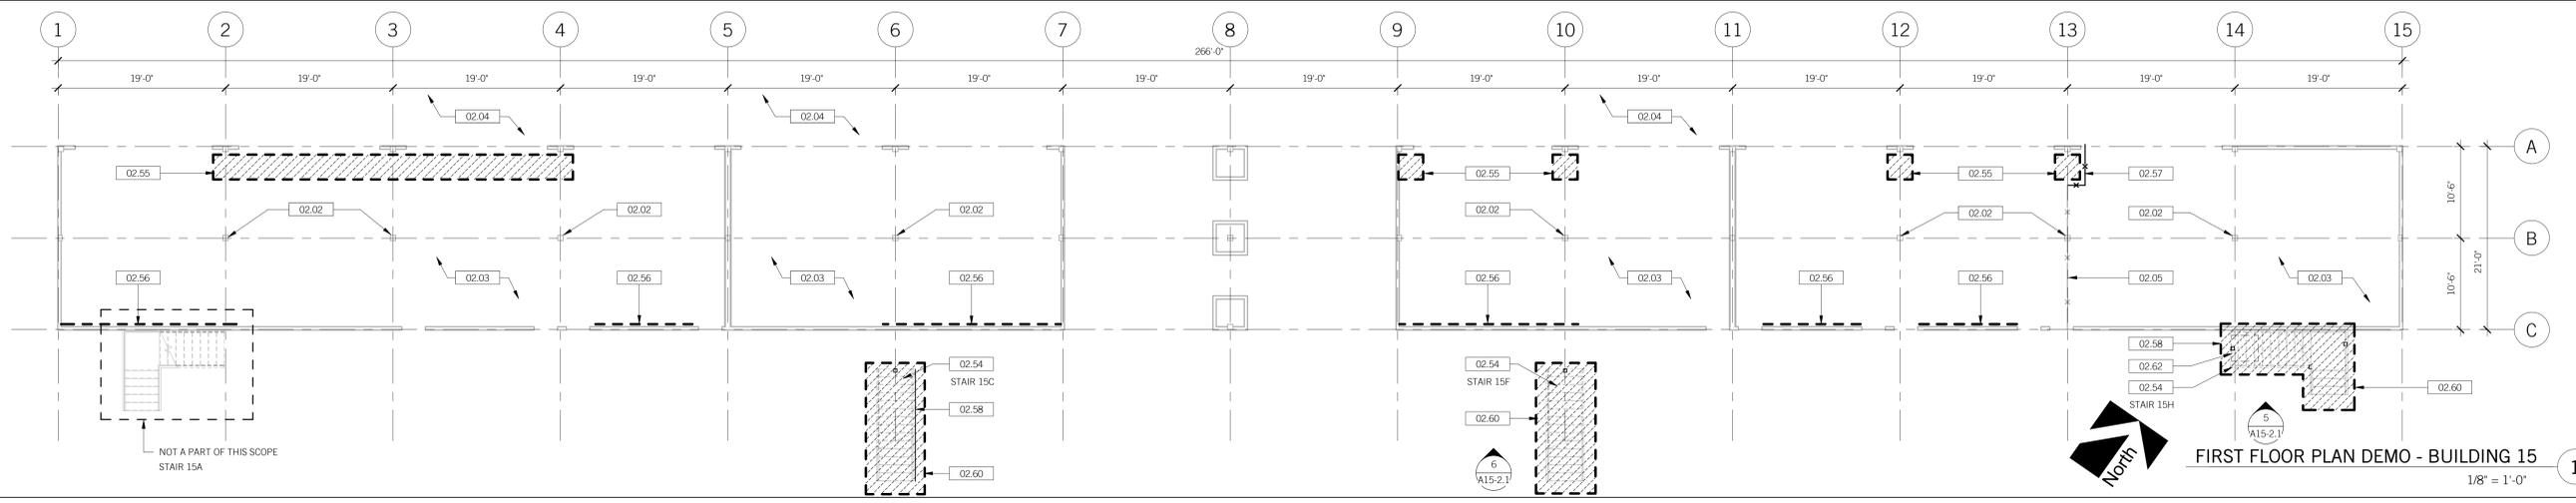

TYP. STAIR "C" - BLDG 15
12" = 1'-0"



TYP. STAIR "A" - BLDG 15
12" = 1'-0"



TYP. ROOF EYEBROW & POT SHELF




ROOF EYEBROW & POT SHELF

KEYNOTES

02.02	(E) COLUMN, PROTECT IN PLACE.
02.03	(E) CONCRETE PAVING, PROTECT IN PLACE.
02.04	(E) ASPHALTIC PAVING, PROTECT IN PLACE.
02.05	(E) CHAIN LINK FENCE, PROTECT IN PLACE.
02.51	REMOVE (E) WOOD EYEBROW AND ALL FASTENERS. USE WEATHER-RESISTANT, PAINTABLE WOOD FILLER TO PATCH HOLES.
02.52	REMOVE (E) POT SHELF AND ALL FASTENERS. USE WEATHER-RESISTANT, PAINTABLE WOOD FILLER TO PATCH HOLES.
02.54	REMOVE (E) STAIRS, (E) FOOTING, (E) STEEL ATTACHMENTS AND WOOD HANDRAILS ATTACHED TO STUCCO AND WOOD SIDING CONDITIONS. DO NOT DEMO ANY SECOND FLOOR LANDING FRAMING OR POSTS. NOTIFY SCOR FOR ANY EXISTING MEMBERS IN QUESTION. PATCH AND REPAIR WALL FINISH AND (E) WALKWAY SLAB AFFECTED BY DEMO WORK TO MATCH EXISTING.
02.55	SAWCUT AND REMOVE (E) CONCRETE SLAB AS REQUIRED FOR NEW FOOTINGS. SEE STRUCTURAL DRAWINGS.
02.56	REMOVE (E) GYPSUM BOARD AND/OR WALL FINISH 12" MIN. BEYOND WORK OR TO CLOSEST CONTROL JOINT TO ALLOW FOR INSTALLATION OF NEW STRUCTURAL WORK. SEE STRUCTURAL DRAWINGS.
02.57	REMOVE END OF CHAIN LINK FENCE AND REBUILD/REPLACE AFTER MANUFACTURER INSTALLATION.
02.58	REMOVE AND REPLACE ELECTRICAL CONDUIT ON EXISTING STAIR.
02.60	REMOVE AND REROUTE (E) SPRINKLER LINES AS NECESSARY.
02.62	REMOVE (E) AC UNIT AND ACCESSORY PARTS ASSOCIATED WITH REPLACEMENT. SEE ELECTRICAL DRAWINGS.

WALL LEGEND

(Symbol)	(E) WINDOWS AND SYSTEMS, PROTECT IN PLACE.
(Symbol)	AREA OF DEMOLITION.

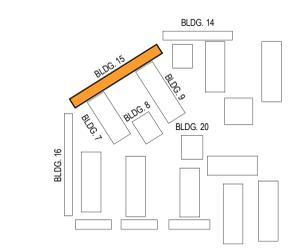


KEY PLAN
INSPECTIONS REQUIRED
UCR RIVERSIDE
Office of Planning, Design & Construction
Signed: CBO, Blair S. Bellows
Building, Safety and Compliance Division
CAMPUS BUILDING PERMIT
ALL WORK SHALL BE PERFORMED TO UCR'S OFFICIAL PERMITS


APPROVED
UCR RIVERSIDE
Planning, Design & Construction
Campus Building Division
Signature: [Signature]
Building & Safety Division
Campus Building Permit

OFFICE OF THE STATE FIRE MARSHAL
APPROVED FIRE AND PANIC ONLY
07/02/2019
Approval of this plan does not authorize or approve any emission or deviation from applicable regulations. Final approval is subject to final inspection. One set of approved plans shall be available on the project site at all times.
Reviewed by: [Signature]
Fire and Life Safety Division

PLotted BY: LR
PLOT DATE: 6/28/2019 12:43:57 PM

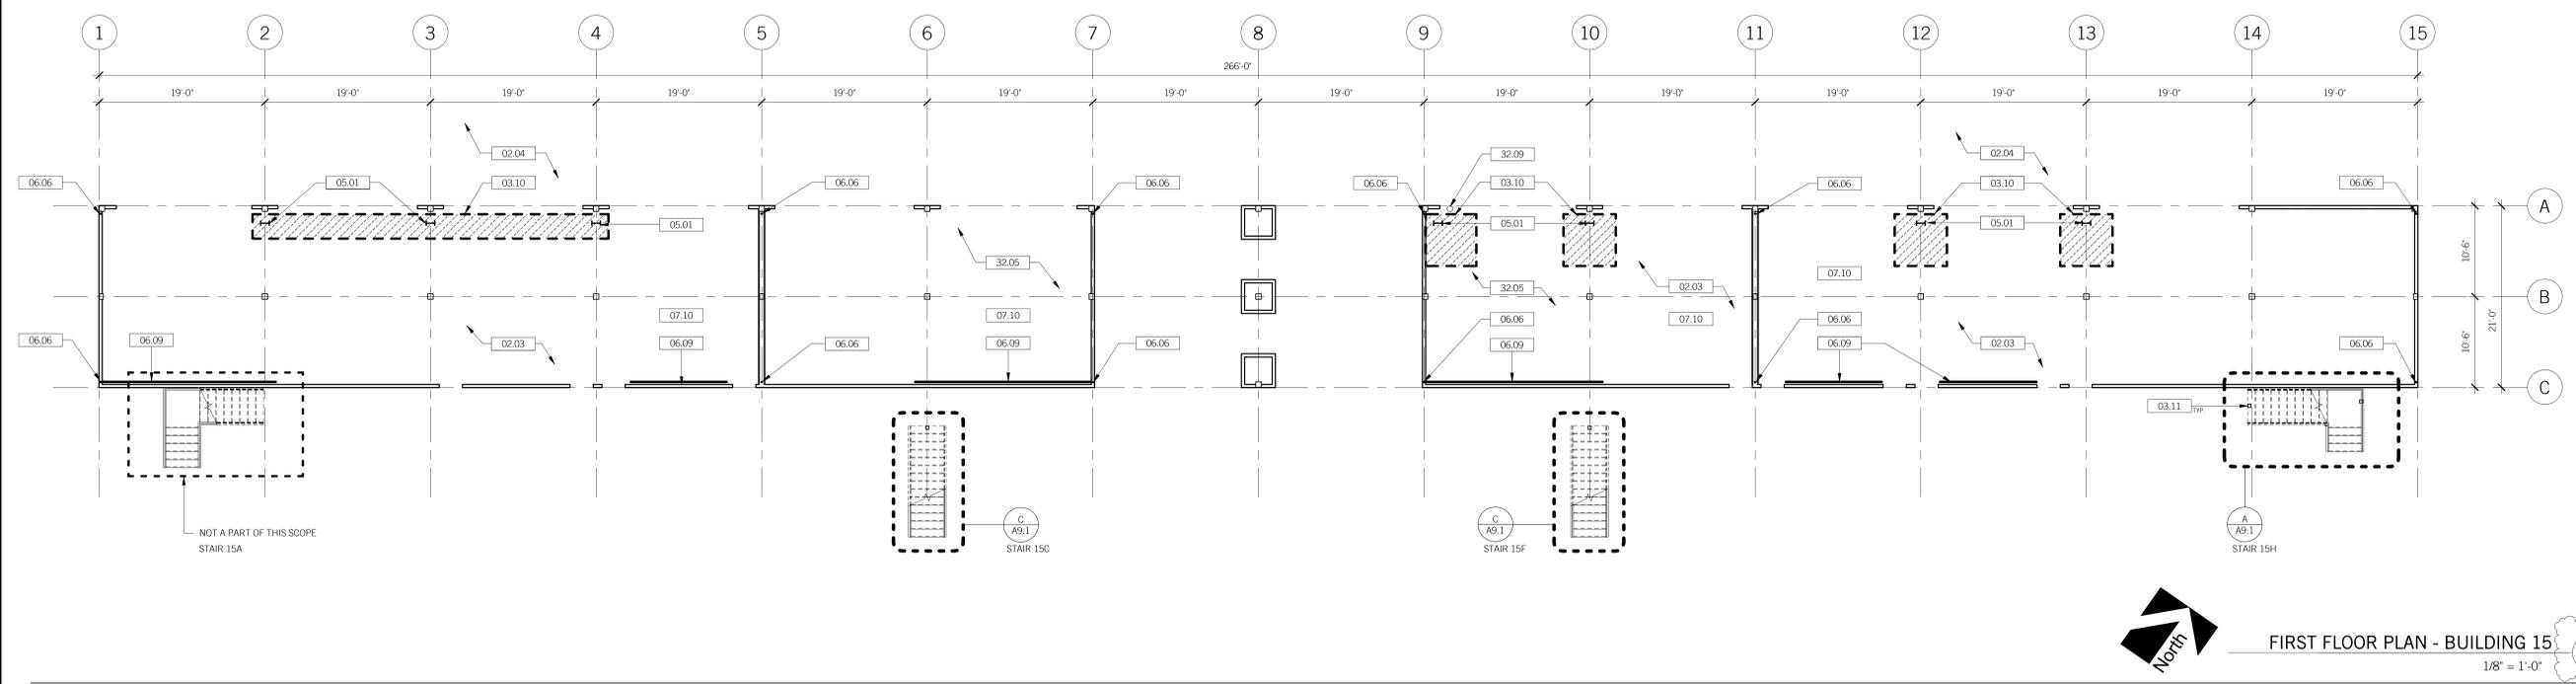


FIRST FLOOR PLAN - BUILDING 15
1/8" = 1'-0"

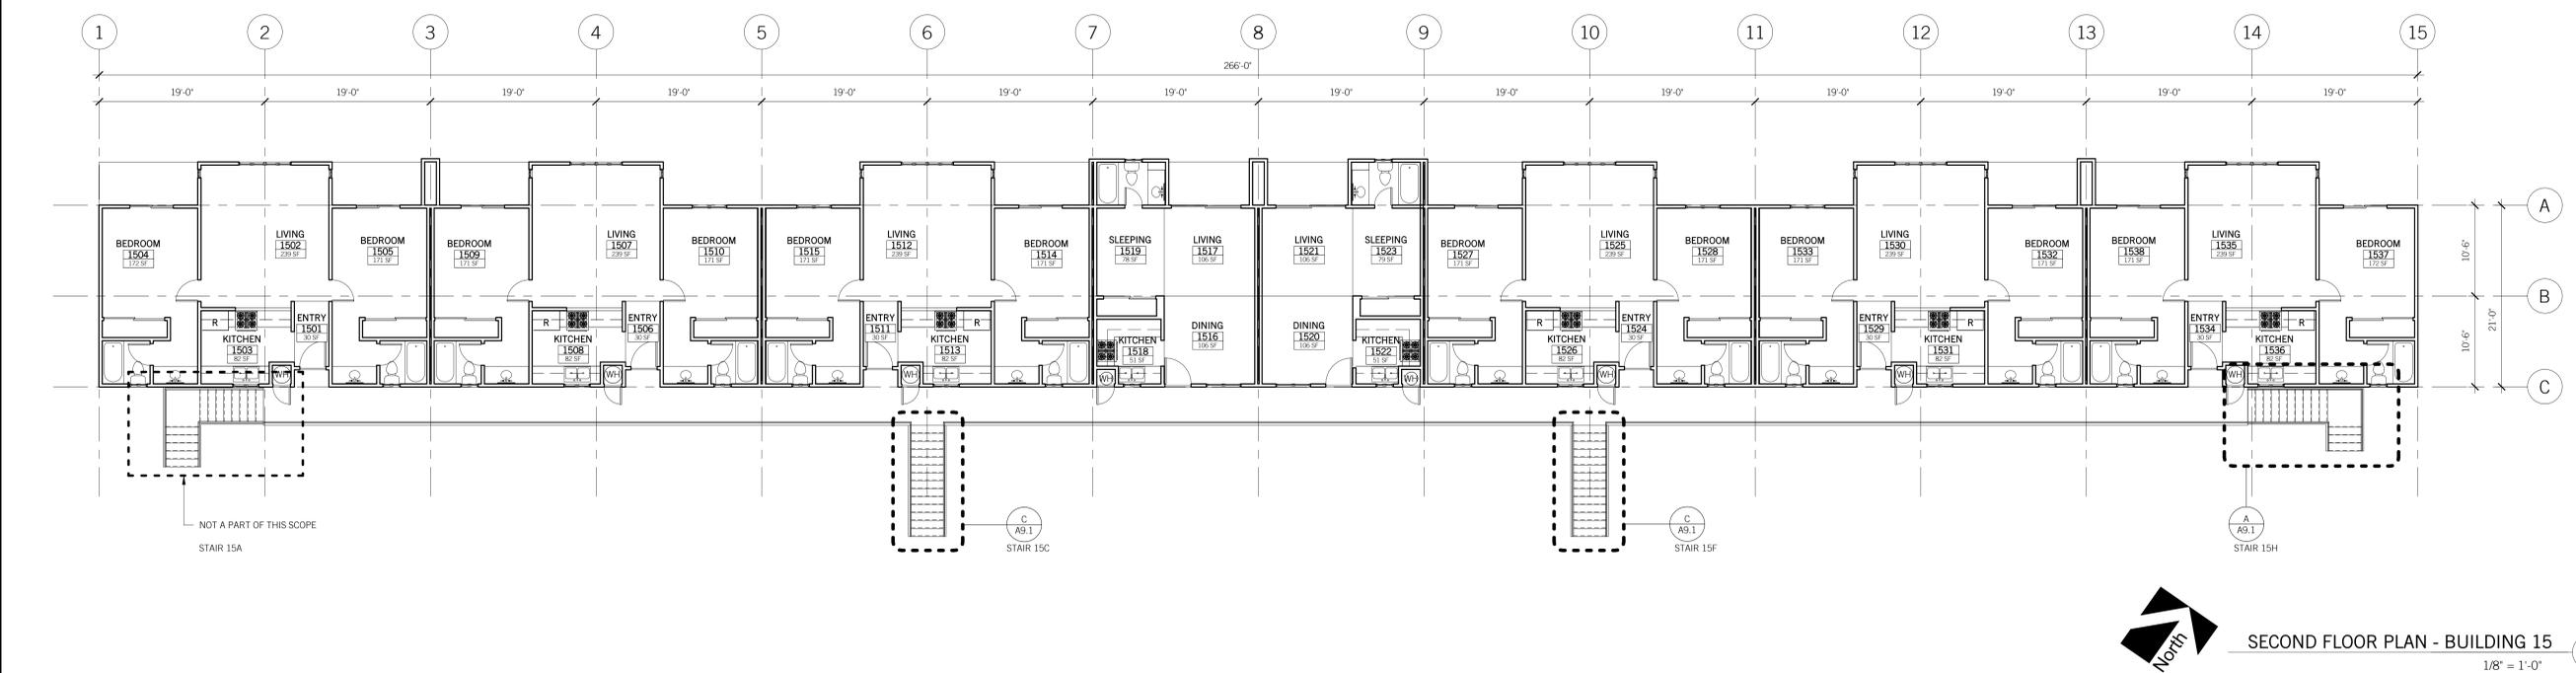

SECOND FLOOR PLAN - BUILDING 15
1/8" = 1'-0"

- KEYNOTES** 00.00
- 02.03 (E) CONCRETE PAVING, PROTECT IN PLACE.
 - 02.04 (E) ASPHALTIC PAVING, PROTECT IN PLACE.
 - 03.10 (N) CONCRETE FOOTINGS FOR STRUCTURAL COLUMN REPAIR WORK. PATCH TO MATCH (E) CONC. SLOPES. SEE: STRUCTURAL DRAWINGS.
 - 03.11 (N) CONCRETE FOOTING AND COLUMN. SEE: STRUCTURAL DRAWINGS.
 - 05.01 ALL EXPOSED COLUMN AND BRACING TO RECEIVE INTUMESCENT PAINT. ARCHITECT TO SELECT COLOR. SEE: STRUCTURAL DRAWINGS.
 - 06.06 (N) SIMPSON "HOLDOWN" PER PLAN. SEE: STRUCTURAL DRAWINGS.
 - 06.09 (N) PLYWOOD SHEAR PANEL. REPAIR & PAINT TO MATCH (E) ADJACENT WALL SURFACE. SEE: STRUCTURAL DRAWINGS.
 - 07.10 WHERE SLAB/WALL PENETRATION OCCURS. SEE: 8/A9.2.
 - 32.05 (N) 4" WIDE PARKING STRIPING W/ WHITE PAVEMENT PAINT.
 - 32.09 (N) CONCRETE VEHICLE & SAFETY BOLLARD AT 0' CURB. SEE: 4/A1.2.
- WALL LEGEND**
- LEGEND**
- (E) WINDOWS AND SYSTEMS, PROTECT IN PLACE.

- FINISH REPAIR NOTE**
- WHERE EXISTING EXTERIOR/INTERIOR FINISHES HAVE BEEN DISTURBED AS A RESULT OF THE WORK SCOPE REQUIRED HEREIN, THE CONTRACTOR SHALL REPAIR THOSE FINISHES TO MATCH AS CLOSELY AS POSSIBLE. EXISTING ADJACENT FINISH. IN ADDITION, THE CONTRACTOR SHALL PREP, PRIME AND PAINT THE ENTIRE WALL, FLOOR OR CEILING SURFACE TO THE NEAREST PAINT BREAK. THIS MAY INCLUDE, BUT NOT BE LIMITED TOO; INSIDE OR OUTSIDE WALL CORNERS, WALL TO CEILING OR FLOOR, LEDGER BEAMS, DIFFERENT MATERIALS NOT DISTURBED BY THE WORK, ETC. IT SHALL BE THE BIDDING CONTRACTOR'S RESPONSIBILITY TO REVIEW ALL SCENARIOS AND CONDITIONS, AND WALK THE SITE BEFORE PROVIDING HISHER BID.
- FIRE FINISH NOTE:**
- ALL BUILDING STRUCTURAL STEEL FRAME WITHIN GARAGE SPACE TO BE COATED WITH INTUMESCENT PAINT TO ACHIEVE 1-HR FIRE RATING.

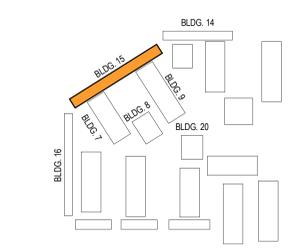

KEY PLAN

INSPECTIONS REQUIRED

UC RIVERSIDE
Office of Planning, Design & Construction
Signed: *[Signature]*
Building, Safety and Compliance Division
CAMPUS BUILDING PERMIT

APPROVED

UC RIVERSIDE
Planning, Design & Construction
Signed: *[Signature]*
Building & Safety Division
Campus Building Permit

OFFICE OF THE STATE FIRE MARSHAL
APPROVED FIRE AND PANIC ONLY
07/02/2019

Approval of this plan does not authorize or approve any emission or deviation from applicable regulations. Final approval is subject to field inspection. One set of approved plans shall be available on the project site at all times.

Reviewed by: *[Signature]*
Fire and Life Safety Division

miyamoto.

LEADER ARCHITECT
Member A, B, C
1901 East Alhambra Avenue, Suite 100
Santa Ana, CA 92705
T: (949) 579-1770
M: (949) 401-1100
miyamotointernational.com

Formillus

ARCHITECTURE
Building relationships. Transforming environments.

3080 12th Street, Suite 105
Riverside, California 92507
O: 951.530.8278
E: info@formillus.com
W: formillus.com

UNIVERSITY OF CALIFORNIA, RIVERSIDE
FALKIRK SITE AND SEISMIC IMPROVEMENTS - SUMMER 2019
3429 CANYON CREST DRIVE
RIVERSIDE, CA 92507


REVISIONS

ADDENDUM 1	01/18
ADDENDUM 2	02/18


UCR PROJECT #: 956390
UCR CAAN #: P5673
DATE: 06-28-2019
DRAWN: LR

BUILDING 15 - FLOOR PLANS
A15-2.2


PLOT DATE: 6/28/2019 12:43:58 PM PLOTTED BY: LR

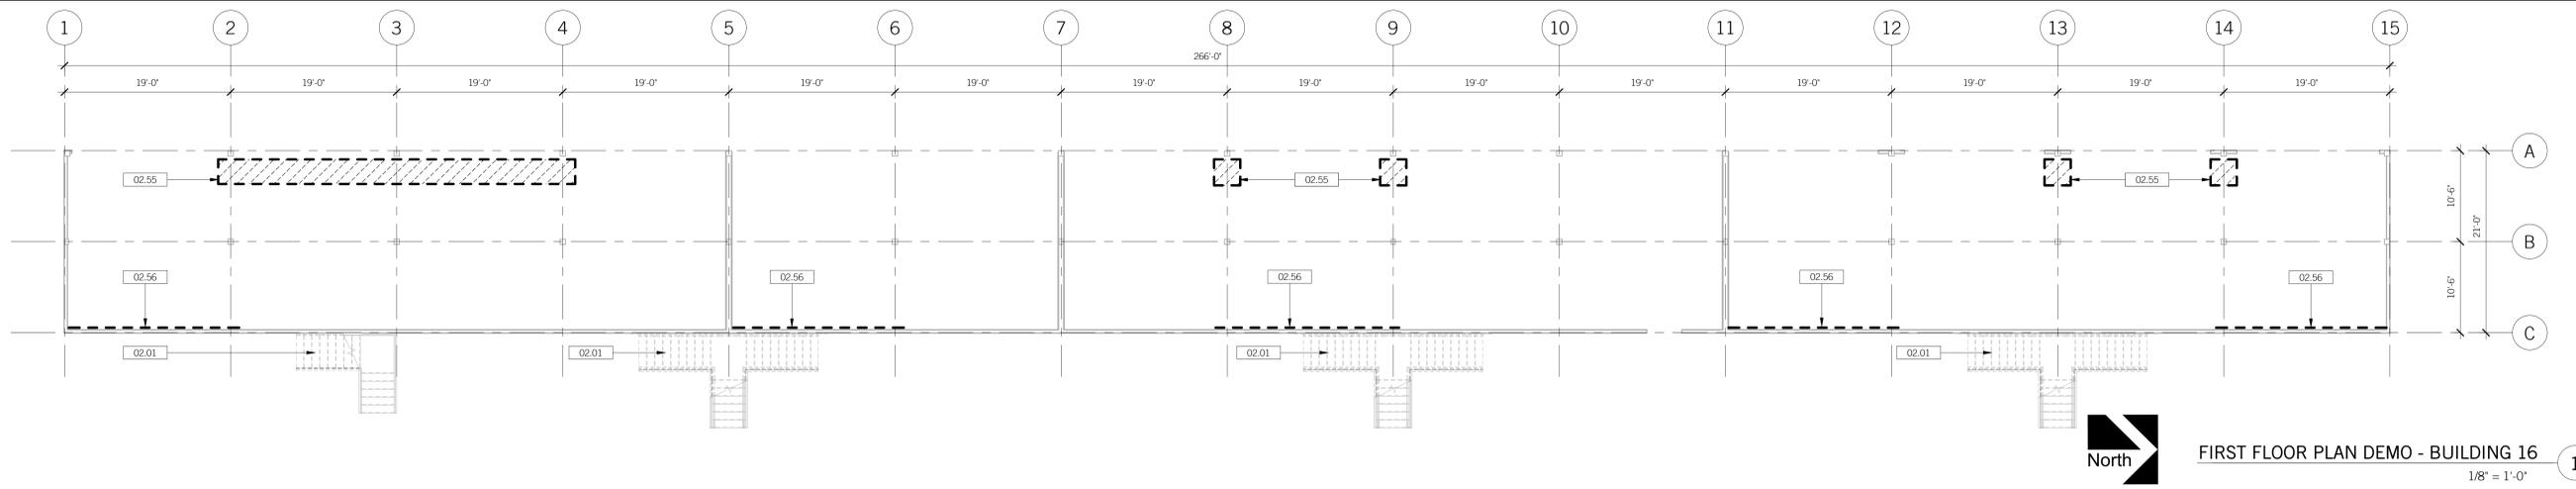

FIRST FLOOR PLAN DEMO - BUILDING 16
1/8" = 1'-0"

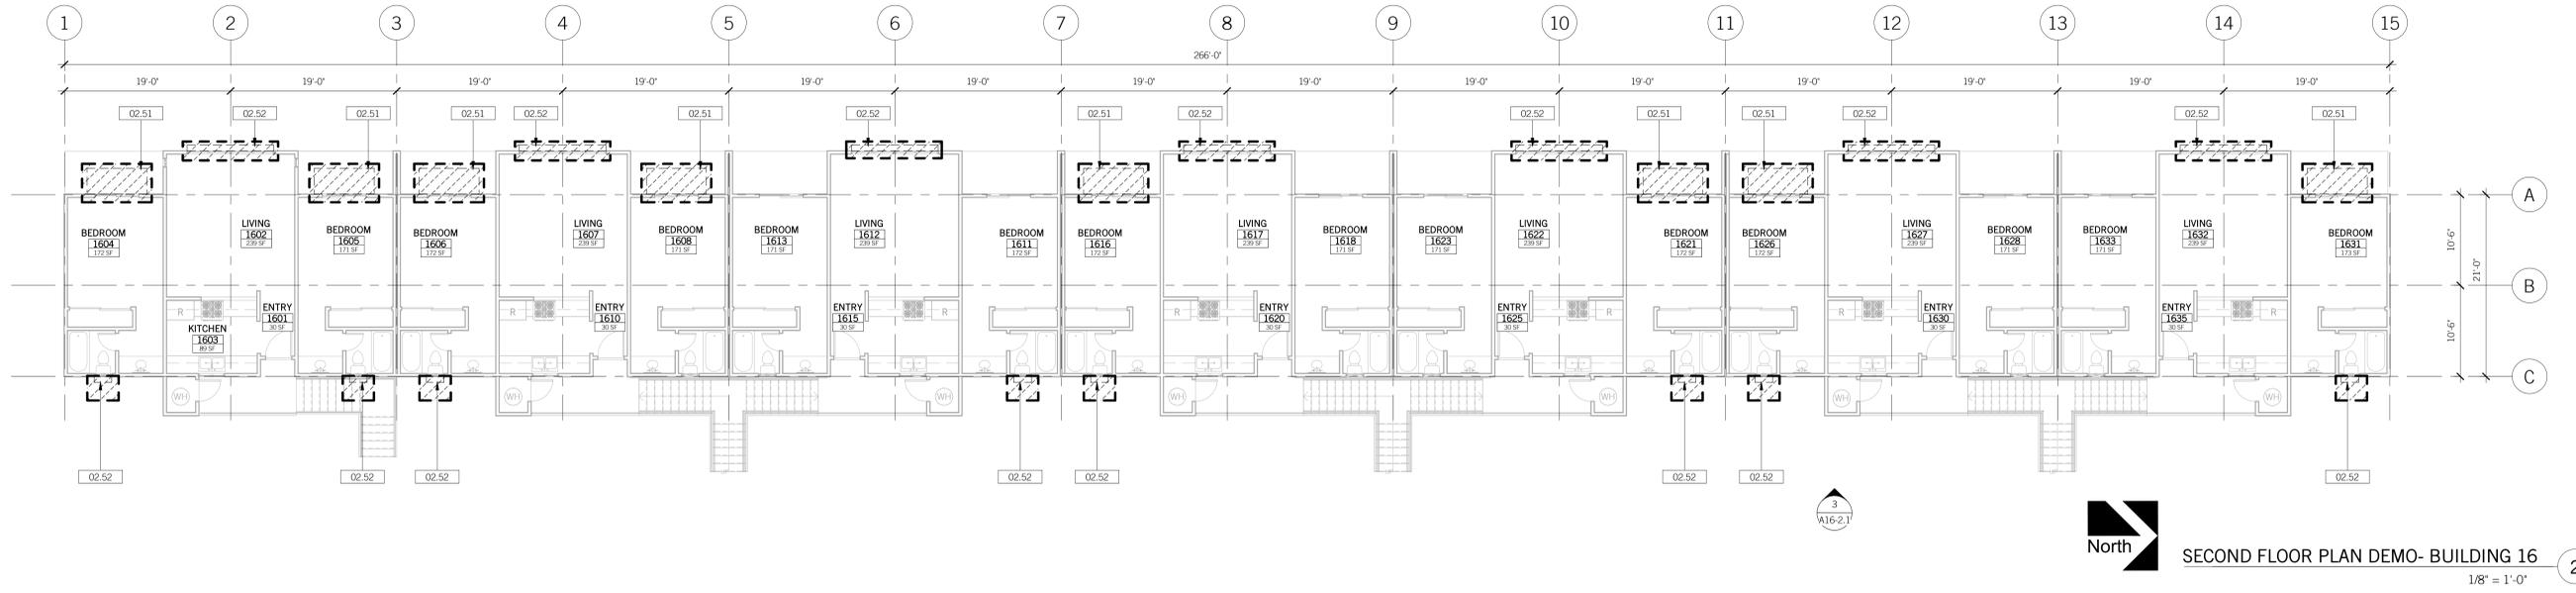

SECOND FLOOR PLAN DEMO - BUILDING 16
1/8" = 1'-0"

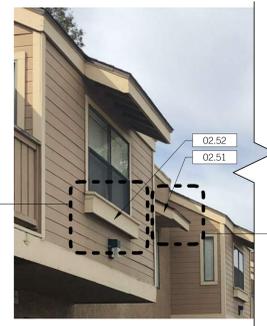

TYP. ROOF EYEBROW & POT SHELF


KEYNOTES 00.00

- 02.01 (E) STAIRS TO REMAIN, PROTECT IN PLACE.
- 02.51 REMOVE (E) WOOD EYEBROW AND ALL FASTENERS, USE WEATHER-RESISTANT, PAINTABLE WOOD FILLER TO PATCH HOLES.
- 02.52 REMOVE (E) POT SHELF AND ALL FASTENERS, USE WEATHER-RESISTANT, PAINTABLE WOOD FILLER TO PATCH HOLES.
- 02.55 SAWCUT AND REMOVE (E) CONCRETE SLAB AS REQUIRED FOR NEW FOOTINGS. SEE: STRUCTURAL DRAWINGS.
- 02.56 REMOVE (E) GYPSUM BOARD AND/OR WALL FINISH 1/2" MIN. BEYOND WORK OR TO CLOSEST CONTROL JOINT TO ALLOW FOR INSTALLATION OF NEW STRUCTURAL WORK. SEE: STRUCTURAL DRAWINGS.

WALL LEGEND

- (E) STUD WALL, PROTECT IN PLACE.
- (E) DOOR, FRAME AND ALL HARDWARE, PROTECT IN PLACE.
- (E) WINDOWS AND SYSTEMS, PROTECT IN PLACE.
- AREA OF DEMOLITION.

LEGEND

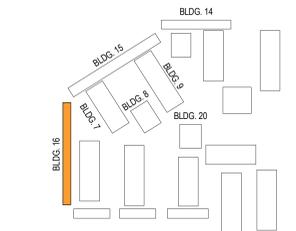

KEY PLAN

INSPECTIONS REQUIRED
 UC RIVERSIDE
 Office of Planning, Design & Construction
 Signed CSO: Blair S. Bellows
 Building, Safety and Compliance Division
 CAMPUS BUILDING PERMIT
 ALL INFORMATION IS SUBJECT TO THE 2019 CALIFORNIA BUILDING CODE

APPROVED
 UC RIVERSIDE
 Planning, Design and Construction
 Campus Building Permit
 Signature: [Signature]
 Building & Safety Division
 Campus Building Permit

OFFICE OF THE STATE FIRE MARSHAL
 APPROVED FIRE AND PANIC ONLY
07/02/2019
 Approval of this plan does not authorize or approve any emission or deviation from applicable regulations. Final approval is subject to field inspection. One set of approved plans shall be available on the project site at all times.
 Reviewed by: [Signature]
 Fire and Life Safety Division/Staff

miyamoto.
 ARCHITECT
 Member A, B, C
 1901 East Alhambra Avenue, Suite 100
 Santa Ana, CA 92705
 T: (949) 570-1770
 m.yamamoto@miyamoto.com
 MI904011.00

Formillus
 ARCHITECTURE
 Building relationships. Transforming environments.
 3080 12th Street, Suite 105
 Riverside, California 92507
 O: 951.530.8778
 E: info@formillus.com
 W: formillus.com


UNIVERSITY OF CALIFORNIA, RIVERSIDE
 FALKIRK SITE AND SEISMIC IMPROVEMENTS - SUMMER 2019
 3429 CANYON CREST DRIVE
 RIVERSIDE, CA 92507

REVISIONS


ADDENDUM 1	01/18/19
ADDENDUM 2	02/18/19

UCR PROJECT #: 956390
 UCR CAAN #: P5673
 DATE: 06-28-2019
 DRAWN: LR

BUILDING 16 - FLOOR PLAN - DEMOLITION
A16-2.1

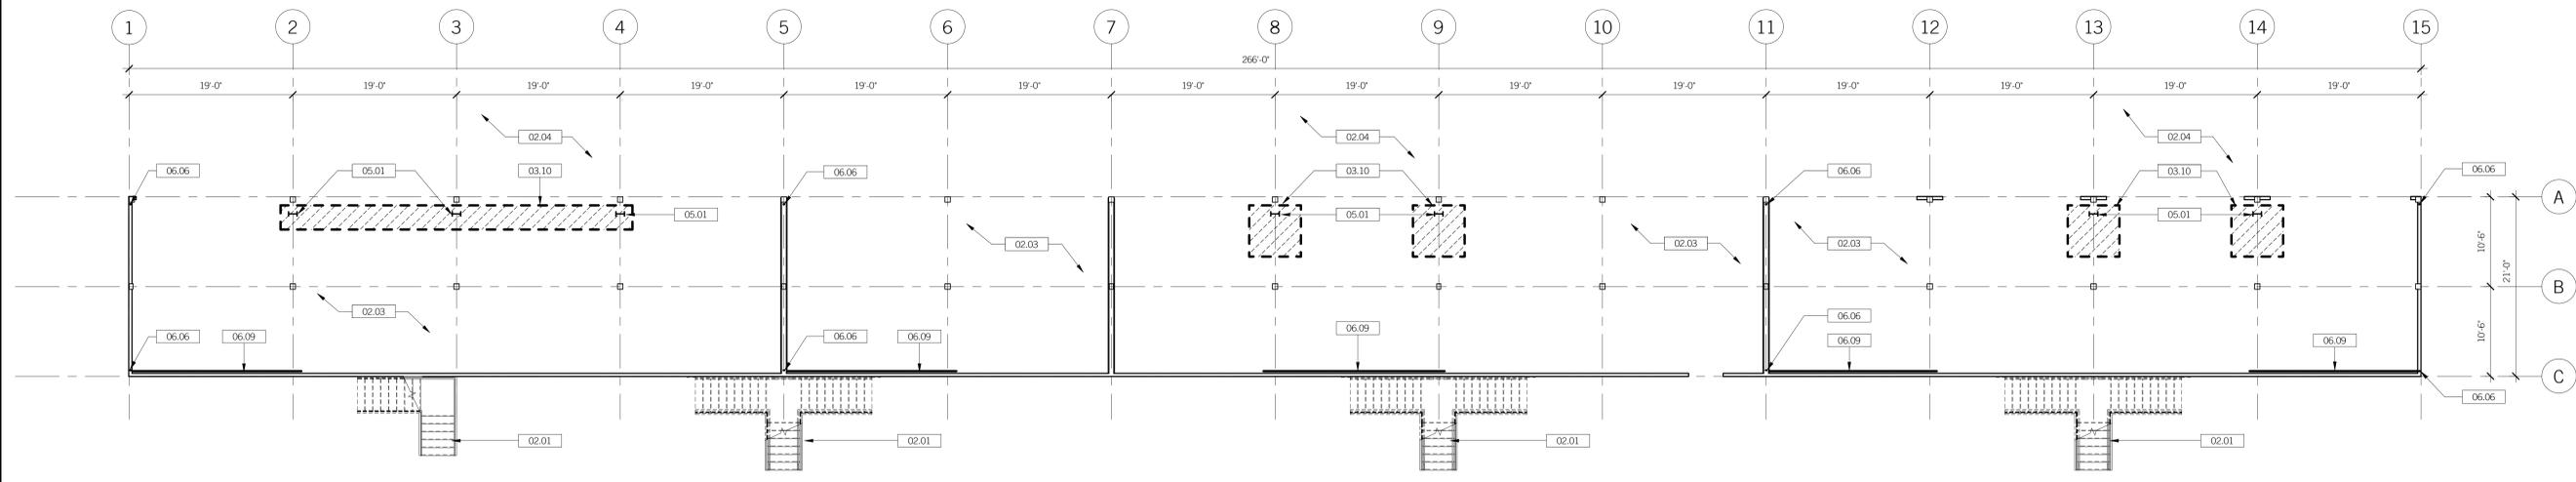

North
FIRST FLOOR PLAN - BUILDING 16
1/8" = 1'-0"

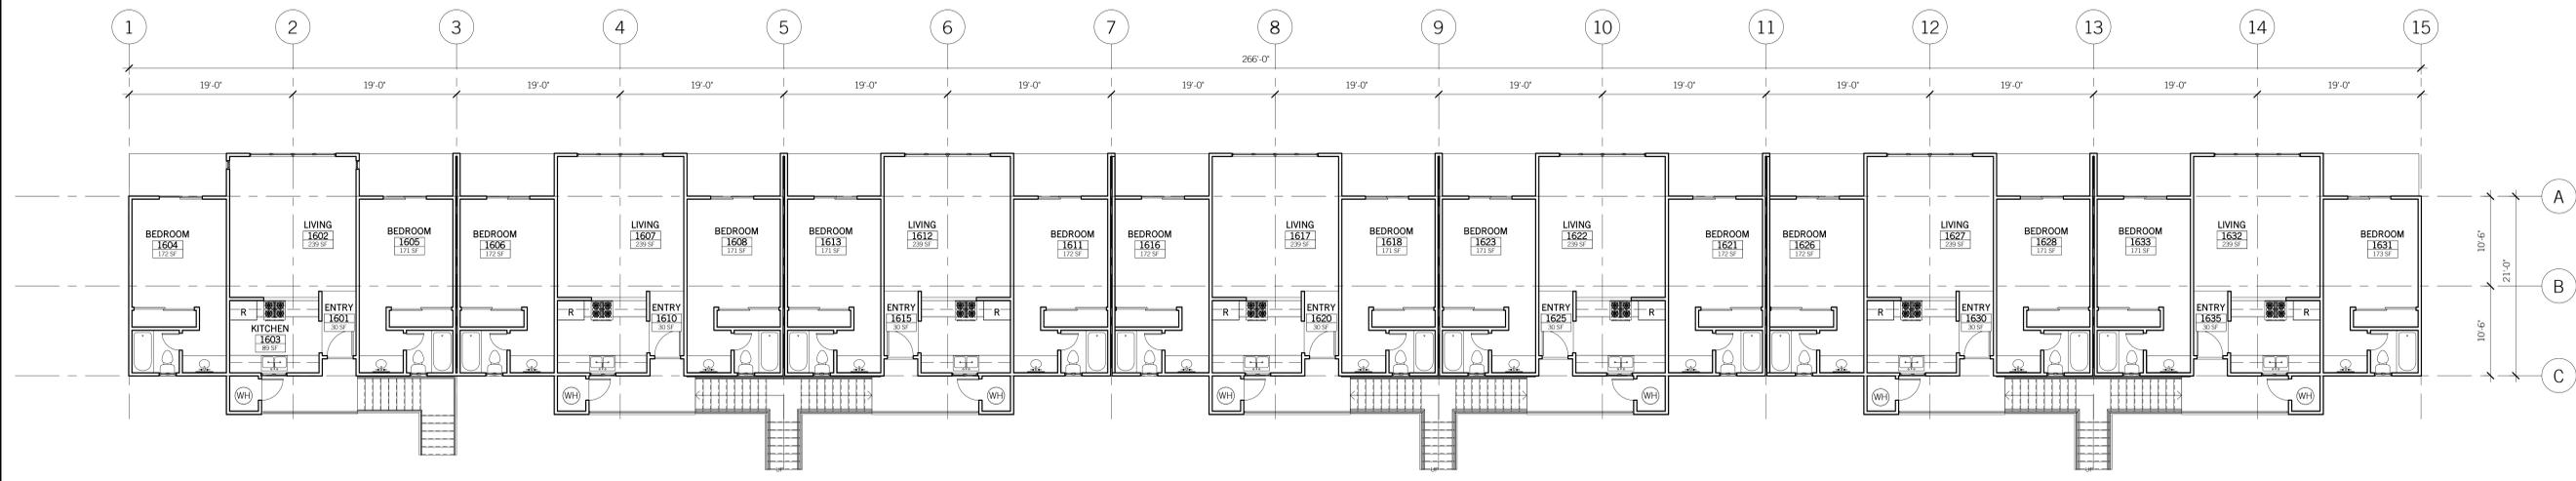

North
SECOND FLOOR PLAN - BUILDING 16
1/8" = 1'-0"

KEYNOTES 00.00

02.01 (E) STAIRS TO REMAIN, PROTECT IN PLACE.
02.03 (E) CONCRETE PAVING, PROTECT IN PLACE.
02.04 (E) ASPHALTIC PAVING, PROTECT IN PLACE.

03.10 (N) CONCRETE FOOTINGS FOR STRUCTURAL COLUMN REPAIR WORK. PATCH TO MATCH (E) CONC. SLOPES. SEE: STRUCTURAL DRAWINGS.

05.01 ALL EXPOSED COLUMN AND BRACING TO RECEIVE INTUMESCENT PAINT. ARCHITECT TO SELECT COLOR. SEE: STRUCTURAL DRAWINGS.

06.06 (N) SIMPSON "HOLDOWN" PER PLAN. SEE: STRUCTURAL DRAWINGS.
06.09 (N) PLYWOOD SHEAR PANEL. REPAIR & PAINT TO MATCH (E) ADJACENT WALL SURFACE. SEE: STRUCTURAL DRAWINGS.

WALL LEGEND

(E) STUD WALL, PROTECT IN PLACE.

LEGEND

(E) DOOR, FRAME AND ALL HARDWARE, PROTECT IN PLACE.

(E) WINDOWS AND SYSTEMS, PROTECT IN PLACE.

FINISH REPAIR NOTE

1. WHERE EXISTING EXTERIOR/INTERIOR FINISHES HAVE BEEN DISTURBED AS A RESULT OF THE WORK SCOPE REQUIRED HEREIN, THE CONTRACTOR SHALL REPAIR THOSE FINISHES TO MATCH AS CLOSELY AS POSSIBLE. EXISTING ADJACENT FINISH - IN ADDITION, THE CONTRACTOR SHALL PREP, PRIME AND PAINT THE ENTIRE WALL, FLOOR OR CEILING SURFACE, TO THE NEAREST PAINT BREAK. THIS MAY INCLUDE, BUT NOT BE LIMITED TO: INSIDE OR OUTSIDE WALL CORNERS, WALL TO CEILING OR FLOOR, LEDGER BEAMS, DIFFERENT MATERIALS NOT DISTURBED BY THE WORK, ETC. IT SHALL BE THE BIDDING CONTRACTOR'S RESPONSIBILITY TO REVIEW ALL SCENARIOS AND CONDITIONS, AND WALK THE SITE BEFORE PROVIDING HIS/HER BID.

FIRE FINISH NOTE:

1. ALL BUILDING STRUCTURAL STEEL FRAME WITHIN GARAGE SPACE TO BE COATED WITH INTUMESCENT PAINT TO ACHIEVE 1-HR FIRE RATING.



KEY PLAN

INSPECTIONS REQUIRED
UC RIVERSIDE
Office of Planning, Design & Construction
Signed CBO: Blair S. Bellows
Building, Safety and Compliance Division
CAMPUS BUILDING PERMIT
ALL WORK SHALL BE IN ACCORDANCE WITH THE CALIFORNIA FIRE CODE

APPROVED
UC RIVERSIDE
Planning, Design and Construction
Campus Building Permit
Signature: [Signature]
Building & Safety Division
Campus Building Permit

OFFICE OF THE STATE FIRE MARSHAL
APPROVED FIRE AND PANIC ONLY
07/02/2019
Approval of this plan does not authorize or approve any erosion or rebar from applicable regulations. Final approval is subject to field inspection. One set of approved plans shall be available on the project site at all times.
Reviewed by: [Signature]
Fire and Life Safety Division


REVISIONS	DATE
ADDENDUM 1	07/19/19
ADDENDUM 2	02/19/19

UCR PROJECT #: 956390
UCR CAAN #: P5673
DATE: 06-28-2019
DRAWN: LR

BUILDING 16 - FLOOR PLANS


A16-2.2

PLOT DATE: 6/28/2019 8:55:26 AM
PLOTTED BY: LR

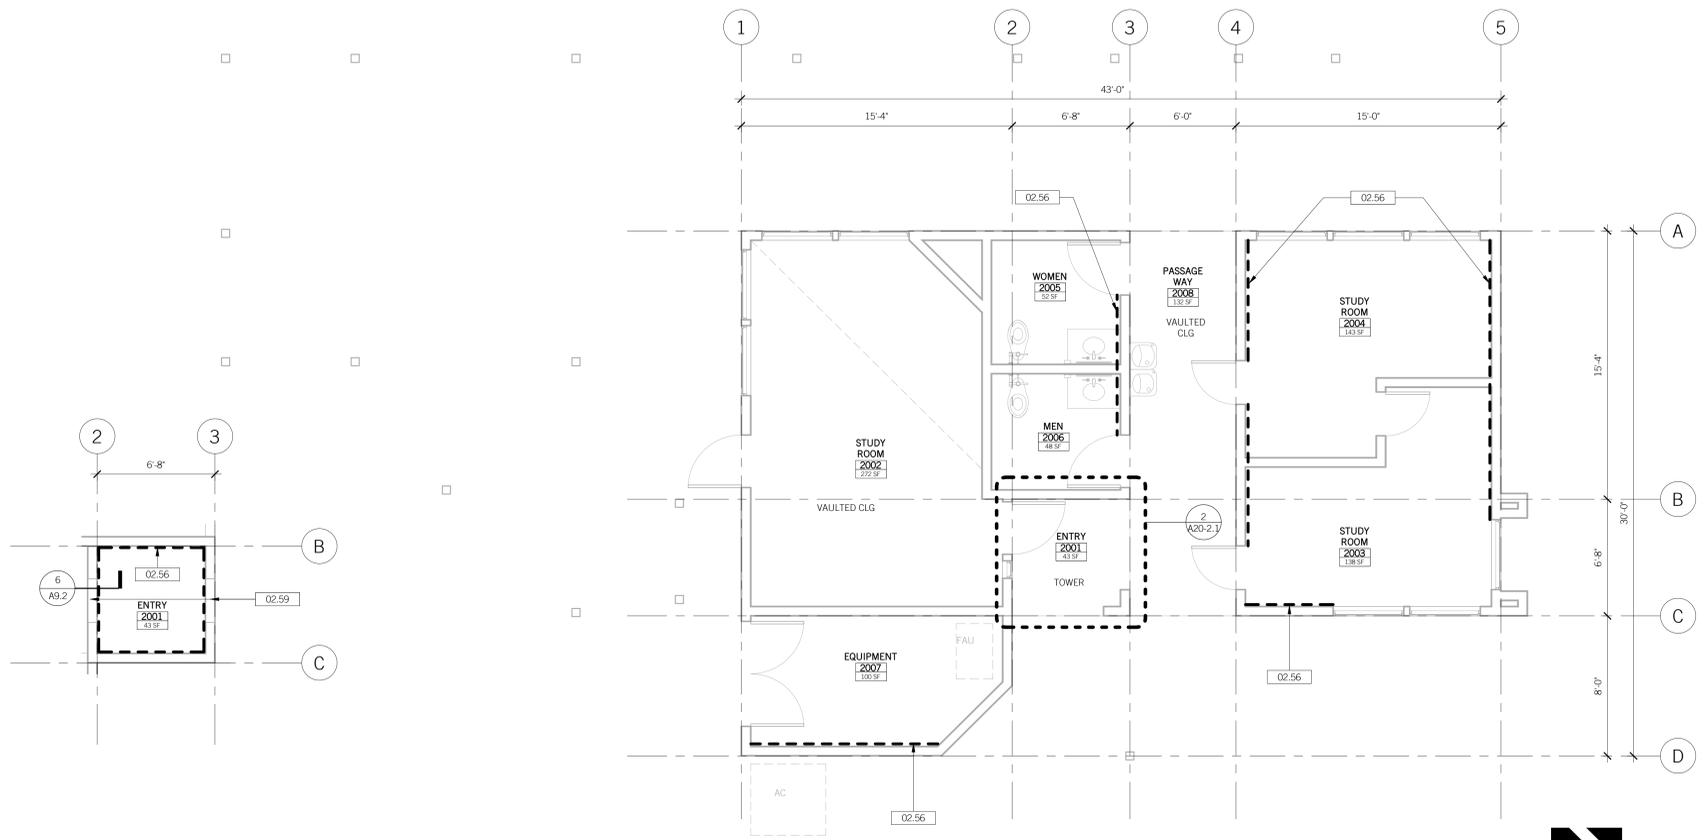

ENTRY 2001 - ROOF FRAMING PLAN DEMO
1/4" = 1'-0" ②

North
FIRST FLOOR PLAN DEMO - BUILDING 20
1/4" = 1'-0" ①

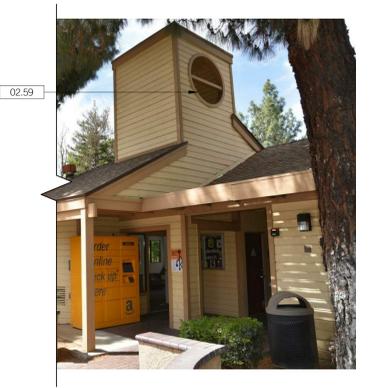

ENTRY 2001 OPENING ③

KEYNOTES 00.00

- 02.56 REMOVE (E) GYPSUM BOARD AND/OR WALL FINISH 1/2" MIN. BEYOND WORK OR TO CLOSEST CONTROL JOINT TO ALLOW FOR INSTALLATION OF NEW STRUCTURAL WORK. SEE: STRUCTURAL DRAWINGS.
- 02.59 REMOVE (E) OPENING COMPONENTS AND INFILL. PAINT TO MATCH. SEE: STRUCTURAL DRAWINGS.

WALL LEGEND


(E) STUD WALL, PROTECT IN PLACE.

LEGEND

(E) DOOR, FRAME AND ALL HARDWARE, PROTECT IN PLACE.

(E) WINDOWS AND SYSTEMS, PROTECT IN PLACE.

AREA OF DEMOLITION.

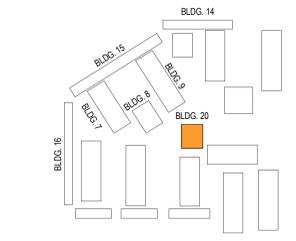

KEY PLAN

INSPECTIONS REQUIRED
UC RIVERSIDE
Office of Planning, Design & Construction
Signed: *[Signature]*
Building, Safety and Compliance Division
CAMPUS BUILDING PERMIT

APPROVED
UC RIVERSIDE
Planning, Design and Construction
Campus Building Permit
Signature: *[Signature]*
Building & Safety Division
Campus Building Permit

OFFICE OF THE STATE FIRE MARSHAL
APPROVED FIRE AND PANIC ONLY
07/02/2019
Approval of this plan does not authorize or approve any erosion or deviation from applicable regulations. Final approval is subject to field inspection. One set of approved plans shall be available on the project site at all times.
Reviewed by: *[Signature]*
Fire and Life Safety Division

miyamoto.
LEADER ARCHITECT
Member A, B, C
1901 East Alhambra Avenue, Suite 100
Santa Ana, CA 92705
T: (949) 570-1770
miyamotointernational.com

3080 12th Street, Suite 105
Riverside, California 92507
O: 951.530.8778
E: info@formillus.com
W: formillus.com
Formillus
ARCHITECTURE
Building relationships. Transforming environments.


UNIVERSITY OF CALIFORNIA, RIVERSIDE
FALKIRK SITE AND SEISMIC IMPROVEMENTS - SUMMER 2019
3429 CANYON CREST DRIVE
RIVERSIDE, CA 92507

REVISIONS

ADDENDUM 1	07/19/19
ADDENDUM 2	02/18/19

UCR PROJECT #: 956390
UCR CAAN #: P5673
DATE: 06-28-2019
DRAWN: LR

BUILDING 20 - FLOOR PLAN DEMOLITION
A20-2.1

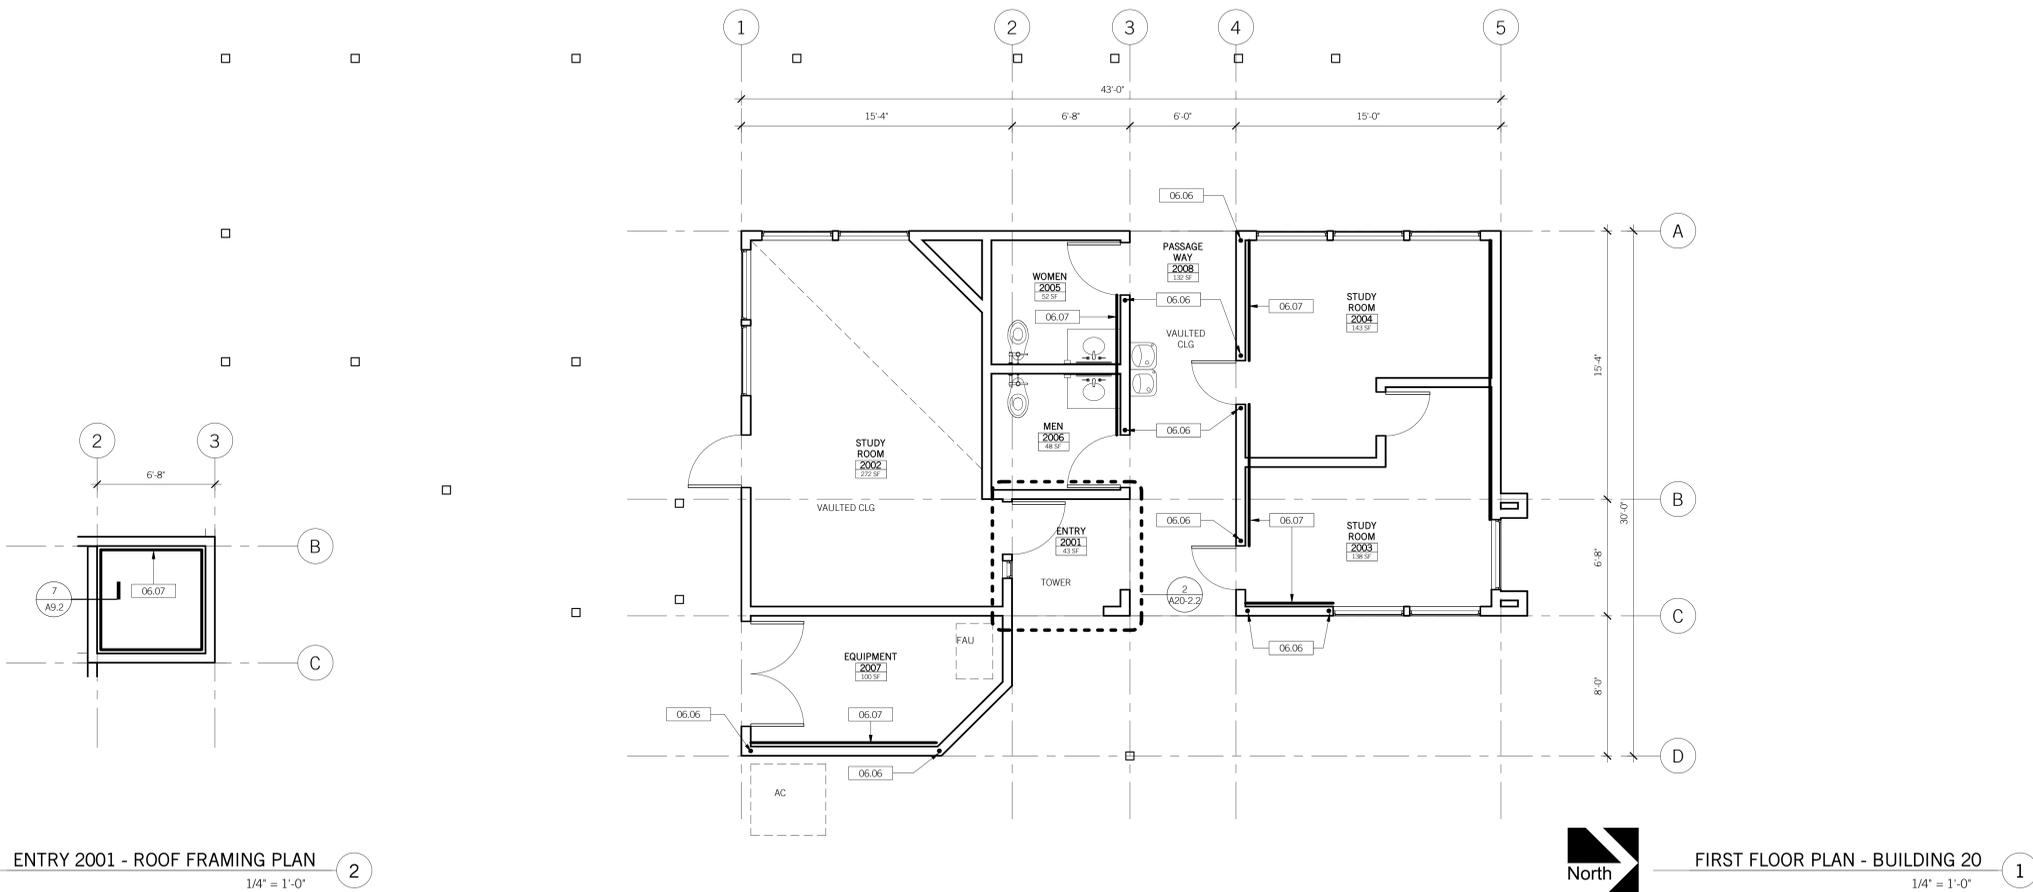

KEYNOTES 00.00

- 06.06 (N) SIMPSON "HOLD-DOWN" PER PLAN. SEE STRUCTURAL DRAWINGS.
- 06.07 (N) WOOD SIDING TO MATCH ORIGINAL AS CLOSE AS POSSIBLE. PRIME AND PAINT SIDING TO MATCH ADJACENT FINISHES OR BUILDING THEME. SEE FINISH REPAIR NOTE THIS SHEET.

WALL LEGEND

(E) STUD WALL, PROTECT IN PLACE.

LEGEND

(E) DOOR, FRAME AND ALL HARDWARE, PROTECT IN PLACE.

(E) WINDOWS AND SYSTEMS, PROTECT IN PLACE.

FINISH REPAIR NOTE

- WHERE EXISTING EXTERIOR/INTERIOR FINISHES HAVE BEEN DISTURBED AS A RESULT OF THE WORK SCOPE REQUIRED HEREIN, THE CONTRACTOR SHALL REPAIR THOSE FINISHES TO MATCH AS CLOSELY AS POSSIBLE. EXISTING ADJACENT FINISH. IN ADDITION, THE CONTRACTOR SHALL PREP, PRIME AND PAINT THE ENTIRE WALL, FLOOR OR CEILING SURFACE, TO THE NEAREST PAINT BREAK. THIS MAY INCLUDE, BUT NOT BE LIMITED TO: INSIDE OR OUTSIDE WALL CORNERS, WALL TO CEILING OR FLOOR, LEDGER BEAMS, DIFFERENT MATERIALS NOT DISTURBED BY THE WORK, ETC... IT SHALL BE THE BIDDING CONTRACTOR'S RESPONSIBILITY TO REVIEW ALL SCENARIOS AND CONDITIONS, AND WALK THE SITE BEFORE PROVIDING HISHER BID.

ENTRY 2001 - ROOF FRAMING PLAN 1/4" = 1'-0" 2

North FIRST FLOOR PLAN - BUILDING 20 1/4" = 1'-0" 1

miyamoto.
 1901 East Alhambra Avenue, Suite 100
 Santa Ana, CA 92705
 T: (949) 570-1770
 miyamotointernational.com

LEADER ARCHITECT
 Member A, B, C
 1901 East Alhambra Avenue, Suite 100
 Santa Ana, CA 92705
 T: (949) 570-1770
 miyamotointernational.com

Formillus
 ARCHITECTURE
 Building relationships. Transforming environments.
 3080 12th Street, Suite 105
 Riverside, California 92507
 O: 951.530.8778
 E: info@formillus.com
 W: formillus.com


UNIVERSITY OF CALIFORNIA, RIVERSIDE
 FALKIRK SITE AND SEISMIC IMPROVEMENTS - SUMMER 2019
 3429 CANYON CREST DRIVE
 RIVERSIDE, CA 92507

REVISIONS	
ADDENDUM 1	01/18
ADDENDUM 2	02/18

UCR PROJECT #: 956390
 UCR CAAN #: P5673
 DATE: 06-28-2019
 DRAWN: LR

BUILDING 20 - FLOOR PLAN

A20-2.2

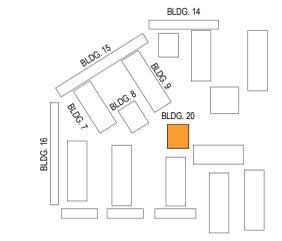




KEY PLAN

INSPECTIONS REQUIRED
 UC RIVERSIDE
 Office of Planning, Design & Construction
 Signed CBO: Blair S. Bellows
 Building, Safety and Compliance Division
 CAMPUS BUILDING PERMIT
 ALL INFORMATION SUBJECT TO UC RIVERSIDE POLICY

APPROVED
 UC RIVERSIDE
 Planning, Design and Construction
 Campus Building Permit
 Signature: [Signature]
 Building & Safety Division
 Campus Building Permit

OFFICE OF THE STATE FIRE MARSHAL
 APPROVED FIRE AND PANIC ONLY
 07/02/2019
 Approval of this plan does not authorize or approve any emission or deviation from applicable regulations. Final approval is subject to field inspection. One set of approved plans shall be available on the project site at all times.
 Reviewed by: [Signature]
 Fire and Life Safety Division




PLOTTED BY: LR
 PLOT DATE: 6/28/2019 8:56:04 AM

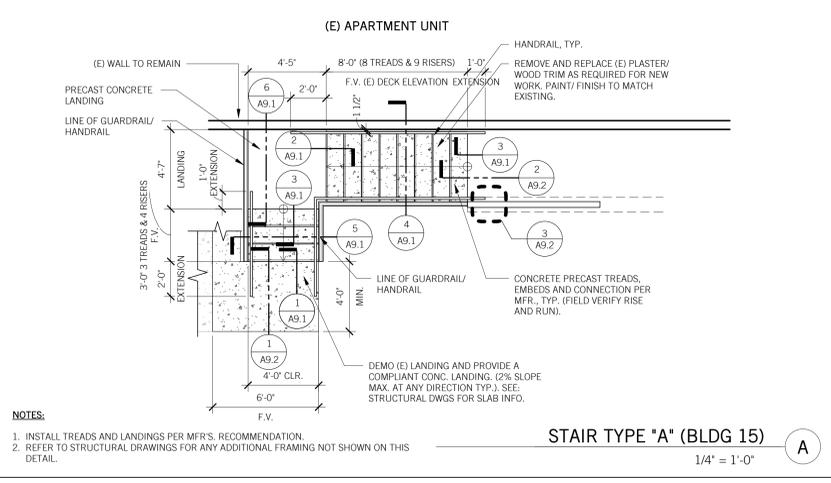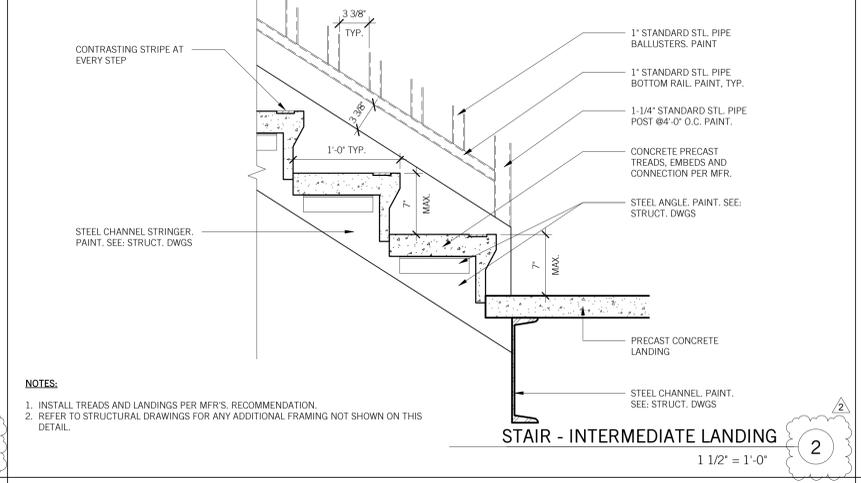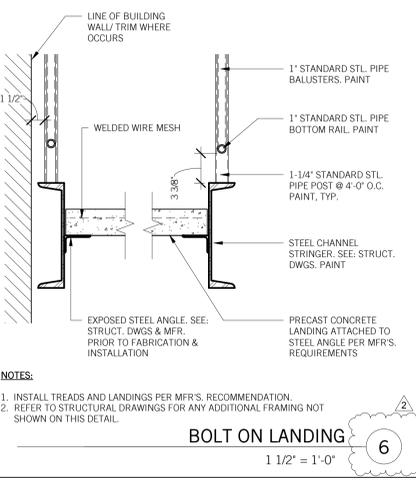

KEYNOTES 00.00

STAIR NOTES




- STAIR TREADS SHALL BE NO LESS THAN 1 1/2" DEEP, MEASURED FROM RISER TO RISER. BE SLIP RESISTANT, HAVE SMOOTH, ROUNDED OR CHAMFERED EXPOSED EDGES, AND HAVE NO ABRUPT EDGES AT THE NOSING.
- NOSING SHALL NOT PROJECT MORE THAN 1-1/4" PAST THE FACE OF THE RISER ABOVE, (CBC 11B-504)
- STAIR RISERS SHALL BE NO LESS THAN 4" HIGH AND NO GREATER THAN 7" HIGH MEASURED FROM TREAD TO TREAD.
- OPEN RISERS ARE NOT PERMITTED.
- ALL EXPOSED STRINGERS, GUARDS AND RAILING SYSTEM COMPONENTS SHALL BE PAINTED WITH HIGH-PERFORMANCE COATING A MINIMUM OF 1 COAT PRIME, 2 COATS PAINT AND PER SPECIFICATIONS. ARCHITECT TO SELECT COLOR.
- ALL WELDS SHALL BE GROUND SMOOTH AND PROPERLY PREPARED PRIOR TO FINISHING.
- ALL RAILING, STRINGERS, PANS, AND MISCELLANEOUS METALS SHALL BE Sanded, CLEANED TO BE FREE OF BURRS AND SHARP EDGES.
- CONTRACTOR TO PROVIDE FULL SHOP DRAWINGS FOR APPROVAL PRIOR TO PROCURING ANY MATERIALS.
- ALL ITEMS ARE CONSIDERED TO BE NEW UNLESS OTHERWISE NOTED.

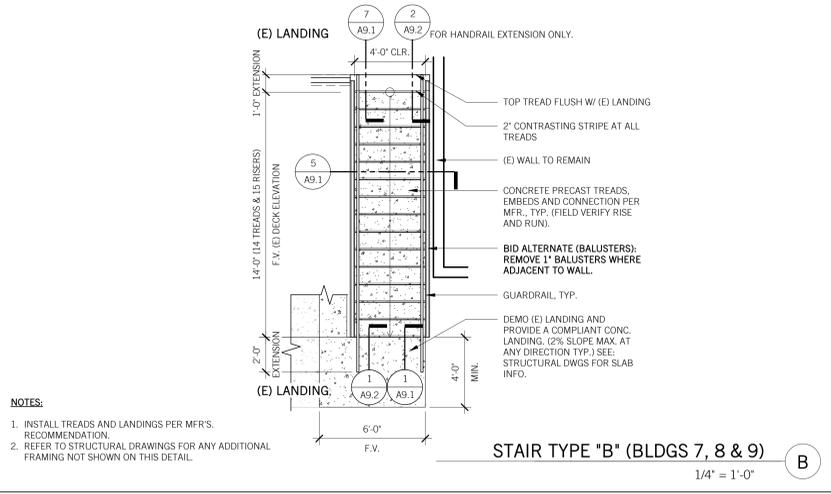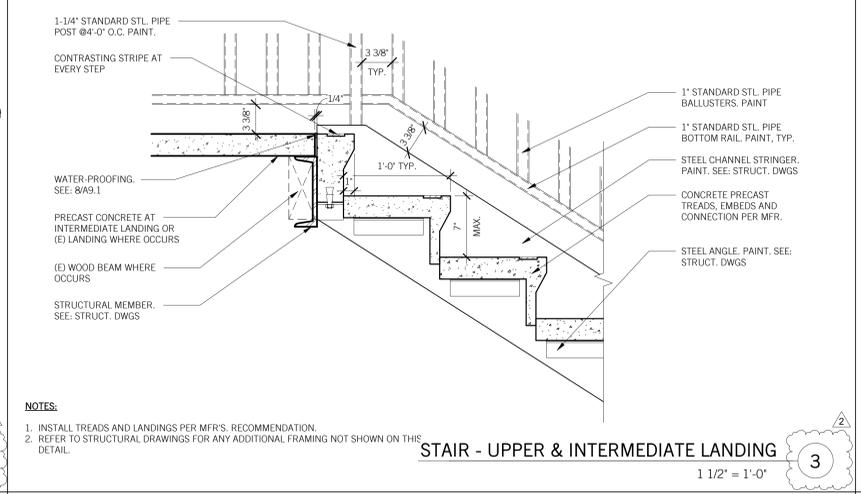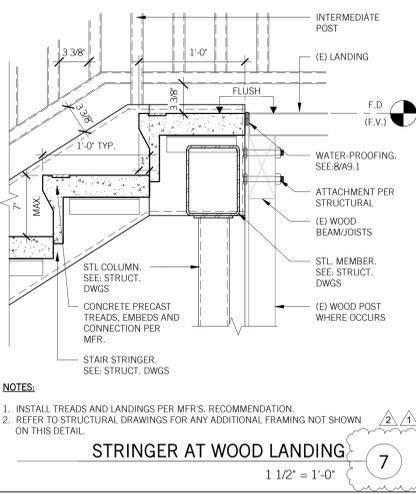



REVISIONS

ADDENDUM 1	01/19
ADDENDUM 2	02/19

UCR PROJECT #: 956390
UCR CAAN #: P5673
DATE: 06-28-2019
DRAWN: LR

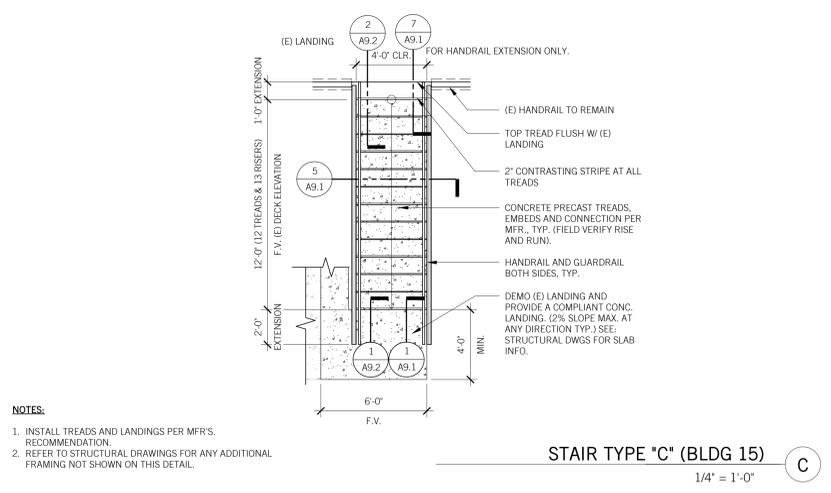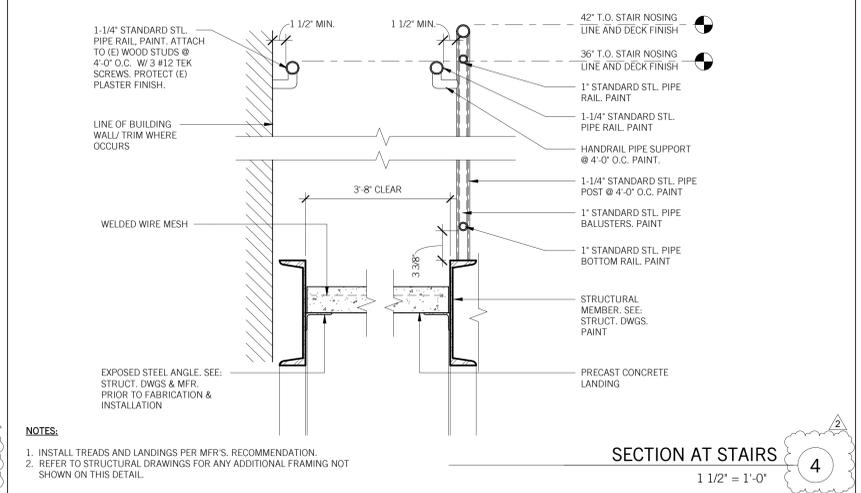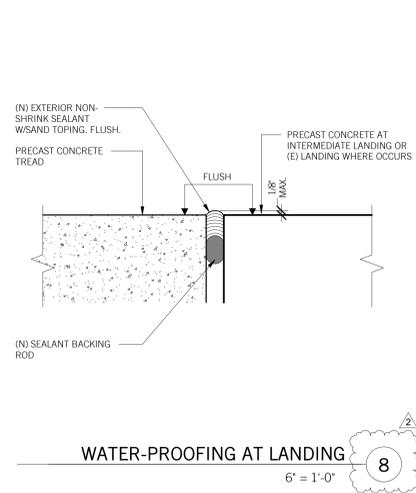

UNIVERSITY OF CALIFORNIA, RIVERSIDE
FALKIRK SITE AND SEISMIC IMPROVEMENTS - SUMMER 2019
3429 CANYON CREST DRIVE
RIVERSIDE, CA 92507

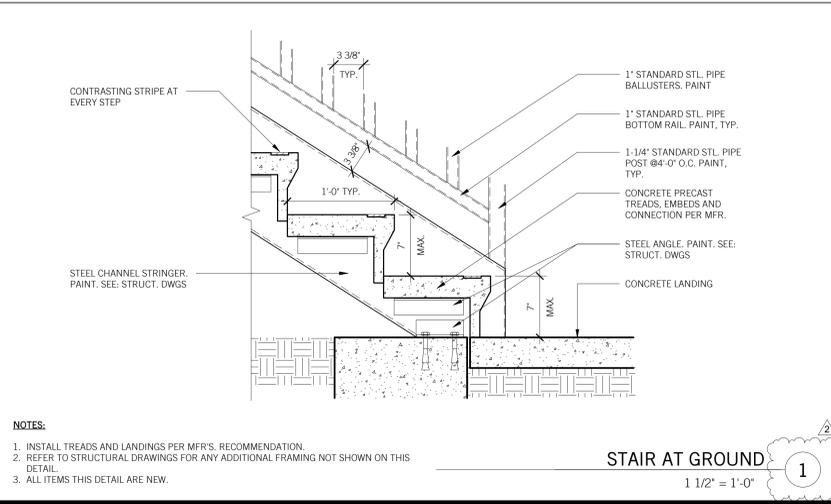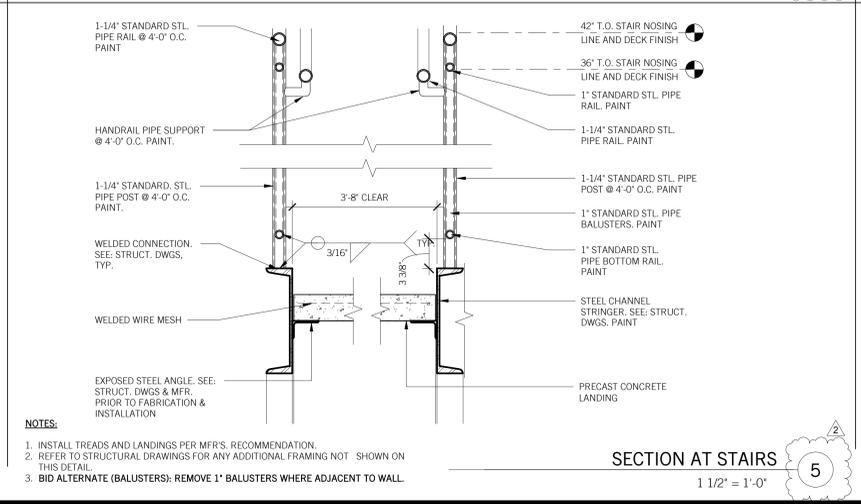

INSPECTIONS REQUIRED
UC RIVERSIDE
Office of Planning, Design & Construction
Signed: Robert K. Williams
Building, Safety and Compliance Division
CAMPUS BUILDING PERMIT
ALL WORK SHALL BE IN ACCORDANCE WITH THE CALIFORNIA PERMITS

APPROVED
UC Riverside
Planning, Design and Construction
Campus Building Official
Signature: Robert K. Williams
Building & Safety Division
Campus Building Permit

OFFICE OF THE STATE FIRE MARSHAL
APPROVED FIRE AND PANIC ONLY
07/02/2019
Approval of this plan does not authorize or approve any erection or deviation from applicable regulations. Final approval is subject to field inspection. One set of approved plans shall be available on the project site at all times.
Reviewed by: [Signature]

ENLARGED STAIR PLANS & SECTIONS A9.1

PLotted BY: LR
DATE: 6/28/2019 12:44:47 PM

miyamoto.
ARCHITECT
Member A, B, C
1901 East Alhambra Avenue, Suite 100
Santa Ana, CA 92705
T: (949) 570-1170
myamotointernational.com
MT090401.00

Formillus
ARCHITECTURE
Building relationships. Transforming environments.
3080 12th Street, Suite 105
Riverside, California 92507
O: 951.530.8278
E: info@formillus.com
W: formillus.com


REVISIONS

ADDENDUM 1	01/19
ADDENDUM 2	02/19


UCR PROJECT #: 956390
UCR CAAN #: P5673
DATE: 06-28-2019
DRAWN: LR

UNIVERSITY OF CALIFORNIA, RIVERSIDE
FALKIRK SITE AND SEISMIC IMPROVEMENTS - SUMMER 2019
3429 CANYON CREST DRIVE
RIVERSIDE, CA 92507

FINISH AND WATERPROOFING NOTES:
 1. WALLS TO RECEIVE SIDING REPAIR SHALL BE PAINTED IN THEIR ENTIRETY TO FIRST INSIDE OR OUTSIDE CORNER OR TRIM BREAK.
 2. WOOD SIDING UNDERLAYMENT REPAIR (30# BUILDING PAPER) SHALL EXTEND 6" UNDER AND 6" OVER EXISTING UNDERLAYMENT.

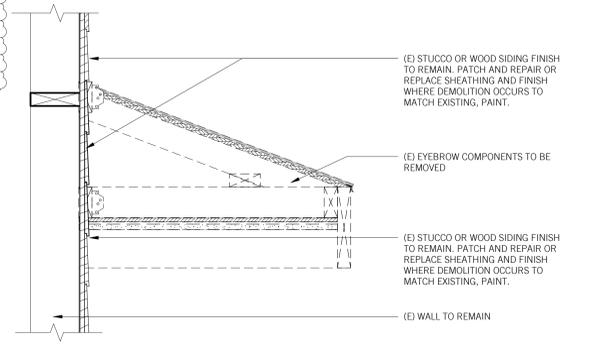


ROOF EYEBROW TYP. DETAIL - DEMO
 1 1/2" = 1'-0" 4

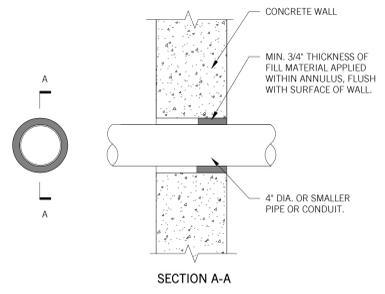


WALL PENETRATION
 1 1/2" = 1'-0" 8

NOTES:
 1. U.L. SYSTEM NO. C-AJ-1013

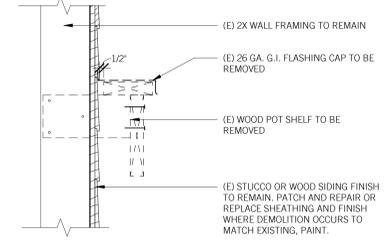


POT SHELF DETAIL - DEMO
 1 1/2" = 1'-0" 5


FINISH AND WATERPROOFING NOTES:
 1. WALLS TO RECEIVE SIDING REPAIR SHALL BE PAINTED IN THEIR ENTIRETY TO FIRST INSIDE OR OUTSIDE CORNER OR TRIM BREAK.
 2. WOOD SIDING UNDERLAYMENT REPAIR (30# BUILDING PAPER) SHALL EXTEND 6" UNDER AND 6" OVER EXISTING UNDERLAYMENT.

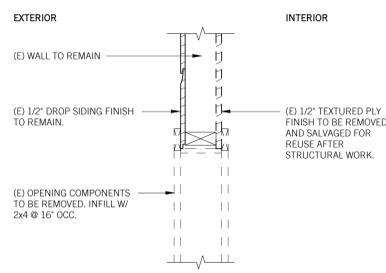

OPENING DEMO
 1 1/2" = 1'-0" 6

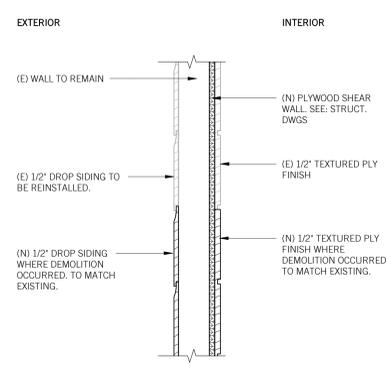


OPENING INFILL
 1 1/2" = 1'-0" 7

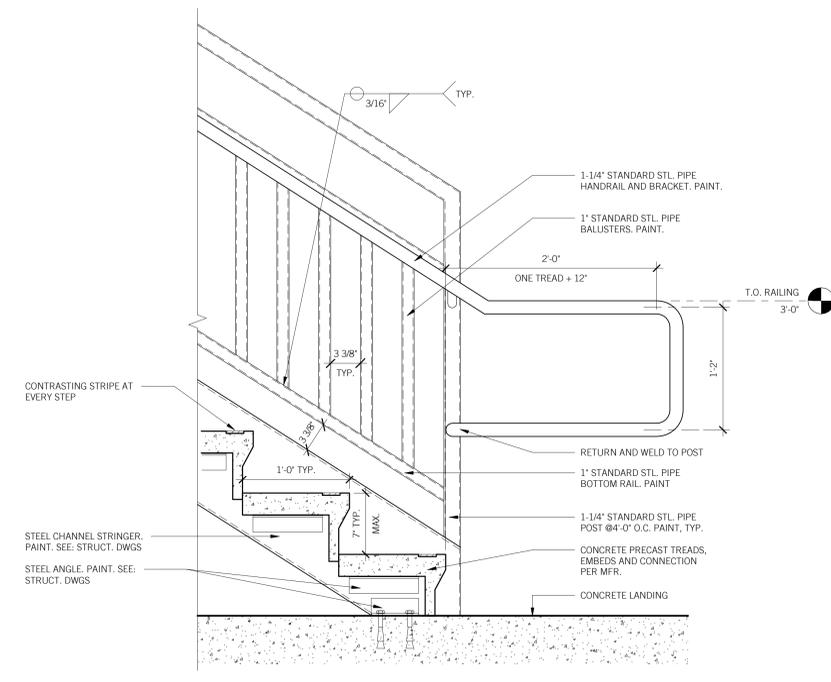


BOTTOM RUN HANDRAIL
 1 1/2" = 1'-0" 1

NOTES:
 1. INSTALL TREADS AND LANDINGS PER MFR'S. RECOMMENDATION.
 2. REFER TO STRUCTURAL DRAWINGS FOR ANY ADDITIONAL FRAMING NOT SHOWN ON THIS DETAIL.

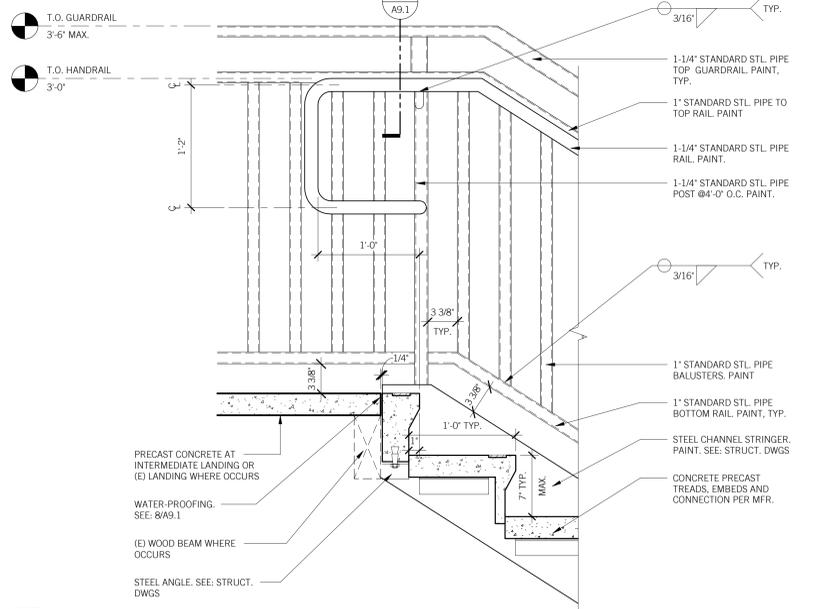

UPPER OR INT. HANDRAIL EXTENSION
 1 1/2" = 1'-0" 2

NOTES:
 1. INSTALL TREADS AND LANDINGS PER MFR'S. RECOMMENDATION.
 2. REFER TO STRUCTURAL DRAWINGS FOR ANY ADDITIONAL FRAMING NOT SHOWN ON THIS DETAIL.

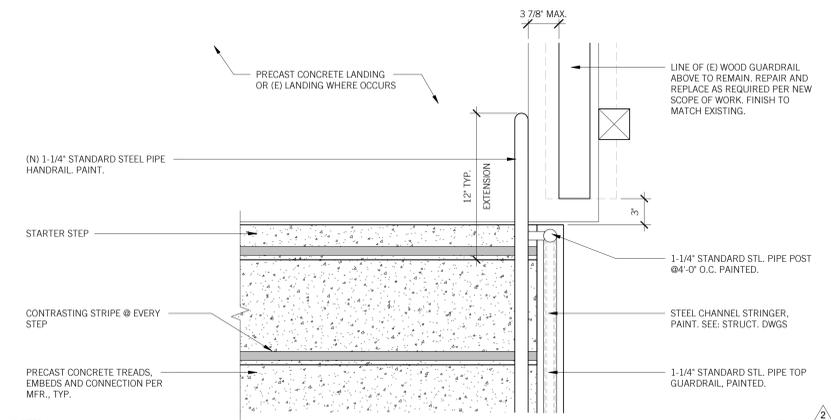

(N) STAIR TO (E) STAIR TRANSITION
 1 1/2" = 1'-0" 3

NOTES:
 1. WHERE REQUIRED PROVIDE NEW FLOOR JOIST AT STAIR FLIGHT AND LANDING TRANSITION

INSPECTIONS REQUIRED
 UC RIVERSIDE
 Office of Planning, Design & Construction
 Signed: *Robert K. Williams*
 Building, Safety and Compliance Division
 CAMPUS BUILDING PERMIT
 ALL WORK SHALL BE REVIEWED BY THE DESIGN PROFESSIONAL

APPROVED
 UC Riverside
 Planning, Design and Construction
 Campus Building Official
 Signature: *Robert K. Williams*
 Building & Safety Division
 Campus Building Permit

OFFICE OF THE STATE FIRE MARSHAL
 APPROVED FIRE AND PANIC ONLY
07/02/2019
 Approval of this plan does not authorize or approve any erection or alteration from applicable regulations. Final approval is subject to field inspection. One set of approved plans shall be available on the project site at all times.
 Reviewed by: *Heath Johnson*
 Fire and Life Safety Division/Chief

miyamoto.
 ARCHITECT
 Member A, B, C
 1901 East Alhambra Avenue, Suite 100
 Santa Ana, CA 92705
 T: (949) 570-1770
 M: (949) 401-1100
 miyamotointernational.com

Formillus
 ARCHITECTURE
 Building relationships. transforming environments.
 3080 12th Street, Suite 105
 Riverside, California 92507
 O: 951.530.8278
 E: info@formillus.com
 W: formillus.com


UNIVERSITY OF CALIFORNIA, RIVERSIDE
FALKIRK SITE AND SEISMIC IMPROVEMENTS - SUMMER 2019
 3429 CANYON CREST DRIVE
 RIVERSIDE, CA 92507

REVISIONS


ADDENDUM 1	01/18
ADDENDUM 2	02/18

UCR PROJECT #: 956390
 UCR CAAN #: P5673
 DATE: 06-28-2019
 DRAWN: LR



EXTERIOR DETAILS
A9.2

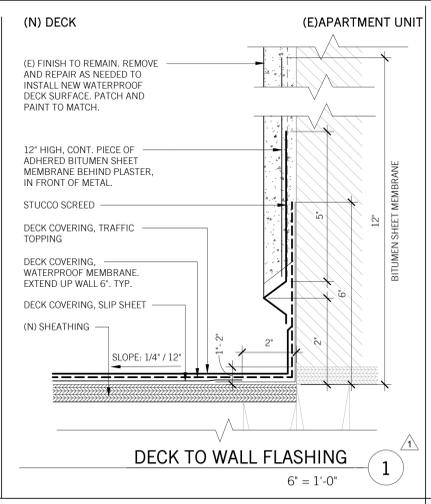


DECK TO WALL FLASHING 1
6" = 1'-0"

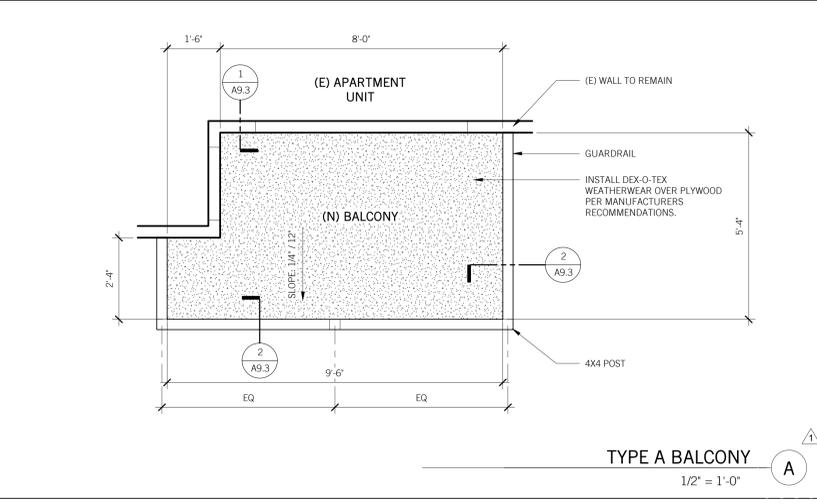


TYPE A BALCONY A
1/2" = 1'-0"

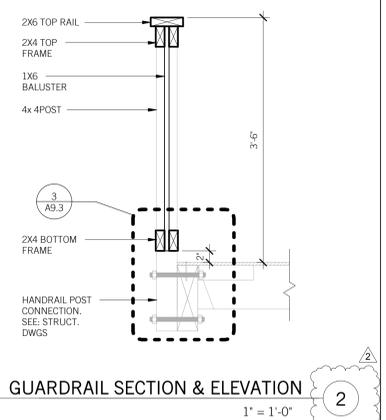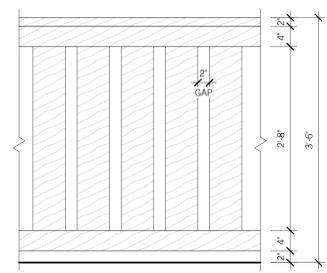


GUARDRAIL SECTION & ELEVATION 2
1" = 1'-0"

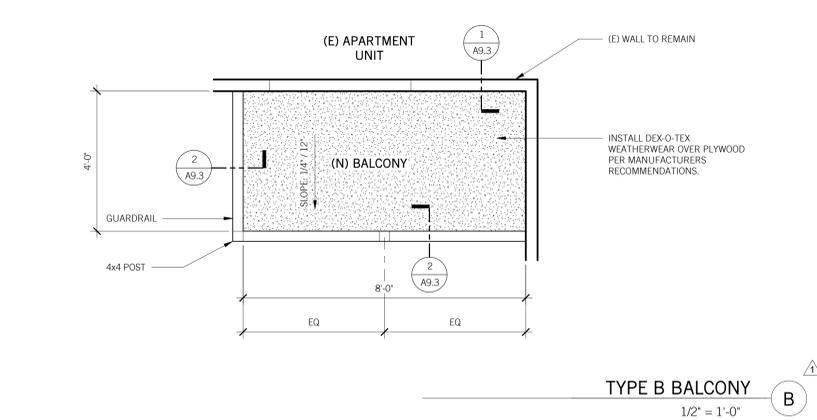


TYPE B BALCONY B
1/2" = 1'-0"

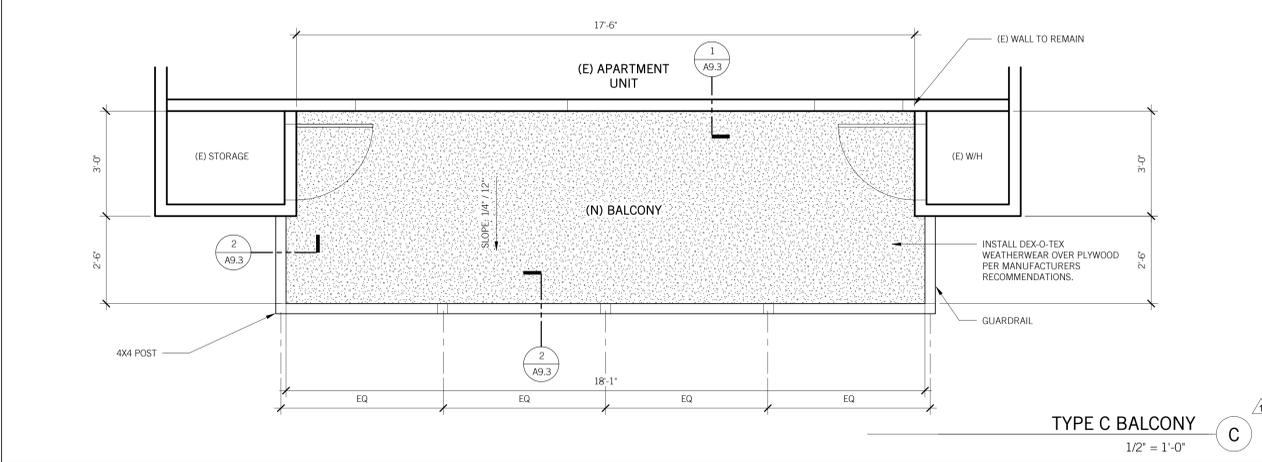

TYPE C BALCONY C
1/2" = 1'-0"

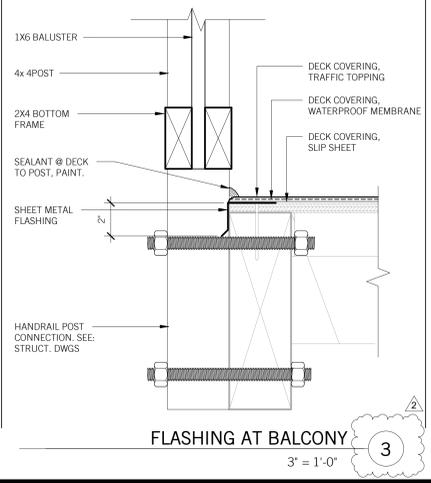

FLASHING AT BALCONY 3
3" = 1'-0"

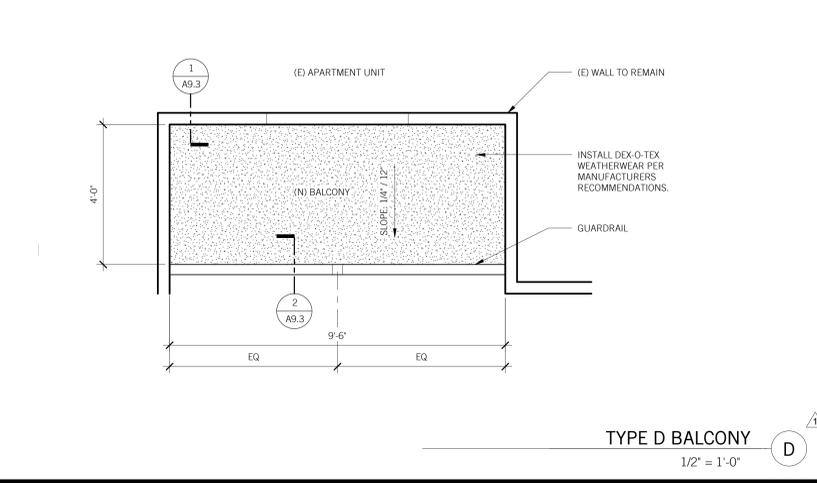

TYPE D BALCONY D
1/2" = 1'-0"

KEYNOTES 00.00

miyamoto.
ARCHITECT
Member A, B, C
1901 East Alhambra Avenue, Suite 100
Santa Ana, CA 92705
T: (949) 579-1170
M: (949) 401-1100
miyamotointernational.com

Formillus
ARCHITECTURE
Building relationships. Transforming environments.
3080 12th Street, Suite 105
Riverside, California 92507
O: 951.530.8778
E: info@formillus.com
W: formillus.com

UNIVERSITY OF CALIFORNIA, RIVERSIDE
FALKIRK SITE AND SEISMIC IMPROVEMENTS - SUMMER 2019
3429 CANYON CREST DRIVE
RIVERSIDE, CA 92507

REVISIONS	
ADDENDUM 1	01/18
ADDENDUM 2	02/18

UCR PROJECT #: 956390
UCR CAAN #: P5673
DATE: 06-28-2019
DRAWN: LR

ENLARGED BALCONY PLANS & DETAILS
A9.3

INSPECTIONS REQUIRED
UC RIVERSIDE
Office of Planning, Design & Construction
Signed: **Blair S. Bell**
Building, Safety and Compliance Division
CAMPUS BUILDING PERMIT
ALL WORK SHALL BE IN ACCORDANCE WITH THE 2019 CALIFORNIA BUILDING CODE

APPROVED
UC Riverside
Planning, Design and Construction
Campus Building Official
Signature: **Robert K. Williams**
Building & Safety Division
Campus Building Permit

OFFICE OF THE STATE FIRE MARSHAL
APPROVED FIRE AND PANIC ONLY
07/02/2019
Approval of this plan does not authorize or approve any erosion or rebar from applicable regulations. Final approval is subject to field inspection. One set of approved plans shall be available on the project site at all times.
Reviewed by: *[Signature]*
Fire and Life Safety Division

GENERAL NOTES
1. ALL MATERIALS AND WORKMANSHIP SHALL CONFORM TO THE LATEST CALIFORNIA CODE OF REGULATIONS (CCR), NATIONAL ELECTRICAL CODE EDITION AND ALL APPLICABLE LOCAL CODES AND REGULATIONS.

ABBREVIATIONS
A AMPERE
AFF ABOVE FINISHED FLOOR
AFG ABOVE FINISHED GRADE
AFU AMPERE FUSE RATING (FUSE)

POWER LEGEND AND SYMBOLS
SYMBOL DESCRIPTION
(200-D) CONDUIT WIRING DESCRIPTION PER FEEDER SCHEDULE ON OTHER PLAN

GENERAL DEMOLITION NOTES
1. THE DEMOLITION NOTE REFERENCE PERTAIN TO ALL RELATED SHEETS WHERE EXISTING ELECTRICAL WORK IS INDICATED.

POWER LEGEND AND SYMBOLS
SYMBOL DESCRIPTION
DUPLX RECEPTACLE OUTLET, CONVENIENCE (20 AMPS, 125 VOLTS) MOUNTED +15" A.F.F. TO BOTTOM OF DEVICE U.O.N.

GENERAL NOTES (continued)
25. CONDUCTORS SHALL HAVE UNDERWRITERS LABORATORIES, INC. (UL) LISTED, 600 VOLT INSULATION OF TYPE SPECIFIED BELOW OR ELSEWHERE IN THE SPECIFICATIONS.

ABBREVIATIONS (continued)
4W FOUR-WIRE
3W THREE-WIRE
JUNCTION BOX (4 1/16" SQUARED X 2 1/8" DEEP)

APPLICABLE CODES
1. 2016 BUILDING STANDARDS ADMINISTRATIVE CODE, PART 1, TITLE 24 C.C.R.
2. 2016 CALIFORNIA BUILDING CODE (CBC), PART 2, TITLE 24 C.C.R. (IBC WITH AMENDMENTS)

NOTE TO CONTRACTOR
DO NOT SCALE DRAWINGS
CONTRACTOR SHALL VERIFY PLANS AND EXISTING DIMENSIONS AND CONDITIONS ON THE JOB SITE AND SHALL IMMEDIATELY NOTIFY THE ARCHITECT IN WRITING OF ANY DISCREPANCIES BEFORE PROCEEDING WITH THE WORK OR BE RESPONSIBLE FOR THE SAME.

INSPECTIONS REQUIRED
APPROVED
UC Riverside
Planning, Design and Construction
Campus Building Official
Signature: Robert K. Williams
Building & Safety Division
Building & Safety Division
Campus Building Permit

PROJECT: 2019-01-07 FALKIRK AND SEISMIC IMPROVEMENTS BY ERNST&YOUNG 2019-02-28 SAMUEL JEA

MIYAMOTO INTERNATIONAL, INC. HEREBY EXPRESSLY RESERVES ITS COMMON LAW COPYRIGHT AND OTHER PROPERTY RIGHTS IN THESE PLANS. THESE PLANS AND DRAWINGS ARE NOT TO BE REPRODUCED, CHANGED OR COPIED IN ANY FORM OR MANNER WHATSOEVER WITHOUT FIRST OBTAINING THE EXPRESS WRITTEN PERMISSION OF MIYAMOTO INTERNATIONAL, INC. NOR ARE THEY TO BE ASSIGNED TO ANY THIRD PARTY WITHOUT FIRST OBTAINING WRITTEN PERMISSION AND CONSENT.

miyamoto.
UNIVERSITY OF CALIFORNIA, RIVERSIDE
FALKIRK SITE AND SEISMIC IMPROVEMENTS - SUMMER 2019
3429 CANYON CREST DRIVE
RIVERSIDE, CA 92507
ELECTRICAL LEGENDS & NOTES
E-0.1

R:\PROJECTS\2019\19-07-FALKIRK\4.40-100-IMPROVEMENTS-BY-ELUNESCO-2019-08-SAMUEL-USA

LUMINAIRE SCHEDULE

TYPE	VOLTS	WATTAGE	LUMENS	LAMPS	MOUNTING	FIXTURE DESCRIPTION	MFR.	CATALOG #	NOTES	SYMBOL
S1	120	25	1476	LED 5000K	WALL	WALL MOUNT LED FIXTURE WITH INTEGRAL PHOTOELECTRIC CELL	LITHONIA LIGHTING	TWS LED P1 50K 120 PE		☼

LUMINAIRE SCHEDULE NOTES

- EQUALS SHALL BE CONSIDERED UPON SUBMITTAL REVIEW AND APPROVAL. PLEASE NOTE THAT IF AN ALTERNATE IS CONSIDERED:
 - THE CONTRACTOR IS COMPLETELY AND SOLELY RESPONSIBLE FOR ALL ASPECTS OF THE SUBSTITUTION INCLUDING UPDATING CONSTRUCTION DOCUMENTS, OBTAINING APPROVALS AND PERMITS FROM LOCAL AUTHORITY, AND COORDINATING WITH ALL TRADES TO ENSURE CHANGES TO AFFECTED BUILDING SYSTEM ARE ACCOUNTED FOR AND ACCEPTABLE TO THE ENGINEERING TEAM. CONTRACTOR SHALL ENSURE SUBSTITUTED EQUIPMENT MEETS OR EXCEEDS DESIGN INTENT REGARDING RATINGS, PERFORMANCE, DIMENSIONAL CLEARANCES, PHYSICAL DIMENSIONS (MAX/MIN), WEIGHT LIMITATIONS, AND OTHER ASPECTS, PROVING SUBSTITUTION IS SUITABLE TO THE APPLICATION. ENGINEERS WILL REVIEW THE RATING AND PERFORMANCE OF SUBSTITUTED EQUIPMENT ONLY AND WILL NOT ASSUME RESPONSIBILITY FOR SUBSTITUTION AT ANY LEVEL.
 - IF CONTRACTOR CANNOT MAKE SUBSTITUTED EQUIPMENT WORK IN THIS PROJECT, CONTRACTOR SHALL REVERT TO REQUIREMENTS OF PERMITTED CONSTRUCTION DOCUMENTS AT THEIR EXPENSE.
 - IT IS UNDERSTOOD BY ALL PARTIES THAT ANY SUBSTITUTIONS OF SPECIFIED PRODUCTS ARE DONE FOR THE PURPOSE OF COST SAVINGS TO THE OWNER. THEREFORE, ANY MATERIAL SUBSTITUTION OR DEVIATIONS PROPOSED BY THE CONTRACTOR SHALL BE INCLUDED WITH THE INITIAL BID AND SHALL SHOW A LINE ITEMS CREDIT TO THE OWNER FOR EACH SUBSTITUTION IN LIEU OF SPECIFIED PRODUCTS.
- THE FIXTURE SCHEDULE INDICATES GENERAL DESCRIPTION OF LIGHTING FIXTURES AND MANUFACTURERS CATALOG NUMBERS. IT SHALL BE THE CONTRACTORS RESPONSIBILITY TO DETERMINE THE CORRECT CEILING CONFIGURATION AND PROVIDE THE FIXTURES WITH ALL NECESSARY TRIMS AND MOUNTING HARDWARE SO THAT BOTH THE CEILING SYSTEM AND THE FIXTURE CONSTRUCTION MATCHES. PROVIDE SEISMIC HANGERS AS REQUIRED.
- IT SHALL BE CONTRACTORS RESPONSIBILITY TO VERIFY THE EXACT LOCATION OF ALL LIGHTING FIXTURES AND TYPE OF CEILING WITH ARCHITECTURAL REFLECTED CEILING PLAN PRIOR TO ANY WORK. SEE ARCHITECTURAL REFLECTED CEILING PLAN PRIOR TO ANY WORK.
- A JUNCTION BOX MUST BE PROVIDED WITH ALL EXIT LIGHTS CONNECTED TO MORE THAN ONE SET OF CONDUCTORS UNLESS THE EXIT LIGHT FIXTURE IS FURNISHED WITH AN APPROVED OUTLET BOX FOR THROUGH WIRING.
- A COMPLETE TITLE 24 COMPLIANT LIGHTING CONTROL SYSTEM SHALL BE PROVIDED TO CONTROL ALL INTERIOR AND EXTERIOR LIGHTING SYSTEMS. REFER TO LIGHTING CONTROL DIAGRAMS, SCHEDULES AND DETAILS.
- BATTERY PACK EMERGENCY TEST SWITCHES SHALL BE INTEGRAL TO LIGHT FIXTURE. COORDINATION OF SWITCH LOCATION IS REQUIRED WITH DESIGN TEAM IF INTEGRAL INSTALLATION IS NOT POSSIBLE.
- FIXTURES DESIGNATED AS EMERGENCY SHALL BE SUPPLIED WITH INTEGRAL BATTERY PACK CAPABLE OF POWERING TWO TO TEN LAMPS FOR 90 MINUTES WITH A TOTAL LIGHT OUTPUT OF 1100 LUMENS OR ONE F13 BIAx FOR 90 MINUTES WITH A TOTAL LIGHT OUTPUT OF 520 LUMENS.
- PROVIDE ALL REQUIRED MOUNTING HARDWARE ANCHORAGE AND SUPPORTS TO INSTALL LIGHTING FIXTURES.
- PROVIDE SWIVEL BASE AND STEM. LENGTHS AS REQUIRED TO MOUNT THE PENDANT MOUNTED FIXTURES. THE INSTALLATION SHALL COMPLY WITH TITLE 24 SEISMIC AND APPLICABLE UBC REQUIREMENTS.
- THE CONTRACTOR SHALL PROVIDE A COMPLETE AND OPERABLE LIGHTING SYSTEM AS PART OF THIS BUILDING CONTRACT.
- SUSPENSION SYSTEM FOR LIGHT FIXTURES WHICH HAVE PASSED SHAKING TABLE TESTS APPROVED BY THE OFFICE OF THE STATE OF ARCHITECT, OR WHICH, AS INSTALLED, ARE FREE TO SWING A MINIMUM OF 45 FROM THE VERTICAL IN ALL DIRECTIONS WITHOUT CONTACTING OBSTRUCTIONS SHALL BE ASSUMED TO COMPLY WITH THE LATERAL FORCE REQUIREMENTS FOR SECTION 2305, PART 2, TITLE 24, CCR, UNLESS OF THE CABLE TYPE FREE SWING SUSPENSION SYSTEM SHALL HAVE A SAFETY WIRE OR CABLE ATTACHED TO THE FIXTURE AND STRUCTURE AT EACH SUPPORT CAPABLE OF SUPPORTING FOUR TIMES THE SUPPORTED LOAD.
- FOR SUSPENDED AND SURFACE MOUNTED LIGHT FIXTURES, THE PRODUCT OF ICP NEED NOT EXCEED 12 FOR ANY VALUE OF 1.
- PROVIDE DISCONNECTING MEANS FOR ALL FLUORESCENT BALLASTS PER CEC 410.130(G).
- IT SHALL BE THE CONTRACTOR'S RESPONSIBILITY TO VERIFY THAT THE FIXTURE BALLAST OR DRIVER VOLTAGE MATCHES THE CIRCUIT VOLTAGE SUPPLYING FIXTURE PRIOR TO ORDERING.
- IT SHALL BE THE CONTRACTOR'S RESPONSIBILITY TO VERIFY BALLAST/DRIVER DIMMING CONFIGURATION IS COMPATIBLE WITH CONTROLS BEING PROVIDED PRIOR TO ORDERING FIXTURES. EX. 2 WIRE, 3 WIRE, 4 WIRE, 0-10V, CAT 5, ETC.
- LED LIGHT FIXTURES SHALL BE IN ACCORDANCE WITH IES, NFPA, UL, AS SHOWN ON THE DRAWINGS, AND AS SPECIFIED.
- LED LIGHT FIXTURES SHALL BE REDUCTION OF HAZARDOUS SUBSTANCES (ROHS)-COMPLIANT.
- LED DRIVERS SHALL INCLUDE THE FOLLOWING FEATURES UNLESS OTHERWISE INDICATED:
 - MINIMUM EFFICIENCY: 85% AT FULL LOAD.
 - MINIMUM OPERATING AMBIENT TEMPERATURE: -20 DEG C (-4 DEG F)
 - INPUT VOLTAGE: 120-277V (+/-10%) AT 60 HZ, UNLESS OTHERWISE INDICATED.
 - INTEGRAL SHORT CIRCUIT, OPEN CIRCUIT, AND OVERLOAD PROTECTION.
 - POWER FACTOR: >=0.95.
 - TOTAL HARMONIC DISTORTION: <=20%.
 - COMPLY WITH FCC 47 CFR PART 15.
- LED MODULES SHALL INCLUDE THE FOLLOWING FEATURES UNLESS OTHERWISE INDICATED:
 - COMPLY WITH IES LM-79 AND LM-80 REQUIREMENTS.
 - MINIMUM CRI 80 AND COLOR TEMPERATURE 4000K UNLESS OTHERWISE SPECIFIED IN LUMINAIRE SCHEDULE.
 - MINIMUM RATED LIFE: 50,000 HOURS PER IES L70.
 - LIGHT OUTPUT LUMENS AS INDICATED IN THE LUMINAIRE SCHEDULE.
- LED DOWNLIGHTS:
 - HOUSING, LED DRIVER, AND LED MODULE SHALL BE PRODUCTS OF THE SAME MANUFACTURER.
- LED TROFFERS:
 - LED DRIVERS, MODULES, AND REFLECTOR SHALL BE ACCESSIBLE, SERVICEABLE, AND REPLACEABLE FROM BELOW THE CEILING.
 - HOUSING, LED DRIVER, AND LED MODULE SHALL BE PRODUCTS OF THE SAME MANUFACTURER.
- ALL FIXTURES MOUNTED OUTDOORS SHALL BE UL LISTED FOR WET LOCATION.

miyamoto.
 1901 East Alhambra Avenue, Suite 100
 Santa Ana, CA 92705
 MI1904011.00
 T: (949) 579-1170
 miyamotointernational.com



721 W. Highland Ave., Suite #100
 San Bernardino, CA 92408
 Tel: 909.392.0700
 Fax: 909.392.0700
 Email: ccs@designwestengineering.com
DESIGN WEST ENGINEERING
 MECHANICAL • ELECTRICAL • ENERGY CONSULTANTS

UNIVERSITY OF CALIFORNIA, RIVERSIDE
FALKIRK SITE AND SEISMIC IMPROVEMENTS - SUMMER 2019
 3429 CANYON CREST DRIVE
 RIVERSIDE, CA 92507

REVISIONS

1	ADDENDUM 1	6/14/19
2	ADDENDUM 2	6/26/19


UCR PROJECT #: 956390
 UCR CAAN #: P5673
 DATE: 06-14-2019
 DRAWN: S.V

INSPECTIONS REQUIRED
 UC RIVERSIDE
 Office of Planning, Design & Construction
 Signed CBO: Robert K. Williams
 Building, Safety and Compliance Division
 CAMPUS BUILDING PERMIT
ALL WORKS MUST BE TRACKED TO COMPLY THE CE2008 PERMITS

APPROVED
 UC Riverside
 Planning, Design and Construction
 Campus Building Official
 Signature: Robert K. Williams
 Building & Safety Division
 Campus Building Permit

OFFICE OF THE STATE FIRE MARSHAL
 APPROVED FIRE AND PANIC ONLY
07/02/2019
 Approval of this plan does not authorize or approve any omission or deviation from applicable regulations. Final approval is subject to field inspection. One set of approved plans shall be available on the project site at all times.
 Reviewed by: *Heath Johnson*
 Fire and Life Safety Division Chief

LUMINAIRE SCHEDULE & NOTES
E-0.2

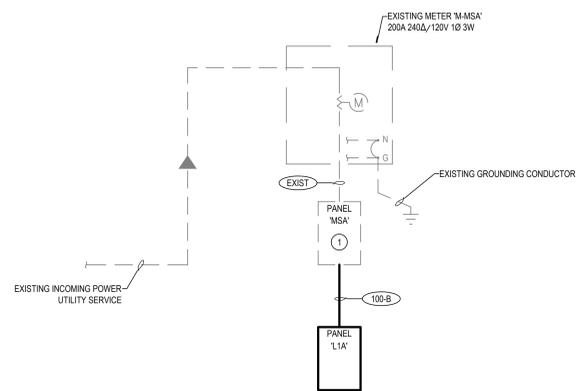

600V FEEDER SCHEDULE 1Ø 3W

LABEL	TYPE	SETS	PHASE	NEUTRAL	GROUND	CONDUIT
20-B	20A-3W	1	2#12	1#12	1#12	3/4"
30-B	30A-3W	1	2#10	1#10	1#10	3/4"
40-B	40A-3W	1	2#8	1#8	1#8	1"
50-B	50A-3W	1	2#6	1#6	1#6	1"
60-B	60A-3W	1	2#6	1#6	1#6	1"
70-B	70A-3W	1	2#4	1#4	1#8	1-1/4"
80-B	80A-3W	1	2#4	1#4	1#8	1-1/4"
90-B	90A-3W	1	2#2	1#2	1#8	1-1/4"
100-B	100A-3W	1	2#1	1#1	1#8	1-1/2"
125-B	125A-3W	1	2#1	1#1	1#6	1-1/2"
150-B	150A-3W	1	2#1/0	1#1/0	1#6	1-1/2"
175-B	175A-3W	1	2#2/0	1#2/0	1#6	2"
200-B	200A-3W	1	2#3/0	1#3/0	1#6	2"

NOTE:
ALL CONDUCTOR SIZES ARE BASED ON TYPE THIN COPPER CONDUCTOR UNLESS OTHERWISE NOTED. THE AMPACITY OF CONDUCTORS SHALL BE BASED ON THE TERMINALS NOT TO EXCEED 60°C FOR CONDUCTOR SIZE #14 THROUGH #1 AWG OR 75°C FOR CONDUCTOR SIZE OVER #1 AWG AS PER NEC 110.14(C).

600V FEEDER SCHEDULE 1Ø 2W

LABEL	TYPE	SETS	PHASE	NEUTRAL	GROUND	CONDUIT
20-S	20A-2W	1	2#12	N/A	1#12	3/4"
30-S	30A-2W	1	2#10	N/A	1#10	3/4"
40-S	40A-2W	1	2#8	N/A	1#8	1"
50-S	50A-2W	1	2#6	N/A	1#6	1"
60-S	60A-2W	1	2#6	N/A	1#6	1"
70-S	70A-2W	1	2#4	N/A	1#8	1-1/4"
80-S	80A-2W	1	2#4	N/A	1#8	1-1/4"
90-S	90A-2W	1	2#2	N/A	1#8	1-1/4"
100-S	100A-2W	1	2#1	N/A	1#8	1-1/4"
125-S	125A-2W	1	2#1	N/A	1#6	1-1/2"
150-S	150A-2W	1	2#1/0	N/A	1#6	1-1/2"
175-S	175A-2W	1	2#2/0	N/A	1#6	2"
200-S	200A-2W	1	2#3/0	N/A	1#6	2"

NOTE:
ALL CONDUCTOR SIZES ARE BASED ON TYPE THIN COPPER CONDUCTOR UNLESS OTHERWISE NOTED. THE AMPACITY OF CONDUCTORS SHALL BE BASED ON THE TERMINALS NOT TO EXCEED 60°C FOR CONDUCTOR SIZE #14 THROUGH #1 AWG OR 75°C FOR CONDUCTOR SIZE OVER #1 AWG AS PER NEC 110.14(C).

GENERAL NOTES

- REFER TO 'GENERAL NOTES' ON ELECTRICAL LEGENDS AND NOTES SHEET FOR WIRING METHODS, MATERIALS, AND REQUIREMENTS.
- ALL CIRCUIT BREAKERS, PANELBOARDS AND TRANSFORMERS SHALL BE OF THE SAME MANUFACTURER.
- ALL GROUND CONNECTIONS SHALL BE CADWELD.
- AVAILABLE FAULT AT SERVICE POINT SHALL BE CONSIDERED AT 65,000 RMS SYM.
- ALL PANELBOARDS SHALL BE FULLY RATED FOR THE AVAILABLE FAULT UNLESS OTHERWISE NOTED.
- WHEN APPLICABLE, OVERCURRENT DEVICE ENCLOSURES SHALL BE IDENTIFIED AS SERIES RATED AND LABELED IN ACCORDANCE WITH NEC 110.22. THE OVERCURRENT DEVICES SHALL BE AIC RATED PER MANUFACTURER LABELING OF THE ELECTRICAL EQUIPMENT.
- THE FEEDER LENGTHS SHOWN ON THESE DRAWINGS ARE FOR CALCULATION PURPOSES ONLY AND ARE NOT VALID FOR BIDDING.
- CONTRACTOR SHALL UPDATE ALL MODIFIED PANEL DIRECTORIES OR CREATE A NEW TYPED DIRECTORY IF ONE DOES NOT EXIST. IDENTIFYING EACH CIRCUIT AND INSTALLED CIRCUIT LOADS. MOUNTED IN GLASS OR PLASTIC INSIDE DOOR. THE CONTRACTOR SHALL BE RESPONSIBLE FOR UPDATING DIRECTORIES TO INDICATE ALL NEW CIRCUITS AND ACTUAL AREA SERVED WHICH IS NOT NECESSARILY THE DESCRIPTION INDICATED ON THE BID DOCUMENTS. USE A COMPUTER OR TYPEWRITER TO CREATE DIRECTORY; HANDWRITTEN DIRECTORIES ARE NOT ACCEPTABLE.

miyamoto.
 1901 East Alhambra Avenue, Suite 100
 Santa Ana, CA 92705
 Tel: (949) 579-1770
 myamotointernational.com



DESIGN WEST ENGINEERING
 MECHANICAL • ELECTRICAL • ENERGY CONSULTANTS
 221 W. Hollywood Blvd, Suite #100
 San Bernardino, CA 92408
 Tel: (909) 392-0700
 Fax: (909) 392-0700
 Email: cws@designwesteng.com

SINGLE LINE DIAGRAM 1

CONSTRUCTION NOTES

- REMOVE (3) SINGLE POLE BREAKERS FROM EXISTING PANEL AND REFEED FROM NEW L1A PANEL.

MOUNTING: SURFACE										PANEL L1A (NEW)										VOLTAGE: 120/240V 1PH 3W									
FED FROM: MSA										LOCATION: LAUNDRY ROOM										BUS: 100 A									
NEMA: 1																				MAIN: 100 A									
AIC RATING: 10,000																				FEEDER: 100-B									
NOTE	DESCRIPTION	A	B	TYPE	POLE	AMP	AWG/PH	LENGTH	V.D. %	PHASE	V.D. %	LENGTH	AWG/PH	AMP	POLE	TYPE	A	B	DESCRIPTION	NOTE									
	SPARE			1	20					1	A	2	0.67	80	#12	20	1	N	300		REMOTE POWER SUPPLY								
	SPARE			1	20					3	B	4	0.83	100	#12	20	1	N	300		REMOTE POWER SUPPLY								
	SPARE			1	20					5	A	6	1.00	120	#12	20	1	N	300		REMOTE POWER SUPPLY								
	SPARE			1	20					7	B	8				20	1	N			SPARE								
	SPARE			1	20					9	A	10				20	1	N			SPARE								
	SPARE			1	20					11	B	12				20	1	N			SPARE								
	SPARE			1	20					13	A	14				20	1	N			SPARE								
	SPARE			1	20					15	B	16				20	1	N			SPARE								
	SPARE			1	20					17	A	18				20	1	N			SPARE								
	SPARE			1	20					19	B	20				20	1	N			SPARE								
	SPARE			1	20					21	A	22				20	1	N			SPARE								
	SPARE			1	20					23	B	24				20	1	N			SPARE								
	SUBTOTALS: 0 0 600 300																												
CEC LOAD CALC:		CONNECTED	DEM.	DEM.	DEMAND	SUBTOTALS:		PHASE	NOTES:																				
LOAD TYPE	VA	F.ACT.	VA	AMPS	600 VA		A																						
(L) LIGHTING	0	1.25	0	0	300 VA		B																						
(R) RECEPTACLE	0	220.44	0	0	900 VA		TOTAL																						
(M) MOTOR	0	1.25	0	0	4		AMPS																						
LARGEST MOTOR	0	0.25	0	0																									
(C) CONTINUOUS	0	1.25	0	0																									
(N) NON-CONTINUOUS	900	1.00	900	4																									
(K) KITCHEN (NEC 220.56)	0	0.65	0	0																									
(S) SPECIAL DEMAND	0	1.00	0	0																									
TOTALS	900		900																										
TOTAL AMPS CONNECTED AT 120/208V 1PH 3W WITH LCL				4 A																									

UNIVERSITY OF CALIFORNIA, RIVERSIDE
FALKIRK SITE AND SEISMIC IMPROVEMENTS - SUMMER 2019
 3429 CANYON CREST DRIVE
 RIVERSIDE, CA 92507

REVISIONS

1	ADDENDUM 1	6/14/19
2	ADDENDUM 2	6/26/19

UCR PROJECT #: 956390
 UCR CAAN #: P5673
 DATE: 06-14-2019
 DRAWN: S.V


PANEL SCHEDULE 2

INSPECTIONS REQUIRED
 UC RIVERSIDE
 Office of Planning, Design & Construction
 Signed: *Robert K. Williams*
 Building, Safety and Compliance Division
 CAMPUS BUILDING PERMIT
 ALL INFORMATION IS TO BE USED FOR THE DESIGN AND CONSTRUCTION OF THE PROJECT.

APPROVED
 UC Riverside
 Planning, Design and Construction
 Campus Building Official
 Signature: *Robert K. Williams*
 Building & Safety Division
 Campus Building Permit

OFFICE OF THE STATE FIRE MARSHAL
 APPROVED FIRE AND PANIC ONLY
07/02/2019
 Approval of this plan does not authorize or approve any emission or deviation from applicable regulations. Final approval is subject to field inspection. One set of approved plans shall be available on the project site at all times.
 Reviewed by: *Heath Johnson*
 Fire and Life Safety Division

SINGLE LINE DIAGRAM & PANEL SCHEDULES
E-0.3

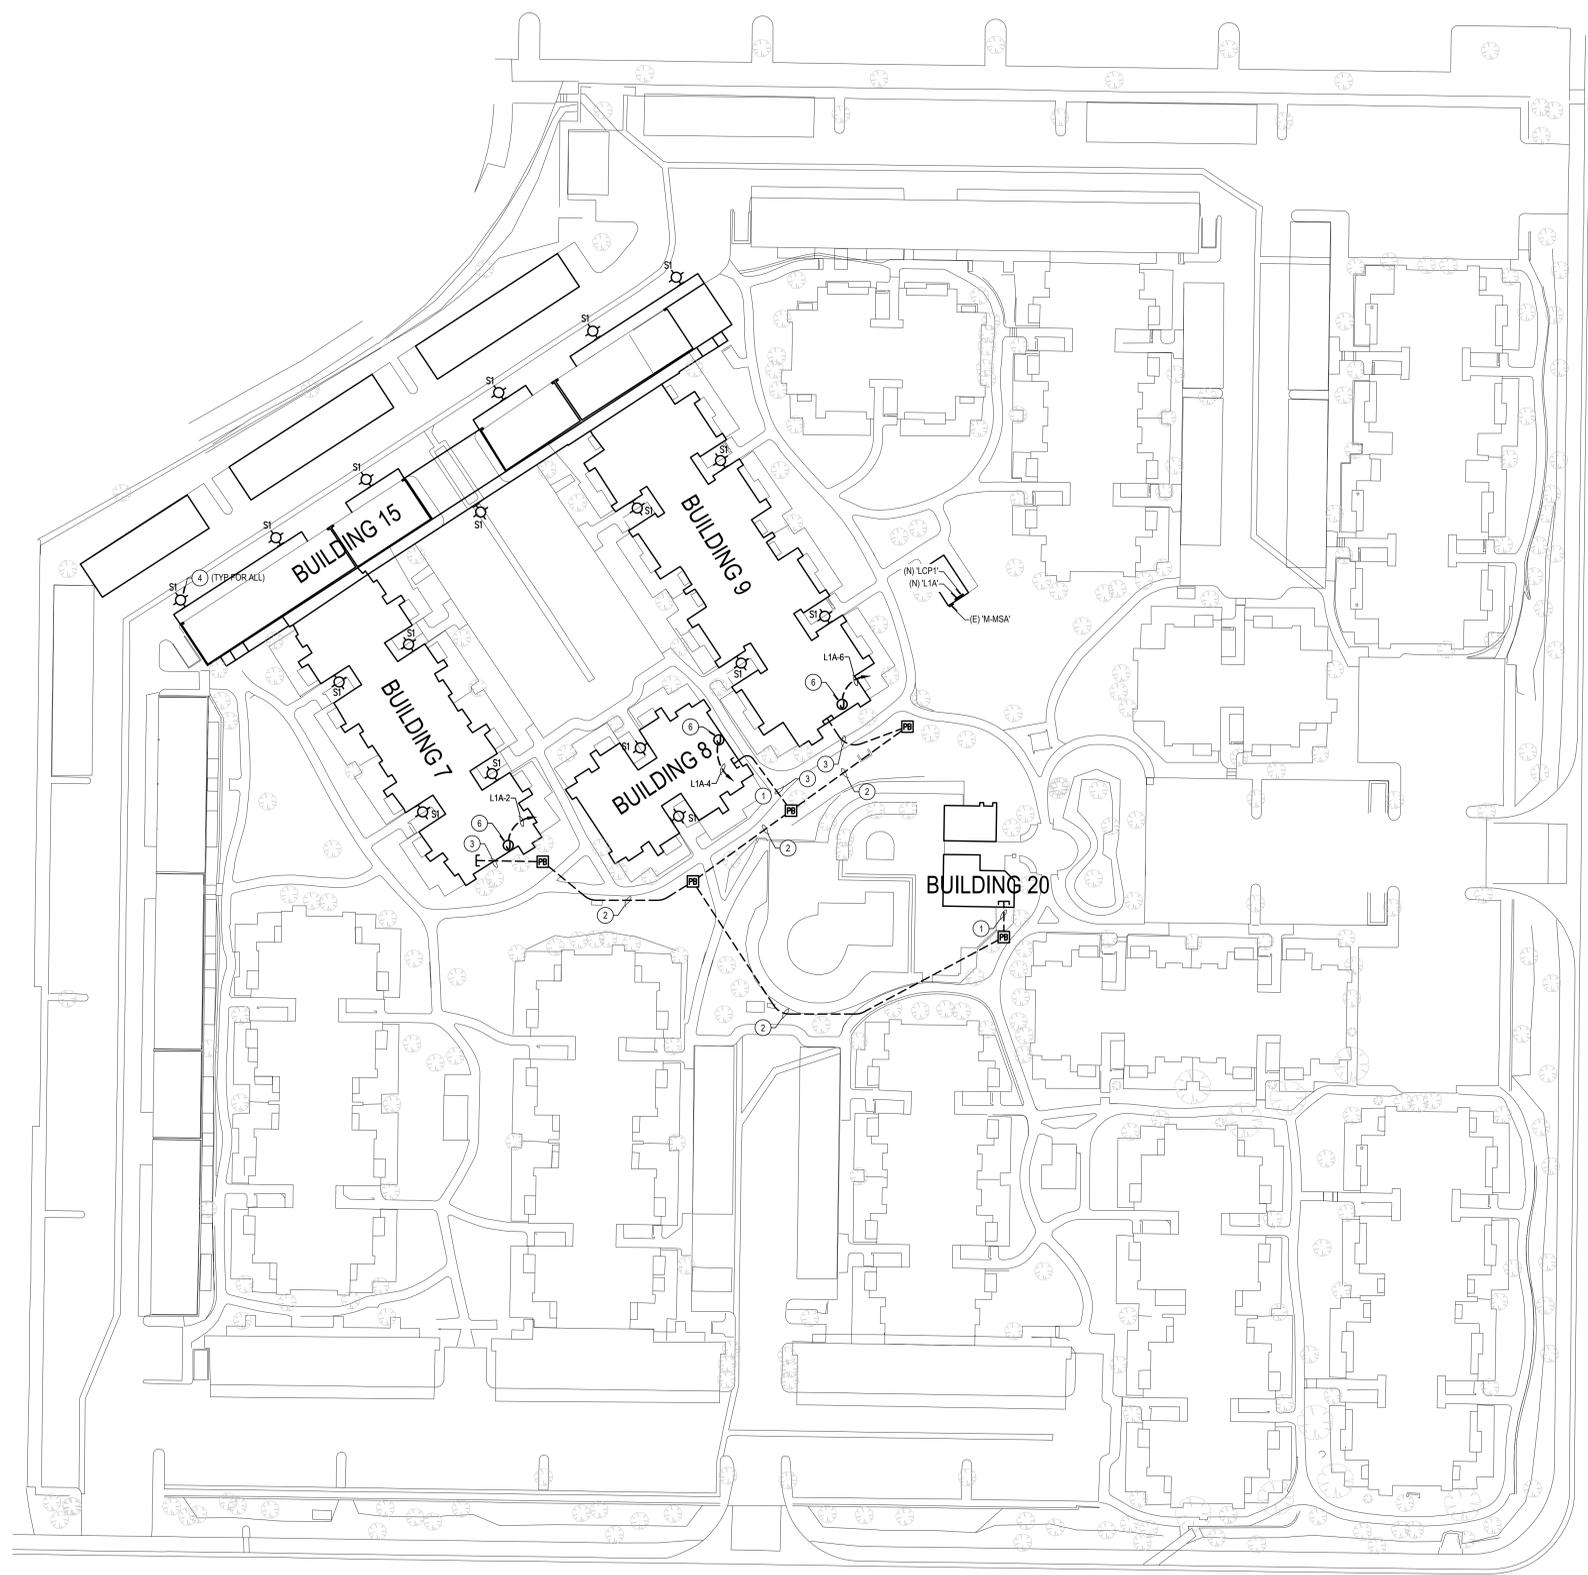

GENERAL NOTES

1. THE CONTRACTOR SHALL INSPECT AND VERIFY ALL FIELD CONDITIONS PRIOR TO INSTALLATION.
2. COORDINATE TRENCH ROUTING AND EQUIPMENT LOCATIONS WITH EXISTING CONDITIONS AND NEW WORK.
3. ALL SITE BRANCH CIRCUIT WIRING SHALL BE #10 AWG. OR LARGER.
4. SITE CONDUIT LAYOUT IS DIAGRAMMATICAL ONLY. CONTRACTOR SHALL USE SHORTEST DISTANCE POSSIBLE FOR TRENCHING PURPOSES.
5. FIRE ALARM CONDUIT SHALL HAVE NO MORE THAN (2) 90 DEGREE BENDS OR A TOTAL OF 180 DEGREES BETWEEN PULL BOX INSTALLATION.

CONSTRUCTION NOTES

1. STUB (2) 2" C.O. INTO MULTI PURPOSE ROOM'S FIRE ALARM PANEL LOCATION. REFERENCE FIRE ALARM DRAWINGS FOR EXACT LOCATION.
2. (2) 2" C.O. FOR FIRE ALARM WIRING. REFERENCE FIRE ALARM DRAWINGS FOR EXACT WIRING REQUIREMENTS.
3. STUB (2) 2" C.O. INTO EXISTING ELECTRICAL CLOSET. STUB CONDUIT IN CLOSE PROXIMITY TO NEW REMOTE FIRE ALARM POWER SUPPLY. REFERENCE FIRE ALARM DRAWINGS FOR EXACT LOCATION.
4. REPLACE EXISTING WALLPACKS WITH NEW LED WALLPACKS WITH INTEGRAL PHOTOCELL CONTROLS.
5. NOT USED.
6. PROVIDE 120V POWER FOR FIRE ALARM REMOTE POWER SUPPLY. REFERENCE FIRE ALARM DRAWINGS FOR EXACT LOCATION.

miyamoto.
 1901 East Alhambra Avenue, Suite 100
 Santa Ana, CA 92705
 MI904011.00
 T: (949) 579-1170
 miyamotointernational.com



221 W. Houghshy Lane, Suite #100
 San Bernardino, CA 92408
 POC: (909) 393-0700
 Email: ccs@designwesteng.com
DESIGN WEST ENGINEERING
 MECHANICAL • ELECTRICAL • ENERGY CONSULTANTS

UNIVERSITY OF CALIFORNIA, RIVERSIDE
 FALKIRK SITE AND SEISMIC IMPROVEMENTS - SUMMER 2019
 3429 CANYON CREST DRIVE
 RIVERSIDE, CA 92507

REVISIONS	ADDENDUM	DATE
1	ADDENDUM 1	6/14/19
2	ADDENDUM 2	6/28/19

UCR PROJECT #: 956390
 UCR CAAN #: P5673
 DATE: 06-14-2019
 DRAWN: S.V

ELECTRICAL SITE PLAN
E-1.0

INSPECTIONS REQUIRED
 UC RIVERSIDE
 Office of Planning, Design & Construction
 Signed CBO: Blair S. Reardon
 Building, Safety and Compliance Division
 CAMPUS BUILDING PERMIT
 All work shall be in accordance with the California Building Code.

APPROVED
 UC Riverside
 Planning, Design and Construction
 Campus Building Official
 Signature: Robert K. Williams
 Building & Safety Division
 Campus Building Permit

OFFICE OF THE STATE FIRE MARSHAL
 APPROVED FIRE AND PANIC ONLY
07/02/2019
 Approval of this plan does not authorize or approve any emission or deviation from applicable regulations. Final approval is subject to field inspection. One set of approved plans shall be available on the project site at all times.
 Reviewed by: *Heath Johnson*
 Fire and Life Safety Division

ELECTRICAL SITE PLAN SCALE: 1/8" = 1'-0" 1

PL PROJECT 2019 05 07 FALKIRK AND ADA IMPROVEMENTS BY E. SUTER W. 2019 06 20 - SAMUEL BEA

STRUCTURAL OBSERVATIONS

- 1. VISUAL OBSERVATIONS WILL BE PERFORMED AT THE DISCRETION OF THE OWNER, ARCHITECT, EOR, AND AS REQUIRED BY THE BUILDING OFFICIAL... 2. IT IS THE RESPONSIBILITY OF THE GENERAL CONTRACTOR TO NOTIFY THE EOR AS TO WHEN EACH MAJOR PHASE OF CONSTRUCTION IS READY FOR OBSERVATION... 3. THE FOLLOWING MAJOR PHASES OF CONSTRUCTION REQUIRE A SITE VISIT AND STRUCTURAL OBSERVATION REPORT FROM THE SEOR...

SHEAR WALL SCHEDULE NOTES

- 1. INTERMEDIATE NAILING SHALL BE 16@ 12"OC. 2. FRAMING, INCLUDING BLOCKING, AT ADJOINING PANEL EDGES SHALL BE 3x MIN AND NAILS SHALL BE STAGGERED WHERE SHEARWALL CAPACITY PER SHEAR WALL SCHEDULE EXCEEDS 330 PLF... 4. USE OF MACHINE NAILING IS SUBJECT TO APPROVAL BY THE PROJECT STRUCTURAL ENGINEER... 5. NO PANEL LESS THAN 12" WIDE SHALL BE USED IN VERTICAL PLYWOOD SHEAR WALLS...

NAILING SCHEDULE

(UNLESS OTHERWISE NOTED ON PLANS) COMMON NAILS SHALL BE USED FOR NAILING AT TYPICAL CONNECTIONS NOTED BELOW (UNO).

Table with columns: CONNECTION, NAILING, and (B) REF. Lists various connections like JOISTS TO SILL OR GIRDER, TOENAIL, BRIDGING TO JOIST, etc., with corresponding nail types and references.

Table titled 'NAIL SCHEDULE (COMMON NAILS)' with columns: SIZE, DIAMETER (IN), LENGTH (IN). Lists sizes from 8d to 20d.

STATEMENT OF SPECIAL INSPECTIONS

- 1. THE OWNER SHALL EMPLOY ONE OR MORE SPECIAL INSPECTORS TO SUPERVISE INSPECTIONS DURING CONSTRUCTION... 2. SPECIAL INSPECTIONS ARE NOT REQUIRED WHERE THE WORK IS DONE ON THE PREMISES OF A FABRICATOR REGISTERED AND APPROVED TO PERFORM SUCH WORK WITHOUT SPECIAL INSPECTION... 3. ALL INSPECTIONS SHALL BE PERFORMED BY INDEPENDENT SPECIAL INSPECTORS...

STRUCTURAL CONCRETE

- PERIODIC: VERIFY USE OF REQUIRED DESIGN MIX. CONT: SAMPLING FRESH CONCRETE & PERFORMING SLUMP AND AIR CONTENT TESTS & DETERMINING THE TEMPERATURE OF FRESH CONCRETE AT THE TIME OF MAKING SPECIMENS FOR STRENGTH TESTS. PERIODIC: INSPECTION FOR CONCRETE AND SHOTCRETE PLACEMENT FOR PROPER APPLICATION TECHNIQUES...

ROUGH CARPENTRY / WOOD

- PERIODIC: NAILING, BOLTING, ANCHORING AND OTHER FASTENING OF ELEMENTS OF THE SEISMIC FORCE-RESISTING SYSTEM, INCLUDING WOOD SHEAR WALLS, DRAG STRUTS, BRACES, SHEAR PANELS AND HOLLOW CORE WALLS WHERE THE FASTENER SPACING OF THE SHEATHING IS 4 INCHES ON CENTER OR LESS. PERIODIC: INSPECTION OF HIGH-STRENGTH BOLTED BEARING-TYPE CONNECTIONS...

STRUCTURAL STEEL

- PERIODIC: HIGH-STRENGTH BOLTS, NUTS, AND WASHERS IDENTIFICATION MARKINGS TO CONFORM TO ASTM STANDARDS SPECIFIED IN THE APPROVED CONSTRUCTION DOCUMENTS. PERIODIC: INSPECTION OF SLIP-CRITICAL CONNECTIONS USING TURN-OF-NUT METHOD WITH MATCHMARKING, DIRECT TENSION INDICATOR METHOD, OR TWIST OFF BOLTS. CONT: INSPECTION OF SLIP-CRITICAL CONNECTIONS USING CALIBRATED WRENCH METHOD OR TURN-OF-NUT WITHOUT MATCHMARKING...

WELDS

- CONT: COMPLETE AND PARTIAL PENETRATION GROOVE WELDS. CONT: FILLET WELDS 5/16" AND MULTIPASS FILLET WELDS. PERIODIC: FILLET WELDS 5/16". PERIODIC: WELD FILLER MATERIAL IDENTIFICATION MARKINGS TO CONFORM TO AWS STANDARDS SPECIFIED IN THE APPROVED CONSTRUCTION DOCUMENTS...

POST-INSTALLED ANCHORS

- PERIODIC: UNLESS OTHERWISE NOTED ON THE DRAWINGS, THE FOLLOWING APPLY TO ALL POST-INSTALLED ANCHORS INTO HARDENED CONCRETE OR MASONRY WHICH INCLUDES TYPES SUCH AS EXPANSION, WEDGE, SLEEVE, ADHESIVE/EPoxy, SHOT-PISTON, SCREW AND UNDERCUT. 1. INSTALL PER THE MANUFACTURER'S PRINTED INSTALLATION INSTRUCTIONS (MPI) EXCEPT AS OTHERWISE STATED IN THE SPECIFIED PRODUCT REPORTS... 2. CLEAN OUT ANCHOR HOLES AND SET ANCHORS PER THE PRODUCTS ICC REPORT FOR THE APPROPRIATE CONDITIONS... 3. PROVIDE CARBON STEEL ANCHORS AT DRY INTERIOR LOCATIONS AND STAINLESS STEEL TYPE 304 OR 316 AT EXTERIOR, DAMP INTERIOR LOCATIONS...

ABBREVIATIONS

Table with multiple columns listing abbreviations for materials, components, and construction terms, such as AB ANCHOR BOLT, ADV ABOVE, ADDL ADDITIONAL, etc.

ROUGH CARPENTRY / WOOD

- 1. ALL GRADES SPECIFIED ARE MINIMUM GRADES REQUIRED. DOUGLAS FIR (DF) SHALL BE GRADED DURING CONSTRUCTION... 2. MOISTURE CONTENT OF SAWN LUMBER SHALL NOT EXCEED 19% WHEN FRAMING STARTS OR SHEATHING IS APPLIED... 3. ARCHITECTURALLY EXPOSED TIMBERS 4" NOMINAL IN THE LEAST DIMENSION SHALL NOT CONTAIN BOLD HEART... 4. WOOD MEMBERS SHALL BE PRESERVATIVE-TREATED (PT) OR NATURALLY DURABLE (WITH APPROVAL OF SEOR) WHERE EXPOSED TO WEATHER AND IN ACCORDANCE WITH CBC SECTION 2304.12...

STRUCTURAL STEEL

- 1. DESIGN, FABRICATION AND ERECTION OF STRUCTURAL STEEL SHALL CONFORM TO THE SPECIFICATIONS AND STANDARD OF THE AMERICAN INSTITUTE OF STEEL CONSTRUCTION (AISC), AS CONTAINED IN THE LATEST EDITION OF 'AISC MANUAL OF STEEL CONSTRUCTION'. 2. ALL STRUCTURAL STEEL SHALL BE ERRECTED PLUMB AND TRUE TO LINE... 3. WIDELINE SECTIONS & TEES, PLATES, ANGLES, CHANNELS, SQUARE OR RECTANGULAR HOLLOW STRUCTURAL SECTIONS (HSS). 4. PIPES. 5. MACHINE BOLTS (MB). 6. HIGH STRENGTH BOLTS (HSB). 7. WELDED HEADED STUDS. 8. THREADED RODS FOR ANCHOR BOLTS. 9. HIGH STRENGTH PLATE. 10. ALL STRUCTURAL STEEL AND MISCELLANEOUS STEEL PERMANENTLY EXPOSED TO THE ELEMENTS SHALL BE HOT DIP GALVANIZED...

HIGH-STRENGTH BOLTS

- 1. SEE STRUCTURAL STEEL NOTES THIS SHEET FOR ADDITIONAL INFORMATION. 2. JOINT ASSEMBLIES USING HIGH-STRENGTH BOLTS SHALL BE IN ACCORDANCE WITH THE CURRENT EDITION OF THE 'AISC (RCS)' SPECIFICATION FOR STRUCTURAL JOINTS USING HIGH-STRENGTH BOLTS'. 3. ALL HIGH-STRENGTH BOLTS SHALL CONFORM TO ASTM A325 OR ASTM A490, NUTS SHALL CONFORM TO ASTM A307 AND WASHERS SHALL CONFORM TO ASTM F436...

REINFORCING STEEL

- 1. REINFORCING GRADES FOR CONCRETE OR MASONRY: A. ALL BARS EXCEPT THOSE TO BE WELDED... B. TIES AND STIRRUPS... C. WELDED WIRE FABRIC... D. ALL BARS TO BE WELDED... 2. MAINTAIN MINIMUM CONCRETE COVER FROM FACE OF CONCRETE TO EDGE OF ALL REINFORCEMENT AS FOLLOWS (UNO). 3. REINFORCEMENT SHALL BE PLACED IN ACCORDANCE WITH THE CONCRETE REINFORCING STEEL INSTITUTE (CRS) 'MANUAL OF STANDARD PRACTICE'... 4. SPLICES IN CONTINUOUS REINFORCEMENT AS USED IN WALLS, WALL FOOTINGS, ETC... 5. ALL DOWELS, ANCHOR BOLTS AND OTHER HARDWARE TO BE SET IN CONCRETE SHALL BE TIED IN PLACE PRIOR TO PLACEMENT OF CONCRETE...

WELDING

- 1. WELDING PROCEDURES, ELECTRODES AND WELDER QUALIFICATIONS SHALL CONFORM TO THE 'CODE FOR WELDING IN BUILDING CONSTRUCTION', AMERICAN WELDING SOCIETY (AWS), D1.1 AND THE AISC 'SPECIFICATIONS FOR THE DESIGN, FABRICATION AND ERECTION OF STRUCTURAL STEEL FOR BUILDINGS'. 2. ALL WELDERS SHALL HAVE EVIDENCE OF PASSING THE AWS STANDARD QUALIFICATION TESTS... 3. PROJECT WELDING SHALL BE PERFORMED ONLY IN ACCORDANCE WITH WELDING PROCEDURE SPECIFICATIONS (WPS) SUBMITTED BY THE CONTRACTOR AND REVIEWED BY THE EOR AND PROJECT WELDING INSPECTOR... 4. WELDING OF STRUCTURAL STEEL SHALL BE PERFORMED PER AWS D1.1 USING E70XX ELECTRODES UNLESS OTHERWISE NOTED... 5. ALL FULL PENETRATION WELDS SHALL BE ULTRA-SONIC TESTED PER AWS D1.1 AND D1.8 REQUIREMENTS AS APPLICABLE... 6. ALL GROOVE OR BUTT WELDS SHALL COMPLETE PENETRATION WELDS, UNO, ALL EXPOSED BUTT WELDS SHALL BE GROUND SMOOTH... 7. ALL EXPOSED WELDS ON ARCHITECTUREALLY EXPOSED STRUCTURAL STEEL (AESS) SHALL COMPLY WITH AISC CODE OF STANDARD PRACTICE, SECTION 10... 8. FIELD WELDS HAVE BEEN INDICATED WHERE THEY ARE EXPECTED TO OCCUR... 9. THE SLAB ON GRADE IS NOT DESIGNED TO SUPPORT TRAFFIC FROM CRANES OR OTHER HEAVY CONSTRUCTION VEHICLES... 10. PRECAST CONCRETE STAIR TREADS... 11. DOWELS BETWEEN FOOTING AND WALLS OR COLUMNS SHALL BE THE SAME GRADE, SIZE AND SPACING AS THE MAIN REINFORCING UNO... 12. ALL SPACES SHALL BE MARKED SO THEIR IDENTIFICATION CAN BE MADE WHEN THE FINAL IN PLACE INSPECTION IS MADE... 13. SPLICES IN CONTINUOUS REINFORCEMENT AS USED IN WALLS, WALL FOOTINGS, ETC... 14. ALL DOWELS, ANCHOR BOLTS AND OTHER HARDWARE TO BE SET IN CONCRETE SHALL BE TIED IN PLACE PRIOR TO PLACEMENT OF CONCRETE... 15. WELDED WIRE FABRIC SHALL BE TIED IN PLACE PRIOR TO PLACEMENT OF CONCRETE... 16. BEND REINFORCING BARS COLD... 17. STEEL SHALL BE KEPT CLEAN AND FREE OF RUST... 18. DOWELS BETWEEN FOOTING AND WALLS OR COLUMNS SHALL BE THE SAME GRADE, SIZE AND SPACING AS THE MAIN REINFORCING UNO... 19. ALL SPACES SHALL BE MARKED SO THEIR IDENTIFICATION CAN BE MADE WHEN THE FINAL IN PLACE INSPECTION IS MADE... 20. SPLICES IN CONTINUOUS REINFORCEMENT AS USED IN WALLS, WALL FOOTINGS, ETC... 21. WHERE LONGITUDINAL REINFORCING BARS ARE PLACED IN 2 OR MORE LAYERS, BARS IN THE UPPER LAYERS SHALL BE PLACED DIRECTLY ABOVE BARS IN THE BOTTOM LAYER... 22. ALL BENDS WITH STIRRUPS, HOOPS, AND CROSSES-TIES SHALL ENGAGE A LONGITUDINAL BAR PROVIDE #4 SPACER BAR WHEN A LONGITUDINAL BAR IS NOT SPECIFICALLY DETAILLED... 23. WELDING OF REINFORCING BARS SHALL BE PERFORMED PER AMERICAN WELDING SOCIETY (AWS) D1.1 USING E70XX ELECTRODES FOR A615 REINFORCING AND E80XX ELECTRODES FOR A706 REINFORCING...









DEFERRED APPROVALS

- WHERE DEFERRED APPROVAL ITEMS ARE DESIGN-BUILD (OR BIDDER-DESIGNED), THE CONTRACTOR SHALL PROVIDE SHOP DRAWINGS AND CALCULATIONS THEREON REVIEWED AND SIGNED BY AN ENGINEER LICENSED IN THE STATE OF CALIFORNIA, SUBMITTAL DOCUMENTS FOR THE FOLLOWING DEFERRED APPROVAL ITEMS SHALL BE REVIEWED BY THE ARCHITECT OR ENGINEER OF RECORD AND THEN SUBSEQUENTLY REVIEWED AND APPROVED BY THE BUILDING OFFICIAL PRIOR TO INSTALLATION: 1. PRECAST CONCRETE STAIR TREADS... 2. DESIGN FOR LIVE LOADS PROVIDED IN GENERAL NOTES AND CONFIGURATIONS SHOWN ON PLANS... 3. SHOP DRAWINGS, ERECTION DRAWINGS AND CALCULATIONS SHALL BE SUBMITTED TO THE ARCHITECT & ENGINEER FOR REVIEW PRIOR TO FABRICATION... 4. SHORING, CONNECTIONS AND BEARING IMPROVEMENTS SHALL BE SHOWN ON THE SHOP DRAWINGS, CALCULATIONS AND DRAWINGS SHALL BE STAMPED AND SIGNED BY A STRUCTURAL ENGINEER REGISTERED IN THE STATE OF CALIFORNIA... 5. DEFLECTIONS SHALL NOT EXCEED L/800 FOR LIVE LOADS... 6. ALL PRECAST CONCRETE ELEMENTS SHALL HAVE A MINIMUM 28-DAY COMPRESSIVE STRENGTH OF F'c = 4000 PSI... 7. MOMENT FRAMES... 8. SIMPSON STRONG FRAME BOLTED SPECIAL STEEL MOMENT FRAME (ESR-2802)... 9. FINAL DESIGN TO BE CONFIRMED PER MANUFACTURER... 10. ALL DIMENSIONS AND ELEVATIONS SHALL BE FIELD VERIFIED...

STRUCTURAL STEEL

- 1. DESIGN, FABRICATION AND ERECTION OF STRUCTURAL STEEL SHALL CONFORM TO THE SPECIFICATIONS AND STANDARD OF THE AMERICAN INSTITUTE OF STEEL CONSTRUCTION (AISC), AS CONTAINED IN THE LATEST EDITION OF 'AISC MANUAL OF STEEL CONSTRUCTION'. 2. ALL STRUCTURAL STEEL SHALL BE ERRECTED PLUMB AND TRUE TO LINE... 3. WIDELINE SECTIONS & TEES, PLATES, ANGLES, CHANNELS, SQUARE OR RECTANGULAR HOLLOW STRUCTURAL SECTIONS (HSS). 4. PIPES. 5. MACHINE BOLTS (MB). 6. HIGH STRENGTH BOLTS (HSB). 7. WELDED HEADED STUDS. 8. THREADED RODS FOR ANCHOR BOLTS. 9. HIGH STRENGTH PLATE. 10. ALL STRUCTURAL STEEL AND MISCELLANEOUS STEEL PERMANENTLY EXPOSED TO THE ELEMENTS SHALL BE HOT DIP GALVANIZED... 11. ARCHITECTUREALLY EXPOSED STRUCTURAL STEEL (AESS) SHALL COMPLY WITH AISC CODE OF STANDARD PRACTICE, SECTION 10... 12. ALL WELDED HEADED STUDS, THREADED STUDS, AND DEFORMED BARS SHALL BE NELSON, OR EQUIVALENT, WELDED IN ACCORDANCE WITH MANUFACTURER'S RECOMMENDATIONS BY CERTIFIED WELDERS... 13. BOLTS WITH UPSET THREADS ARE NOT ALLOWED... 14. ALL STRUCTURAL STEEL AND MISCELLANEOUS STEEL PERMANENTLY EXPOSED TO THE ELEMENTS SHALL BE HOT DIP GALVANIZED... 15. ARCHITECTUREALLY EXPOSED STRUCTURAL STEEL (AESS) SHALL COMPLY WITH AISC CODE OF STANDARD PRACTICE, SECTION 10... 16. NOTCHING AND HOLES SHALL NOT BE ALLOWED EXCEPT AS DETAILED ON THESE PLANS OR AS APPROVED BY THE EOR... 17. ALL STRUCTURAL FLOOR, ROOF AND WALL SHEATHING SHALL BE APA RATED AND SHALL CONFORM TO DOC P51 OR P52, FLOOR SHEATHING SHALL BE TAG WITH MINIMUM 48/24 SPAN RATING... 18. WOOD MEMBERS SHALL BE PRESERVATIVE-TREATED OR NATURALLY DURABLE WHERE EXPOSED TO WEATHER AND IN ACCORDANCE WITH CBC SECTION 2304.12... 19. ALL CONNECTORS THAT ARE EXPOSED TO WEATHER SHALL BE HOT-DIPPED GALVANIZED, STAINLESS STEEL OR A SEOR APPROVED EQUIVALENT...

- 1. CONCRETE SHALL BE MIXED, PLACED AND CURED IN ACCORDANCE WITH ACI 318 AND ACI 301 LATEST EDITION, AND PROJECT SPECIFICATIONS. 2. CONCRETE SHALL NOT BE DROPPED THROUGH REINFORCING STEEL (AS IN WALLS) SO AS TO CAUSE SEGREGATION OF AGGREGATES... 3. STRUCTURAL JOINTS SHALL BE CLEANED AND ROUGHENED BY REMOVING THE ENTIRE SURFACE TO EXPOSE CLEAN AND SOUND CONCRETE... 4. STRUCTURAL CONCRETE SHALL MEET THE FOLLOWING DESIGN CRITERIA: LOCATION, MIN 28-DAY COMP STRENGTH, CONC TYPE, MAX AGGREGATE SIZE, MAX WC RATIO. 5. CONCRETE MIX DESIGN AND TESTING SHALL MEET THE REQUIREMENTS OF THE BUILDING CODE AND SPECIFICATIONS... 6. PORTLAND CEMENT SHALL BE TYPE II AND SHALL CONFORM TO ASTM C150, LOW ALKALI... 7. FLX ASH OR OTHER POZZOLANS CONFORMING TO ASTM C618 CLASS F MAY BE USED AS A PARTIAL SUBSTITUTION FOR PORTLAND CEMENT UP TO 10% OF THE TOTAL CEMENT... 8. CONCRETE MIXING OPERATIONS, ETC. SHALL CONFORM TO ASTM C94... 9. LEAN CONCRETE, WHERE SPECIFICALLY INDICATED, SHALL CONTAIN 2 SACKS OF CEMENT PER CUBIC YARD OF CONCRETE... 10. DRYPACK OR NONSHRINK GROUT SHALL HAVE A MINIMUM 28-DAY COMPRESSIVE STRENGTH OF 5000 PSI... 11. PRIOR TO ERECTING ANY ELEMENTS THAT LOAD THE FOUNDATION, CONCRETE MUST REACH AN UNCONFIRMED COMPRESSION STRENGTH OF 2000 PSI MINIMUM... 12. MAINTAIN CONCRETE ABOVE 50 DEGREES FAHRENHEIT AND IN A MOIST CONDITION FOR A MINIMUM OF 7 DAYS AFTER PLACEMENT UNLESS OTHERWISE ACCEPTED BY EOR... 13. PROVIDE SLEEVES FOR ALL PIPES THROUGH CONCRETE WALLS AND FOOTINGS... 14. EXPOSED CORNERS OF SLABS, BEAMS, WALLS, COLUMNS, ETC. SHALL BE FORMED WITH 3/4" CHAMFER OR 1/2" RADIUS TOOLED EDGE UNO... 15. FOUNDATIONS AND SLABS ON GRADE... 16. ALLOWABLE SOIL PRESSURES FOR FOOTINGS... 17. ALLOWABLE LATERAL SOIL BEARING PRESSURE PER FOOT OF DEPTH... 18. SPREAD FOOTINGS ARE CENTERED UNDER WALLS AND COLUMNS UNO... 19. FOOTING ELEVATIONS ARE NOTED ON THE PLANS AND DETAILS AND SHALL BE USED FOR BIDDING... 20. ALL TRENCHES SHALL COMPLY WITH APPLICABLE OSHA REQUIREMENTS... 21. ALL EXCAVATIONS SHALL BE PROPERLY BACKFILLED BUT NOT BEHIND RETAINING WALLS... 22. CONSTRUCTION JOINTS (CJ) AND SAWCUT (SC) JOINTS IN SLABS SHALL OCCUR WHERE LOCATED ON PLANS AND DETAILS... 23. SEE ARCHITECT'S PLANS FOR LOCATIONS OF SLAB SLOPES, DEPRESSIONS, CURBS, DRAINS, NON-STRUCTURAL PARTITIONS AND OTHER EMBEDDED ITEMS NOT SHOWN ON THE STRUCTURAL PLANS... 24. CONTRACTOR SHALL PROTECT ALL UTILITY LINES, ETC. ENCOUNTERED DURING EXCAVATION AND BACKFILLING... 25. VERIFY ALL CONDITIONS & DIMENSIONS PRIOR TO SHOP DRAWING PRODUCTION... 26. WHERE ALL OTHER EXISTING CONDITIONS VARY SIGNIFICANTLY FROM THOSE SHOWN ON THESE DRAWINGS... 27. SHORE ALL EXISTING CONSTRUCTION AS REQUIRED... 28. VERIFY LOCATION OF EXISTING REBAR BEFORE FABRICATION... 29. THE GENERAL CONTRACTOR SHALL COORDINATE THE WEIGHT AND SPECIFIC LOCATION OF ALL MECHANICAL EQUIPMENT WITH THE STRUCTURAL FRAMING... 30. ALL EXISTING WOOD FRAMING MEMBERS SUPPORTING NEAR MECHANICAL UNITS SHALL BE INSPECTED FOR DAMAGE AND REPLACED PRIOR TO INSTALLATION OF THE UNITS... 31. GENERAL NOTES... 32. TYPICAL DETAILS... 33. FOUNDATION & 2ND FLOOR FRAMING PLANS... 34. 1ST FLOOR FOUNDATION & 2ND FLOOR FRAMING PLANS... 35. 2ND FLOOR FOUNDATION & 2ND FLOOR FRAMING PLANS... 36. 3RD FLOOR FOUNDATION & 2ND FLOOR FRAMING PLANS... 37. 4TH FLOOR FOUNDATION & 2ND FLOOR FRAMING PLANS... 38. 5TH FLOOR FOUNDATION & 2ND FLOOR FRAMING PLANS... 39. 6TH FLOOR FOUNDATION & 2ND FLOOR FRAMING PLANS... 40. 7TH FLOOR FOUNDATION & 2ND FLOOR FRAMING PLANS... 41. 8TH FLOOR FOUNDATION & 2ND FLOOR FRAMING PLANS... 42. 9TH FLOOR FOUNDATION & 2ND FLOOR FRAMING PLANS... 43. 10TH FLOOR FOUNDATION & 2ND FLOOR FRAMING PLANS... 44. 11TH FLOOR FOUNDATION & 2ND FLOOR FRAMING PLANS... 45. 12TH FLOOR FOUNDATION & 2ND FLOOR FRAMING PLANS... 46. 13TH FLOOR FOUNDATION & 2ND FLOOR FRAMING PLANS... 47. 14TH FLOOR FOUNDATION & 2ND FLOOR FRAMING PLANS... 48. 15TH FLOOR FOUNDATION & 2ND FLOOR FRAMING PLANS... 49. 16TH FLOOR FOUNDATION & 2ND FLOOR FRAMING PLANS... 50. 17TH FLOOR FOUNDATION & 2ND FLOOR FRAMING PLANS... 51. 18TH FLOOR FOUNDATION & 2ND FLOOR FRAMING PLANS... 52. 19TH FLOOR FOUNDATION & 2ND FLOOR FRAMING PLANS... 53. 20TH 2	ADDENDUM 2	6/28/19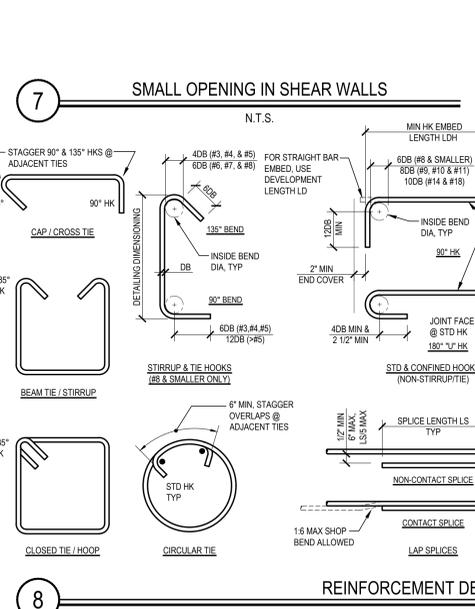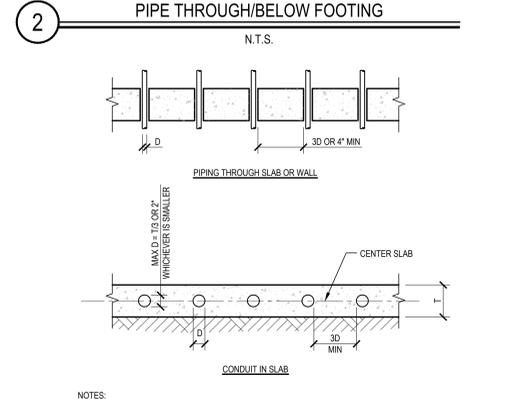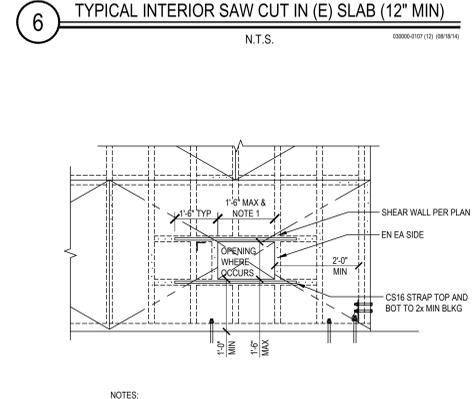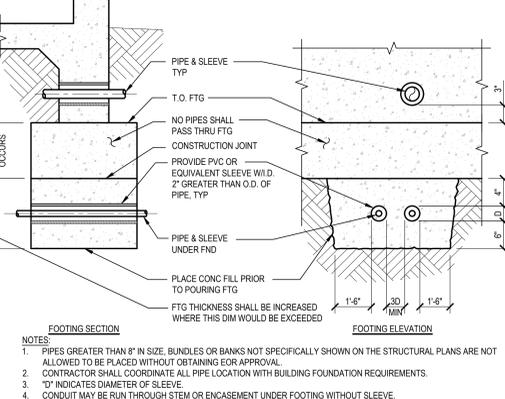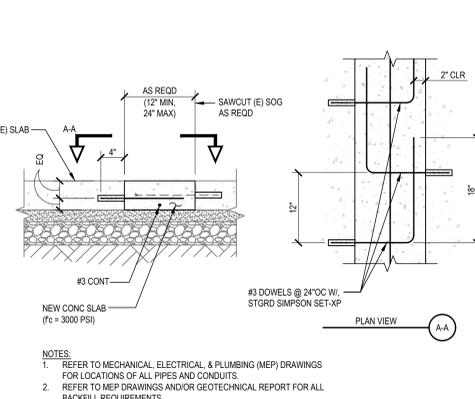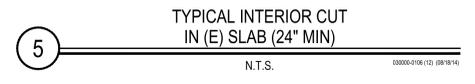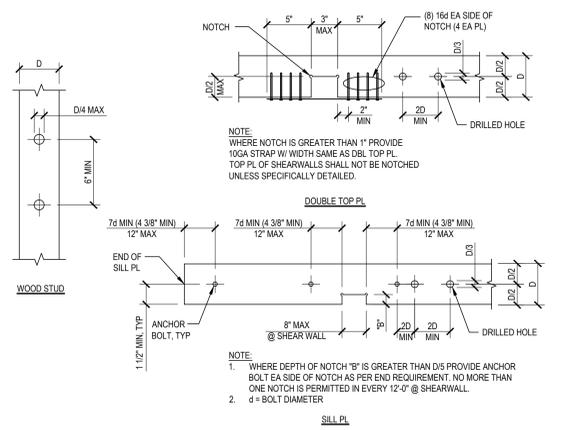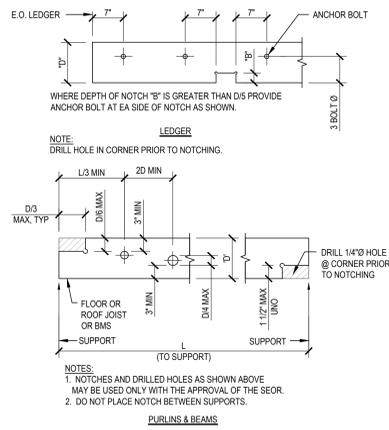

UCR PROJECT #: 956390
UCR CAAN #: P5673
DATE: 05-10-2019
DRAWN: M.B.V.

APPROVED
07/02/2019

OFFICE OF THE STATE FIRE MARSHAL
APPROVED FIRE AND PANIC ONLY

Approval of this plan does not authorize or approve any erection or deviation from applicable regulations. Final approval is subject to field inspection. One set of approved plans shall be available on the project site at all times.

Reviewed by: *[Signature]*
Safety Division

INSPECTIONS REQUIRED:
#1 - Foundation
#2 - Framing
#3 - Electrical
#4 - Mechanical
#5 - Fire Protection
#6 - Final

REVISIONS REQUIRED:
#1 - Foundation
#2 - Framing
#3 - Electrical
#4 - Mechanical
#5 - Fire Protection
#6 - Final

Building, Safety and Compliance Division
Campus Building Permit


miyamoto.
1901 East Alhambra Avenue, Suite 100
Santa Ana, CA 92705
MIY04011.00
T: 949.879.1770
miyamotointernational.com

REGISTERED PROFESSIONAL ENGINEER
STRUCTURAL
STATE OF CALIFORNIA
No. 56462

UNIVERSITY OF CALIFORNIA, RIVERSIDE
FALKIRK SITE AND SEISMIC IMPROVEMENTS - SUMMER 2019
3429 CANYON CREST DRIVE
RIVERSIDE, CA 92507

TYPICAL DETAILS
S1.1


C:\CAD Files Mill\Temporary Files\AP\Falkirk_S1.1.dwg 05/28/19 05:58 mrcant

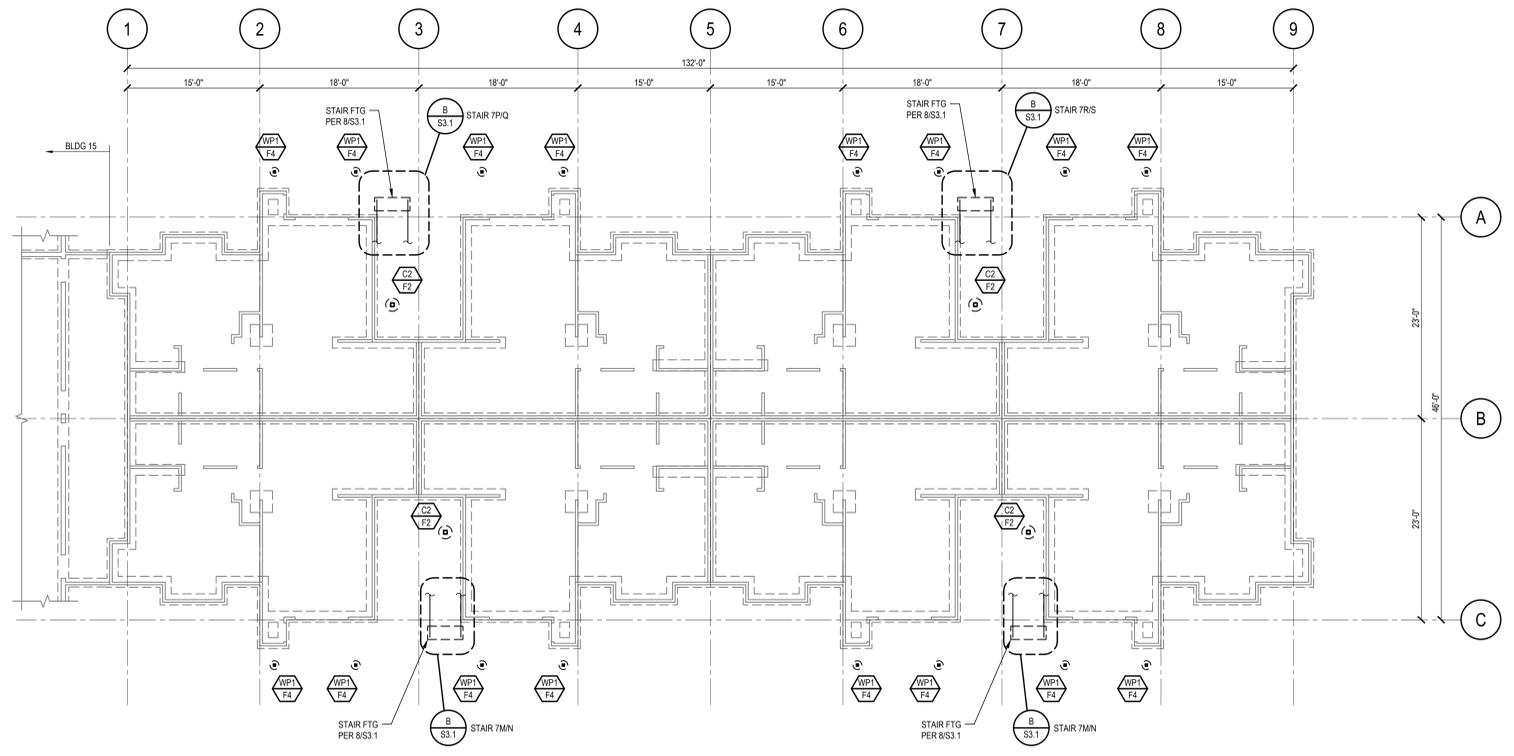

A FOUNDATION PLAN - BUILDING 7

NOTES:
1. SEE 15-S2.1 FOR SCHEDULES, LEGEND AND PLAN NOTES.

1/8" = 1'-0"

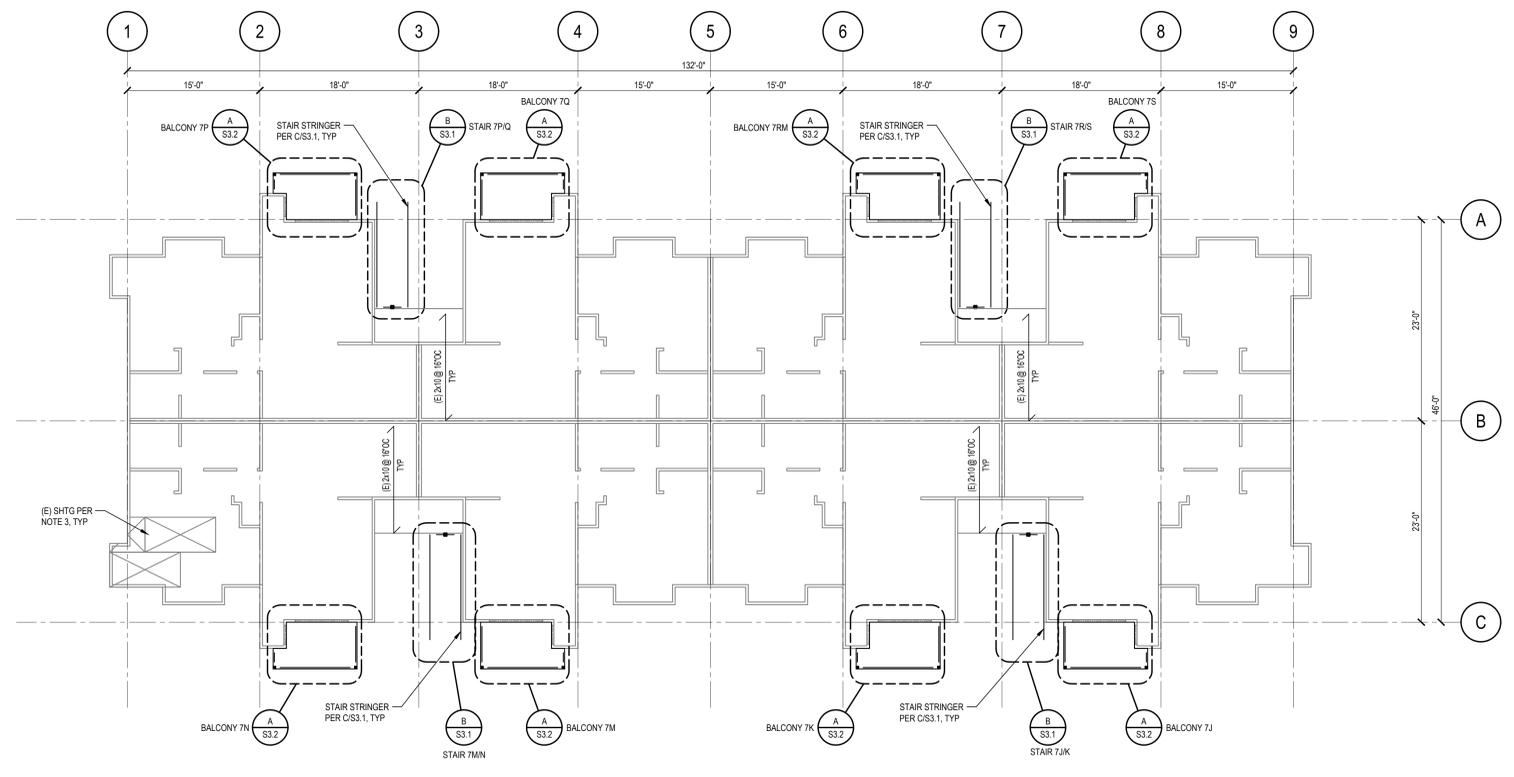


B SECOND FLOOR FRAMING PLAN - BUILDING 7

NOTES:
1. SEE 15-S2.1 FOR SCHEDULES, LEGEND AND PLAN NOTES.

1/8" = 1'-0"

OFFICE OF THE STATE FIRE MARSHAL
APPROVED FIRE AND PANIC ONLY
07/02/2019
Approval of this plan does not authorize or approve any omission or deviation from applicable regulations. Final approval is subject to field inspection. One set of approved plans shall be available on the project site at all times.
Reviewed by: *[Signature]*
Fire and Life Safety Division

REVISIONS	ADDENDUM	DATE
1	ADDENDUM 1	6/14/19
2	ADDENDUM 2	6/28/19

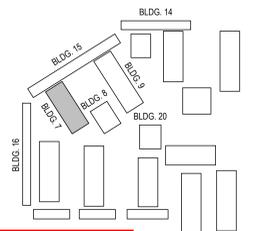

INSPECTIONS REQUIRED
UC RIVERSIDE
Office of Planning, Design & Construction
Signed CSO: Blair S. Bell
Building, Safety and Compliance Division
CAMPUS BUILDING PERMIT
ALL WORK SHALL BE SUBJECT TO THE UC RIVERSIDE

APPROVED
UC Riverside
Planning, Design & Construction
KEY PLAN
Signed CSO: Blair S. Bell
Building, Safety and Compliance Division
CAMPUS BUILDING PERMIT

UNIVERSITY OF CALIFORNIA, RIVERSIDE
FALKIRK SITE AND SEISMIC IMPROVEMENTS - SUMMER 2019
3429 CANYON CREST DRIVE
RIVERSIDE, CA 92507

miyamoto.
1901 East Alton Avenue, Suite 100
Santa Ana, CA 92705
MI1904011.00
T: (949) 579-1170
miyamotointernational.com

I:\2019\MI1904011.00 - Falkirk Site & Seismic Improvements\ProjectDrawings\MI1904011.00_S7-2.1.dwg 05/28/19 10:59:59 mvm\cmf




Consultant

UNIVERSITY OF CALIFORNIA, RIVERSIDE
FALKIRK SITE AND SEISMIC IMPROVEMENTS - SUMMER 2019
3429 CANYON CREST DRIVE
RIVERSIDE, CA 92507

REVISIONS		
1	ADDENDUM 1	6/14/19
2	ADDENDUM 2	6/28/19

UCR PROJECT #:	956390
UCR CAAN #:	P5673
DATE:	05-10-2019
DRAWN:	M.B.V.


BUILDING 8
FOUNDATION & 2ND FLOOR
FRAMING PLANS
S8-2.1

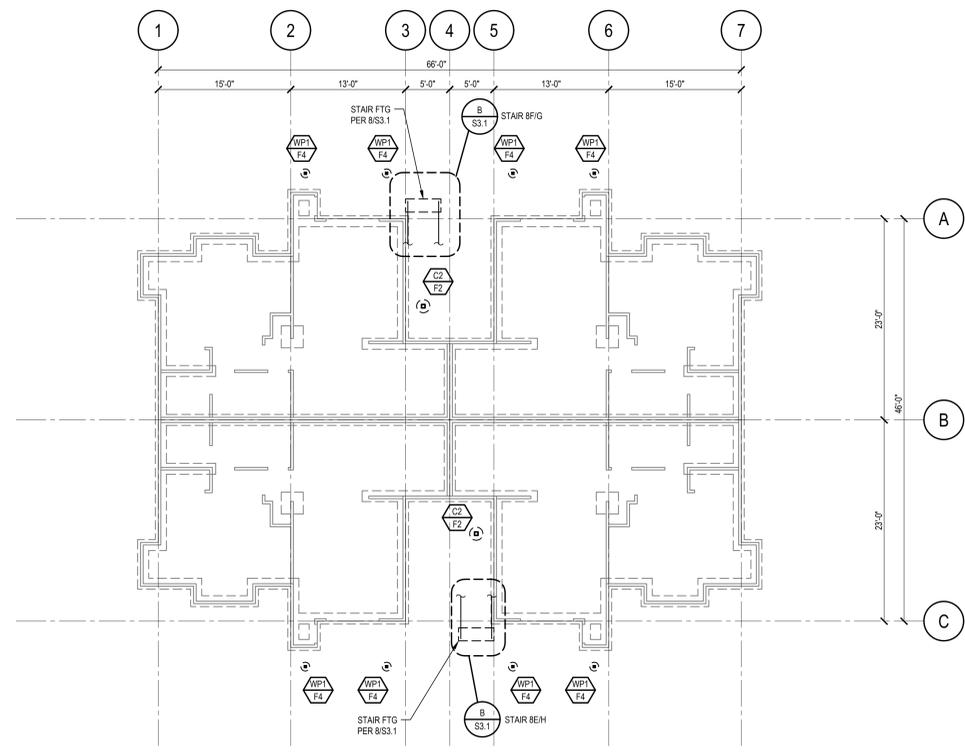

(A) FOUNDATION PLAN - BUILDING 8

NOTES:
1. SEE 15-S2.1 FOR SCHEDULES, LEGEND AND PLAN NOTES.


1/8" = 1'-0"

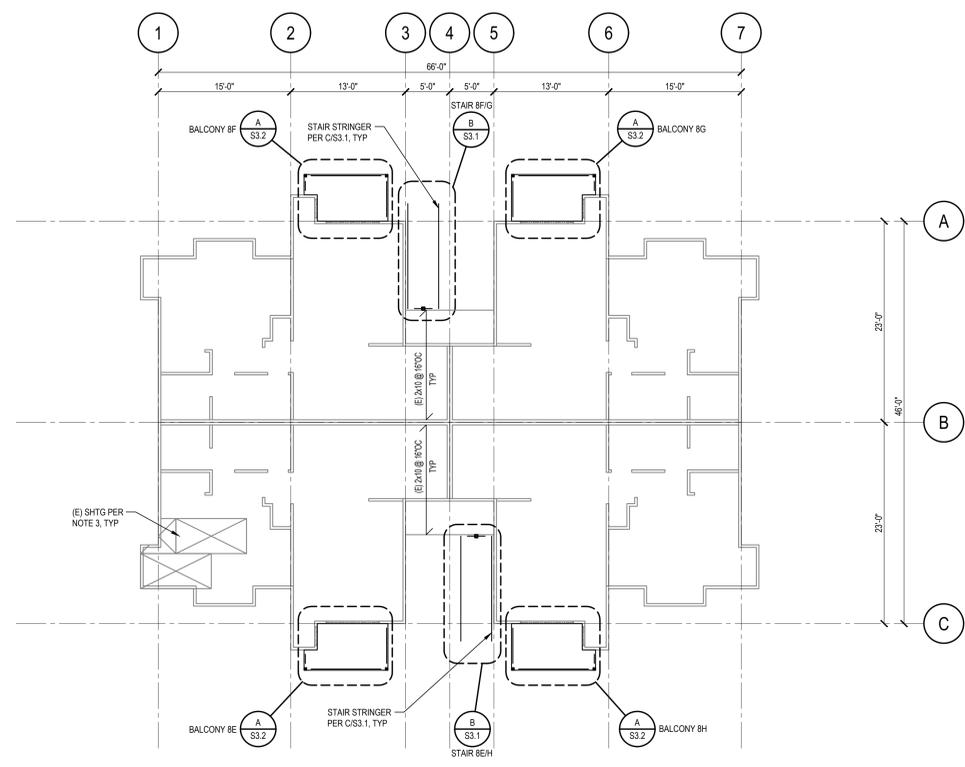

(B) SECOND FLOOR FRAMING PLAN - BUILDING 8

NOTES:
1. SEE 15-S2.1 FOR SCHEDULES, LEGEND AND PLAN NOTES.

1/8" = 1'-0"

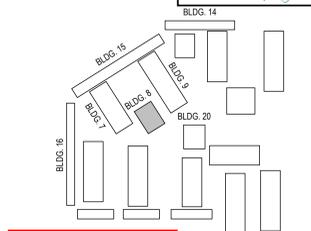


INSPECTIONS REQUIRED
UC RIVERSIDE
Office of Planning, Design & Construction
Signed CBO: Blair S. Bellows
Building, Safety and Compliance Division
CAMPUS BUILDING PERMIT
ALL WORK SHALL BE SUBJECT TO UCRRS 92008-92010

APPROVED
UC Riverside
Planning, Design & Construction
KEY PLAN
Signed CBO: Blair S. Bellows
Building, Safety and Compliance Division
CAMPUS BUILDING PERMIT




1/2019/MI1904011.00 - Falkirk, Site & Seismic Improvements/ProjectDrawings/MI1904011.00_S8-2.1.dwg 05/28/19 10:59 mivmont

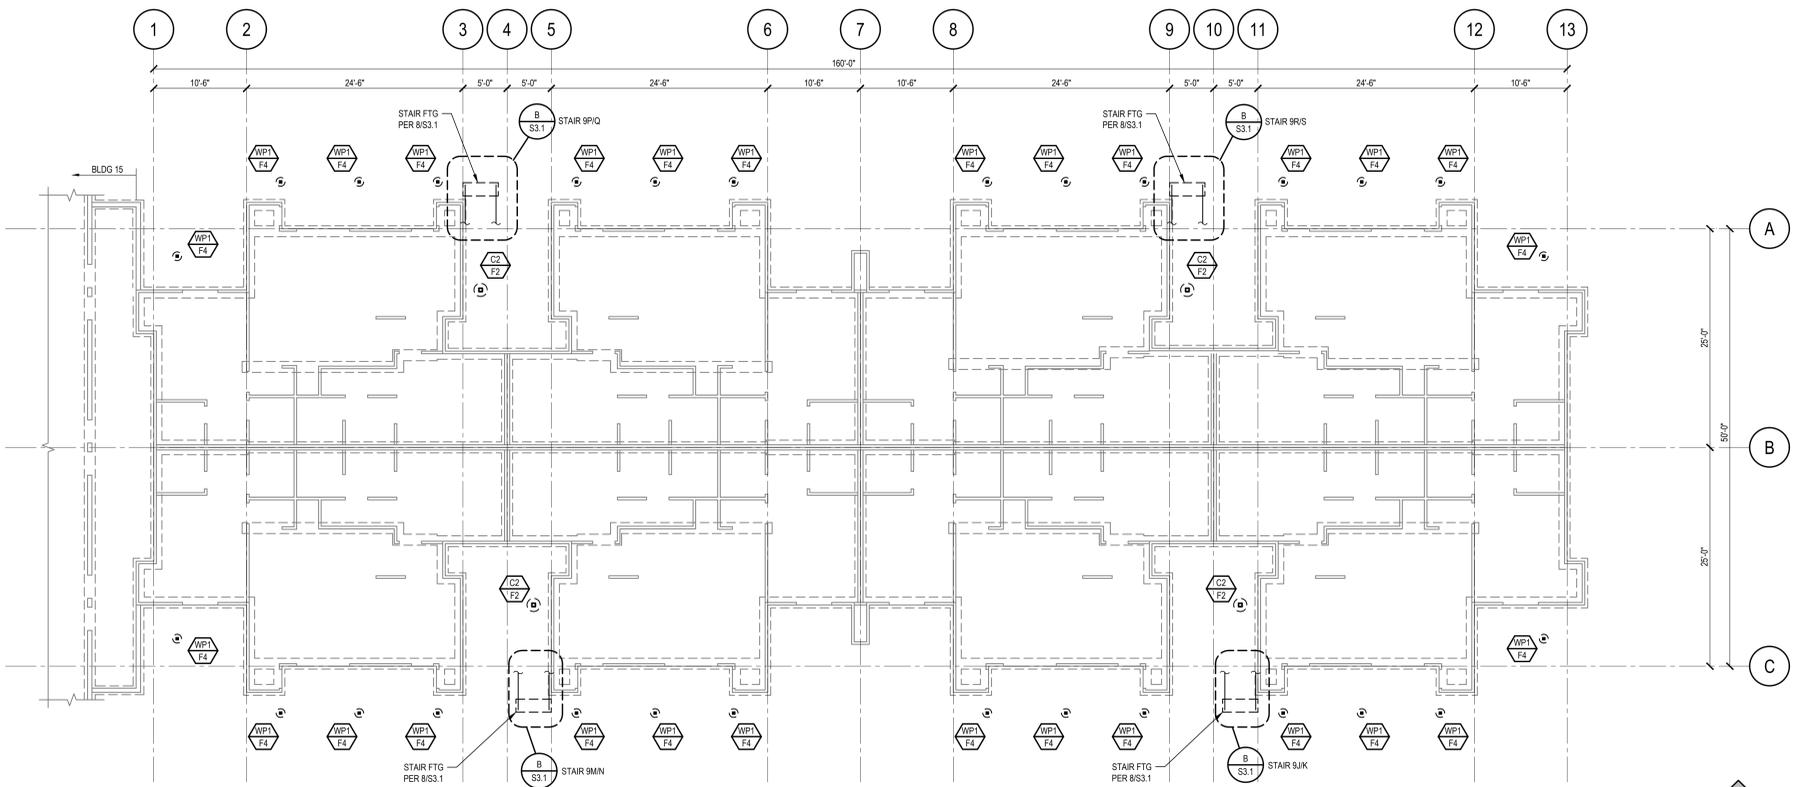

A FOUNDATION PLAN - BUILDING 9

NOTES:
1. SEE 15-S2.1 FOR SCHEDULES, LEGEND AND PLAN NOTES.

1/8" = 1'-0"

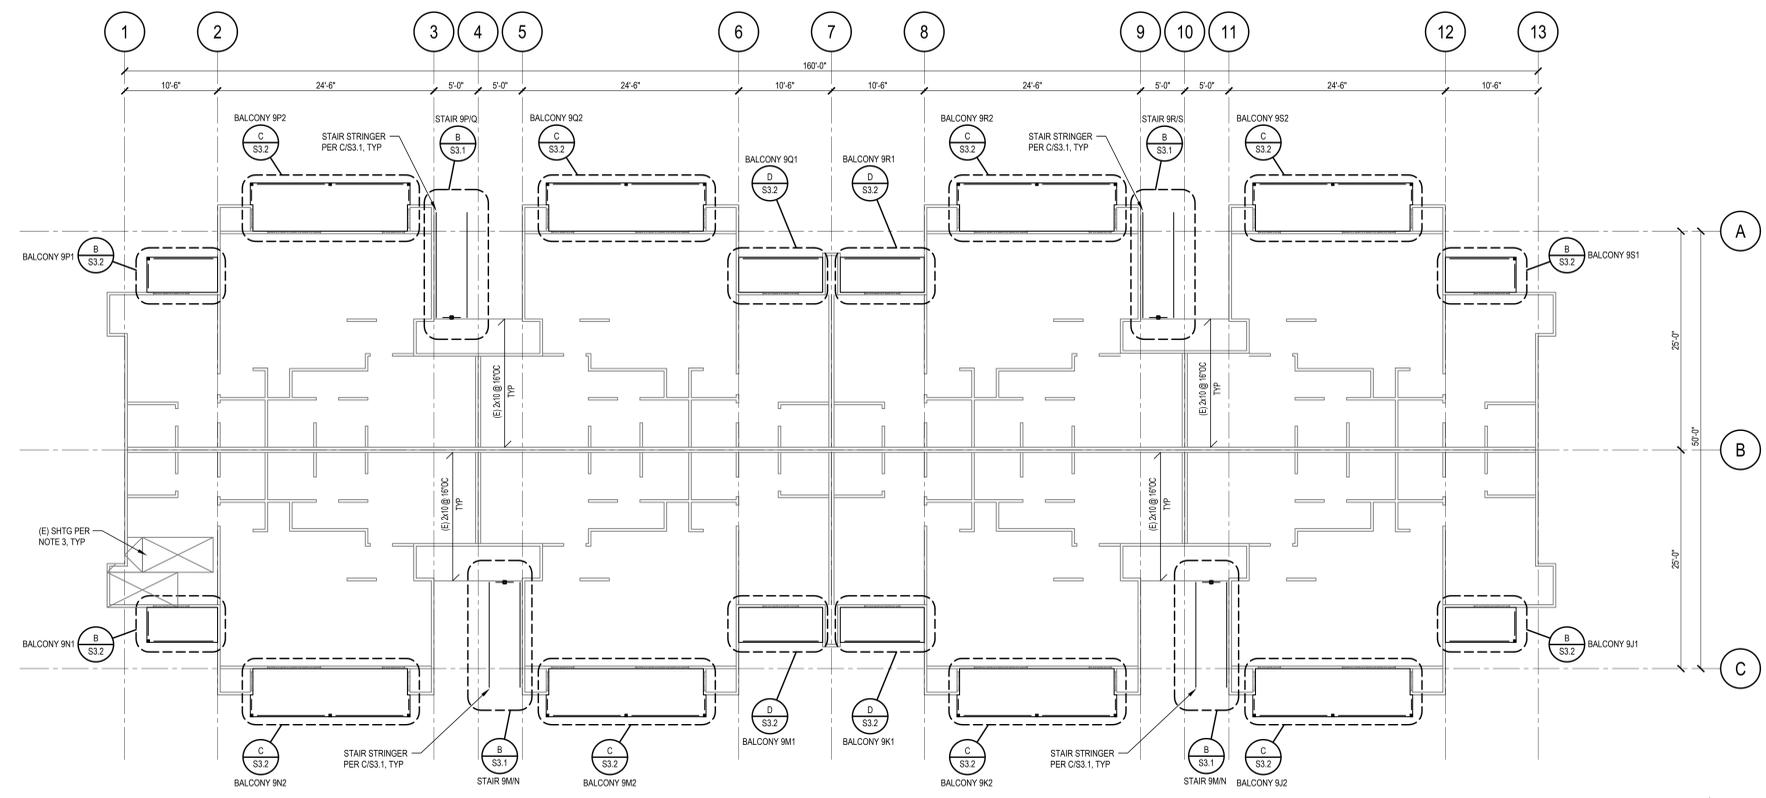


B SECOND FLOOR FRAMING PLAN - BUILDING 9

NOTES:
1. SEE 15-S2.1 FOR SCHEDULES, LEGEND AND PLAN NOTES.

1/8" = 1'-0"



OFFICE OF THE STATE FIRE MARSHAL
APPROVES FIRE AND PANIC ONLY
07/02/2019
Approval of this plan does not authorize or approve any omission or deviation from applicable regulations. Final approval is subject to field inspection. One set of approved plans shall be available on the project site at all times.
Reviewed by: *[Signature]*
Fire and Life Safety Division

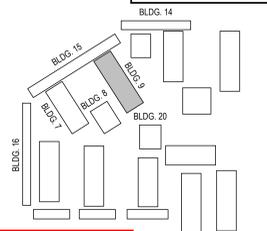

INSPECTIONS REQUIRED
UC RIVERSIDE
Office of Planning, Design & Construction
Signed CSO: Blair S. Bell
Building, Safety and Compliance Division
CAMPUS BUILDING PERMIT
ALL WORK SHALL BE SUBJECT TO THE UC RIVERSIDE

APPROVED
UC Riverside
Planning, Design & Construction
KEY PLAN
Signed CSO: Blair S. Bell
Building, Safety and Compliance Division
CAMPUS BUILDING PERMIT



UNIVERSITY OF CALIFORNIA, RIVERSIDE
FALKIRK SITE AND SEISMIC IMPROVEMENTS - SUMMER 2019
3429 CANYON CREST DRIVE
RIVERSIDE, CA 92507


REVISIONS

1	ADDENDUM 1	6/14/19
2	ADDENDUM 2	6/28/19

UCR PROJECT #: 956390
UCR CAAN #: P5673
DATE: 05-10-2019
DRAWN: M.B.V.



BUILDING 9
FOUNDATION & 2ND FLOOR
FRAMING PLANS
S9-2.1

1/2019/MI1904011.00 - Falkirk, Site & Seismic Improvements Project/Drawings/MI1904011.00_S9-2.1.dwg 05/28/19 05:59 mivmont

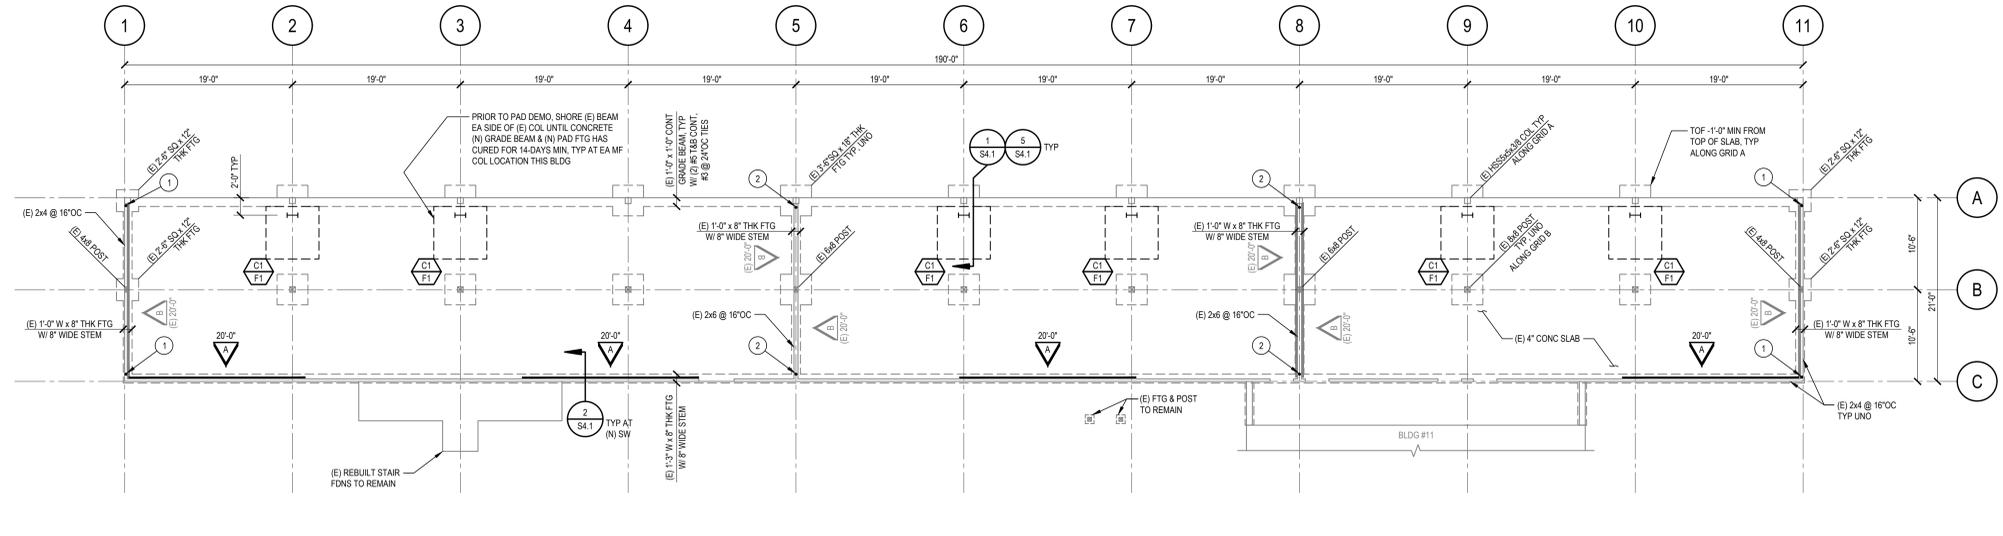


A FOUNDATION PLAN - BUILDING 14

NOTES:
1. SEE 15-S2.1 FOR SCHEDULES, LEGEND AND PLAN NOTES.

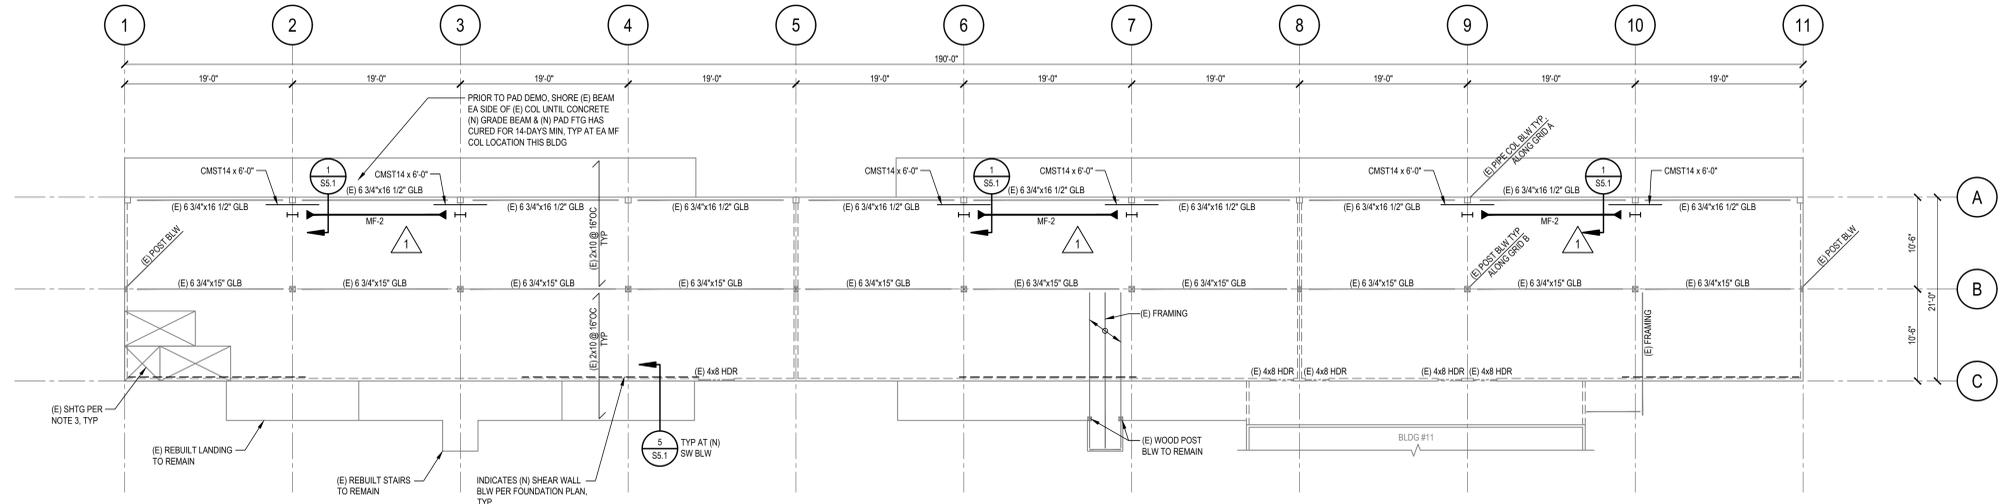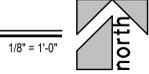


B SECOND FLOOR FRAMING PLAN - BUILDING 14

NOTES:
1. SEE 15-S2.1 FOR SCHEDULES, LEGEND AND PLAN NOTES.

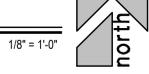

OFFICE OF THE STATE FIRE MARSHAL
APPROVED FIRE AND PANIC ONLY
07/02/2019
Approval of this plan does not authorize or approve any omission or deviation from applicable regulations. Final approval is subject to field inspection. One set of approved plans shall be available on the project site at all times.
Reviewed by: *[Signature]*
Fire and Life Safety Division

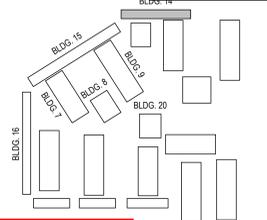

INSPECTIONS REQUIRED
UC RIVERSIDE
Office of Planning, Design & Construction
Signed: CBO: Blair S. Bell
Building, Safety and Compliance Division
CAMPUS BUILDING PERMIT
ALL WORK SHALL BE TRACKED TO THE UC RIVERSIDE SYSTEM

APPROVED
UC Riverside
Office of Planning, Design & Construction
Signed: CBO: Blair S. Bell
Building, Safety and Compliance Division
CAMPUS BUILDING PERMIT

miyamoto.
1901 East Alton Avenue, Suite 100
Santa Ana, CA 92705
MI904011.00
T: (949) 579-1170
miyamotointernational.com


UNIVERSITY OF CALIFORNIA, RIVERSIDE
FALKIRK SITE AND SEISMIC IMPROVEMENTS - SUMMER 2019
3429 CANYON CREST DRIVE
RIVERSIDE, CA 92507

REVISIONS	ADDENDUM	DATE
1	ADDENDUM 1	6/4/19
2	ADDENDUM 2	6/28/19

UCR PROJECT #: 956390
UCR CAAN #: P5673
DATE: 05-10-2019
DRAWN: M.B.V.

**BUILDING 14
FOUNDATION &
2ND FLOOR
FRAMING PLANS
S14-2.1**

miyamoto.
 1901 East Alton Avenue, Suite 100
 Santa Ana, CA 92705
 MI904011.00
 T: (949) 579-1170
 miyamotointernational.com

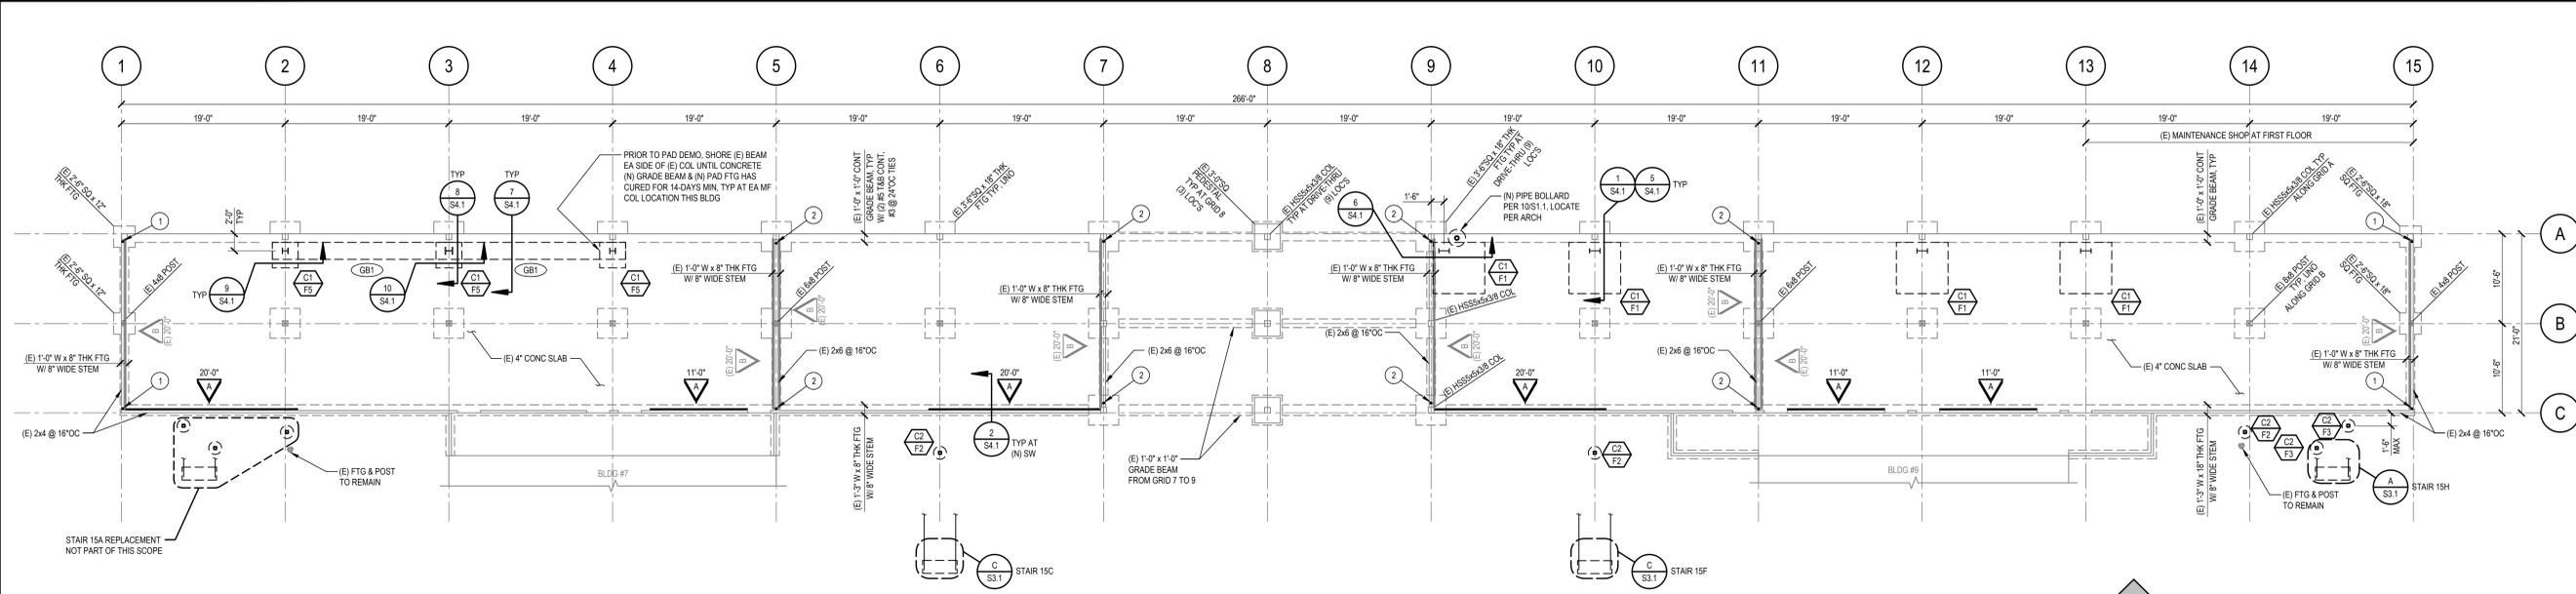(A) FOUNDATION PLAN - BUILDING 15

SHEAR WALL SCHEDULE

MARK	PLYWOOD OR OSB SHEATHING (EN)	EDGE NAILING (EN)	SILL BOLTING (SB)	BLKG & STUD AT ADJOINING PANEL EDGES	RIM JOIST OR BLOCKING CONN TO TOP PLATE BELOW	CAPACITY (ASD)
A	15/32" C-D	10d @ 6" OC	3/8" x 7" EMBED @ 48" OC TIEEN HD	2x	A35LTP4 @ 16" OC	310 PLF
B	1/2" CDX	10d @ 2 1/2" OC	(E)	3x	(E)	680 PLF
C	3/8" STRUCT I	8d @ 6" OC	(E)	2x	(E)	280 PLF

NOTES:
 1. SEE GENERAL NOTES ON S0.1 FOR SHEAR WALL SCHEDULE NOTES.
 2. SHEATHING SHALL EXTEND AND NAIL TO (E) OR (N) FULL HEIGHT STUD EACH END OF WALL.
 3. ALL NAILING AND INFO FOR (E) SHEAR WALLS ARE EXISTING, UNLESS WHERE NOTED ON PLANS/DETAILS. DO NOT DAMAGE OR MODIFY (E) SHEAR WALLS.
 4. (N) TYPE A SHEAR WALLS AT BLDGS 14-16 MAY BE SHIFTED ±10'-0" AS NECESSARY. NOTIFY SEOR OF ANY LOCATION CHANGES GREATER THAN 10'-0".
 5. PROVIDE TOP PLATE CONNECTION WHERE EXISTING SHEAR TRANSFER NAILING DOES NOT OCCUR. SEE FRAMING DETAILS.

LEGEND:
 X-X' INDICATES NEW PLYWOOD SHEAR WALL TYPE AND MINIMUM LENGTH PER SCHEDULE THIS SHEET.
 E'X'X' INDICATES EXISTING PLYWOOD SHEAR WALL AND LENGTH PER SCHEDULE THIS SHEET.
 GA, FA INDICATES COLUMN / POST TYPE PER SCHEDULE THIS SHEET.
 1 INDICATES HOLD-DOWN PER SCHEDULE THIS SHEET.
 W INDICATES WOOD POST.

COLUMN SCHEDULE

MARK	SIZE	BASE PLATE	REMARKS
C1	MF COL PER MANUF		
C2	HSS54x14		SEE 7/S3.1
WP1	4x4 DF #1		SEE 1/S3.2

HOLD-DOWN SCHEDULE

MARK	HOLD-DOWN	ANCHOR RODS	POST (UNO)	DETAIL	CAPACITY (ASD)	TEST LOADS
1	(S) HDU2-SDS25	5/8" Ø x 10" MIN EMBED	(2) 2x OR 4x	BLDG 14-16: 3/S4.1 BLDG 20: 12/S4.1	3075 LBS	3700 LBS
2	(S) HDU5-SDS25	5/8" Ø x 18" MIN EMBED	(2) 2x OR 4x		5645 LBS	6400 LBS


NOTES:
 1. NAIL DOUBLE STUDS TOGETHER W/ 16d @ 6" OC STAGGERED.
 2. WHERE EXISTING END POST DOES NOT MEET MINIMUM, PROVIDE ADDITIONAL 2x FOR MIN OF (2) 2x NAILED PER NOTE 1.
 3. PROVIDE THE SPECIFIED TEST LOAD AT EACH ANCHOR ROD TO VERIFY ANCHOR CAPACITY.
 4. ANCHOR RODS SHALL BE EPOXYED WITH SIMPSON SET-99. SEE S5.1.1 FOR ALLOWABLE ALTERNATES.

FOOTING SCHEDULE

MARK	SIZE	REINFORCING
F1	6'-0" SQ x 1'-6" THK	(7) #5 T&B EA WAY. SEE 1/S4.1
F2	1'-6" DIA x 6'-0" DP	SEE 7/S3.1
F3	1'-6" DIA x 3'-0" DP	SEE 7/S3.1
F4	1'-6" DIA x 1'-6" DP	SEE 1/S3.2
F5	3'-0" SQ x 1'-6" THK	(3) #5 BOT EA WAY

GRADE BEAM SCHEDULE

MARK	SIZE (WxH)	REINFORCEMENT
GB1	2'-4"x2'-3"	(4) #6 CONT T&B. #4 CLOSED TIES @ 12" OC

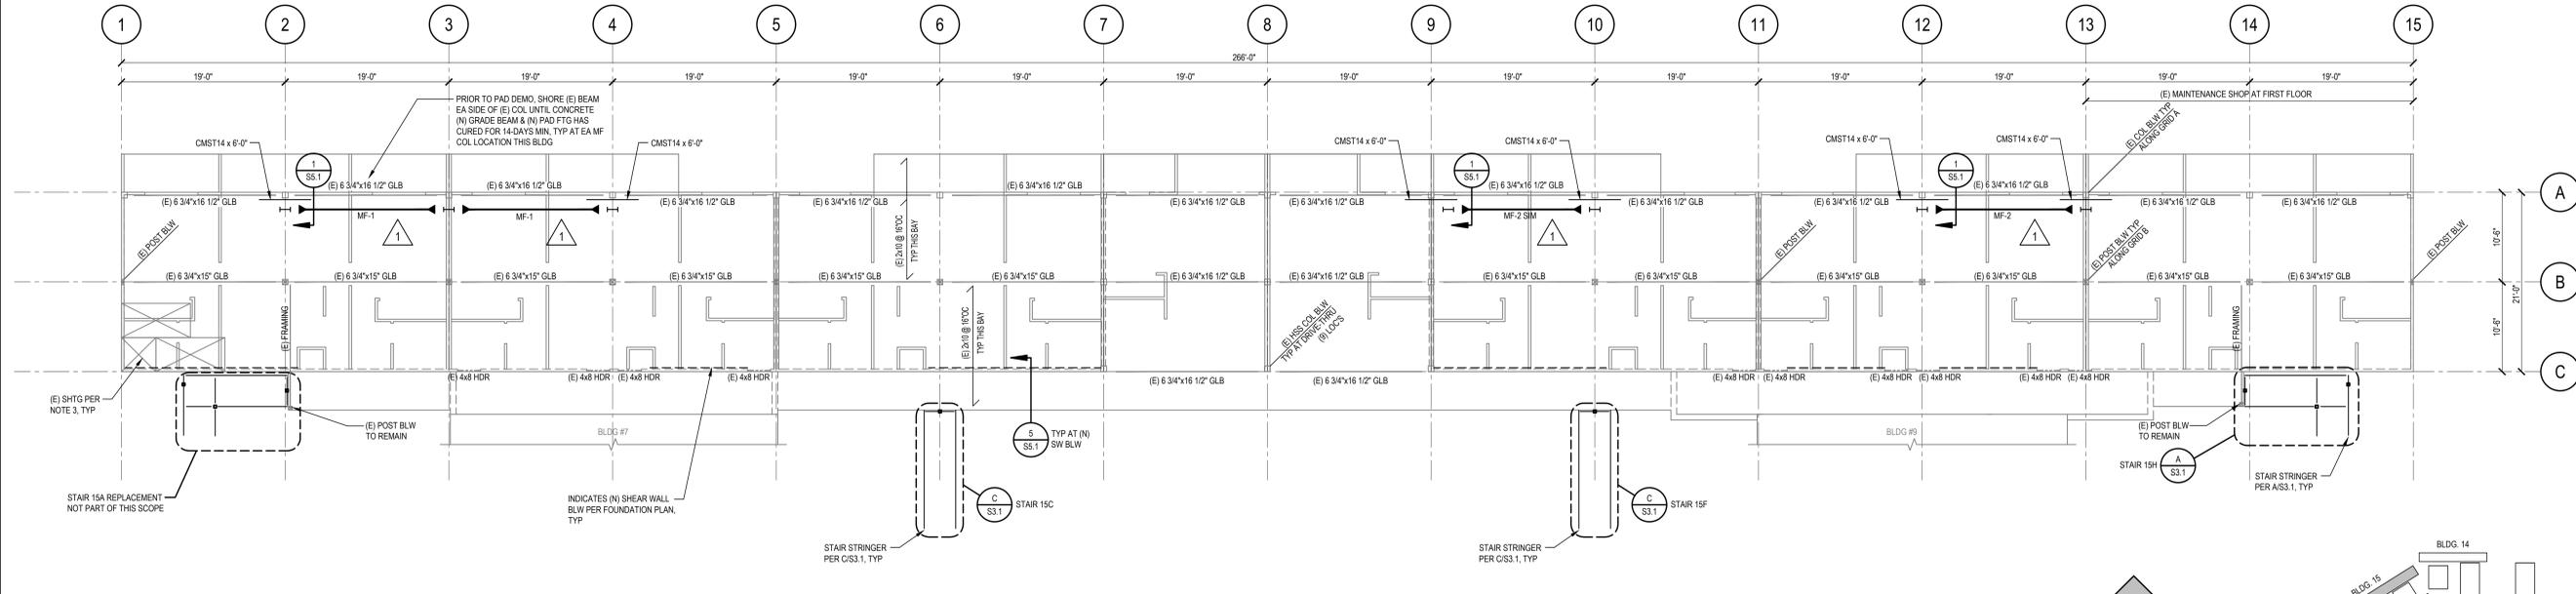


(B) SECOND FLOOR FRAMING PLAN - BUILDING 15

LEGEND:
 ——— INDICATES (E) HEADER
 ——— INDICATES SIMPSON STRONG FRAME MOMENT FRAME BEAM
 MF-1 INDICATES FRAME MF-1 ON SHEET MF-1
 MF-2 INDICATES FRAME MF-2 ON SHEET MF-2
 1 INDICATES FRAME MF-1 ON SHEET MF-1

NOTES:
 1. SEE S0.1 FOR GENERAL NOTES AND S1.1 FOR TYPICAL DETAILS.
 2. ALL EXISTING DIMENSIONS AND ELEVATIONS SHALL BE VERIFIED IN FIELD.
 3. EXISTING FLOOR SHEATHING IS 5/8" T&G CDX PLYWOOD WITH 15d @ 6" OC BN & EN AND 10" OC FN.
 4. WALL ABOVE NOT SHOWN FOR CLARITY. WALL BELOW INDICATED WITH DASH.
 5. SEE ARCH FOR ALL DEMO, FINISH REMOVAL, AND REPLACEMENT, AND DIMENSIONS AND ELEVATIONS NOT SHOWN.

OFFICE OF THE STATE FIRE MARSHAL
 APPROVED FIRE AND FANUC ONLY
07/02/2019
 Approval of this plan does not authorize or approve any conditions or deviations from applicable codes, rules, regulations or standards.
INSPECTIONS REQUIRED
 UC Riverside
 Requested By: **Michael Miyamoto**
 Signed: **Michael Miyamoto**
 Building & Safety Division
 Campus Building Permit

APPROVED
 UC Riverside
 Planning & Construction
KEY PLAN
 Building & Safety Division
 Campus Building Permit

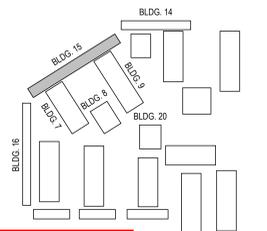

UNIVERSITY OF CALIFORNIA, RIVERSIDE
 FALKIRK SITE AND SEISMIC IMPROVEMENTS - SUMMER 2019
 3429 CANYON CREST DRIVE
 RIVERSIDE, CA 92507


REVISIONS

NO.	DESCRIPTION	DATE
1	ADDENDUM 1	6/14/19
2	ADDENDUM 2	6/28/19

UCR PROJECT #: 956390
 UCR CAAN #: P5673
 DATE: 05-10-2019
 DRAWN: M.B.V.



**BUILDING 15
 FOUNDATION &
 2ND FLOOR
 FRAMING PLANS
 S15-2.1**

miyamoto.
 1901 East Alton Avenue, Suite 100
 Santa Ana, CA 92705
 MI904011.00
 T: 949.579.1170
 miyamotointernational.com

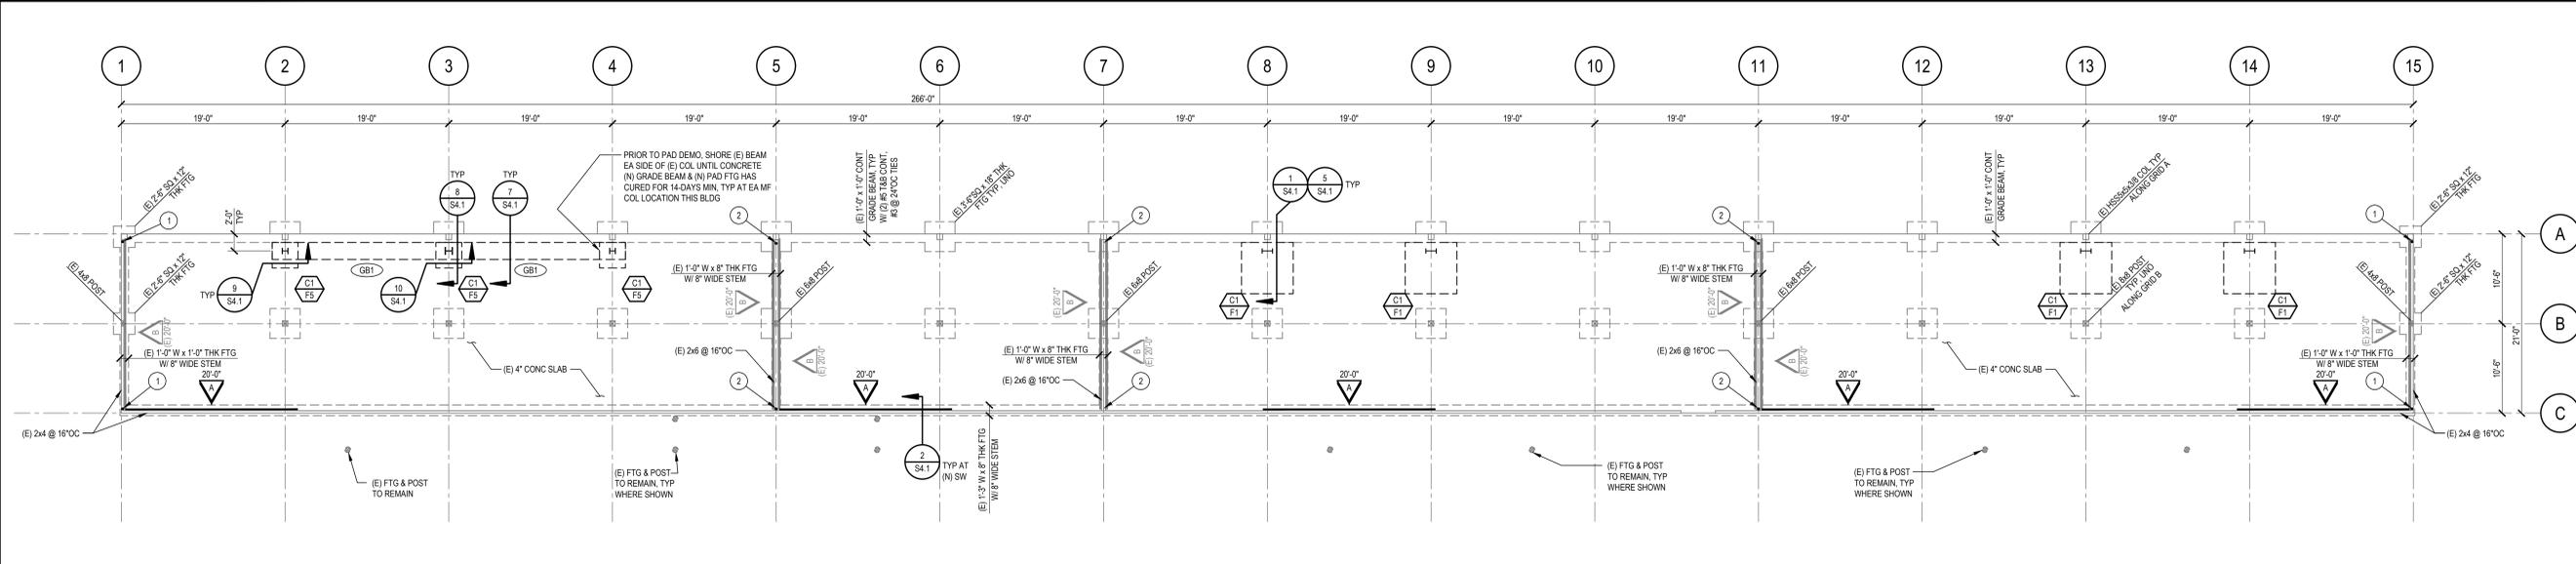


A FOUNDATION PLAN - BUILDING 16

NOTES:
 1. SEE 15-52.1 FOR SCHEDULES, LEGEND AND PLAN NOTES.

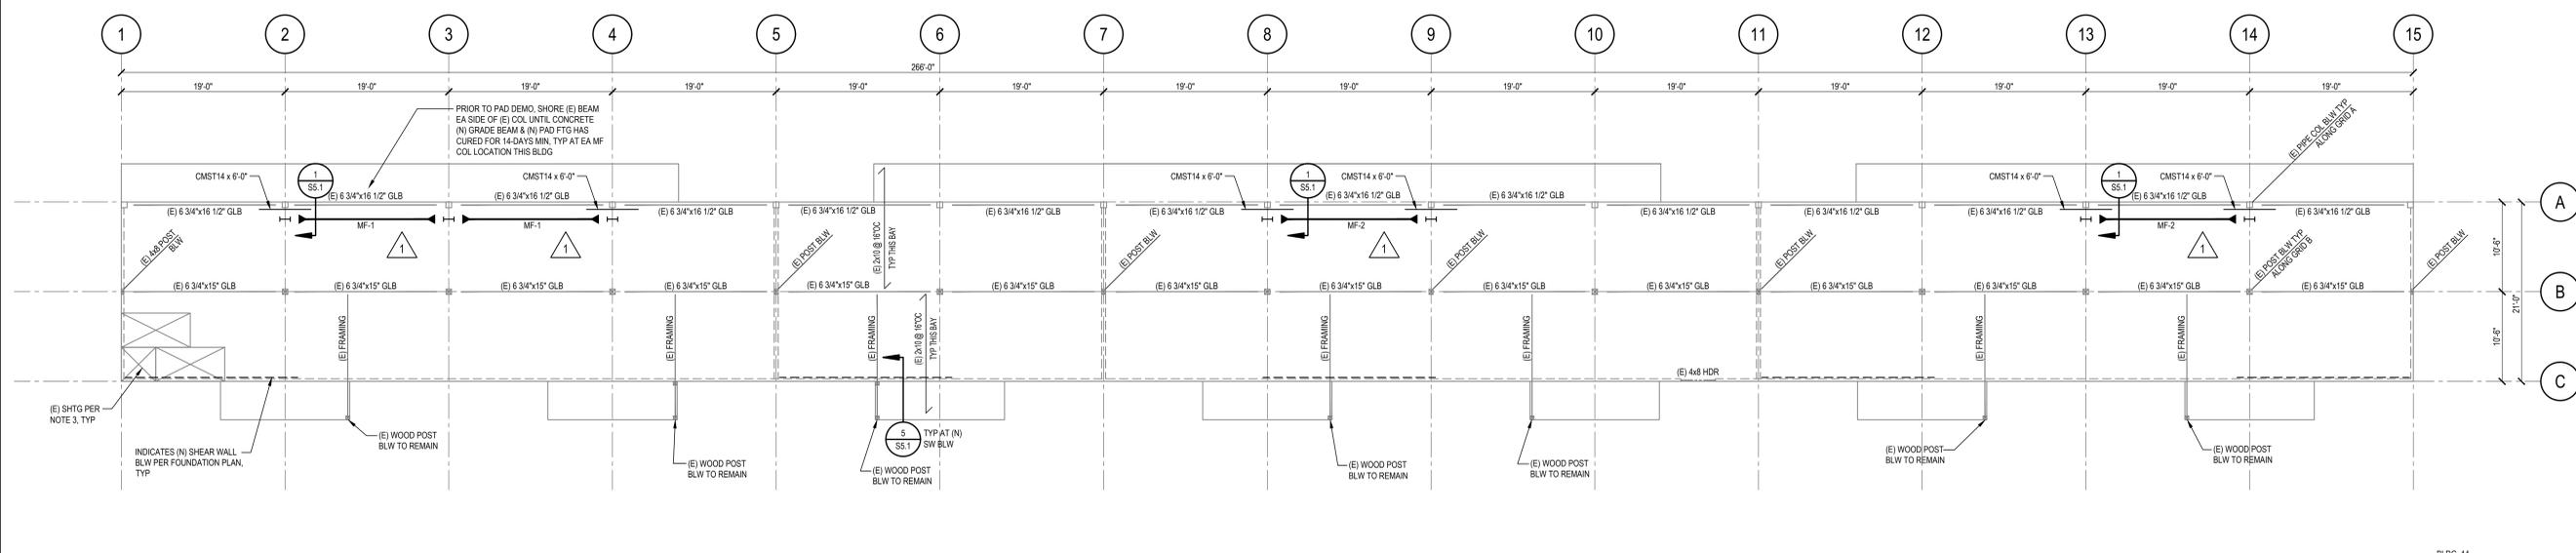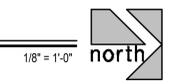

B SECOND FLOOR FRAMING PLAN - BUILDING 16

NOTES:
 1. SEE 15-52.1 FOR SCHEDULES, LEGEND AND PLAN NOTES.

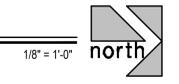

UNIVERSITY OF CALIFORNIA, RIVERSIDE
 FALKIRK SITE AND SEISMIC IMPROVEMENTS - SUMMER 2019
 3429 CANYON CREST DRIVE
 RIVERSIDE, CA 92507


REVISIONS	DESCRIPTION	DATE
1	ADDENDUM 1	6/14/19
2	ADDENDUM 2	6/28/19

UCR PROJECT #: 956390
 UCR CAAN #: P5673
 DATE: 05-10-2019
 DRAWN: M.B.V.

**BUILDING 16
 FOUNDATION &
 2ND FLOOR
 FRAMING PLANS
 S16-2.1**

OFFICE OF THE STATE FIRE MARSHAL
 APPROVED FIRE AND PANIC ONLY
07/02/2019
INSPECTIONS REQUIRED
 APPROVED
UC Riverside
KEY PLAN
 Building & Safety Division
 Campus Building Permit


1/2019/MI/1904011.00 - Falkirk, Site & Seismic Improvements Project/Drawings/MI/1904011.00_S16-2.1.dwg 6/28/19 9:58 AM/mimont

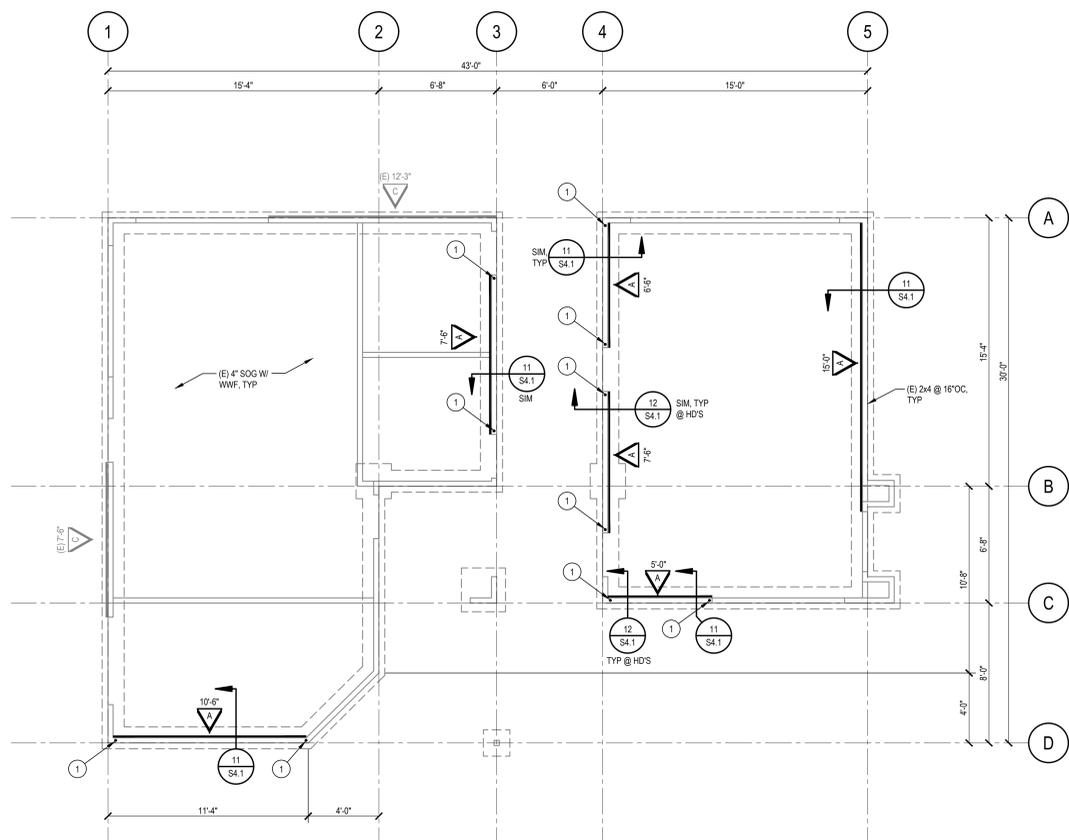

(A) FOUNDATION PLAN - BUILDING 20 (RECREATION CENTER)

NOTES:
 1. SEE 15-S2.1 FOR SCHEDULES, LEGEND AND PLAN NOTES.


1/4" = 1'-0" north

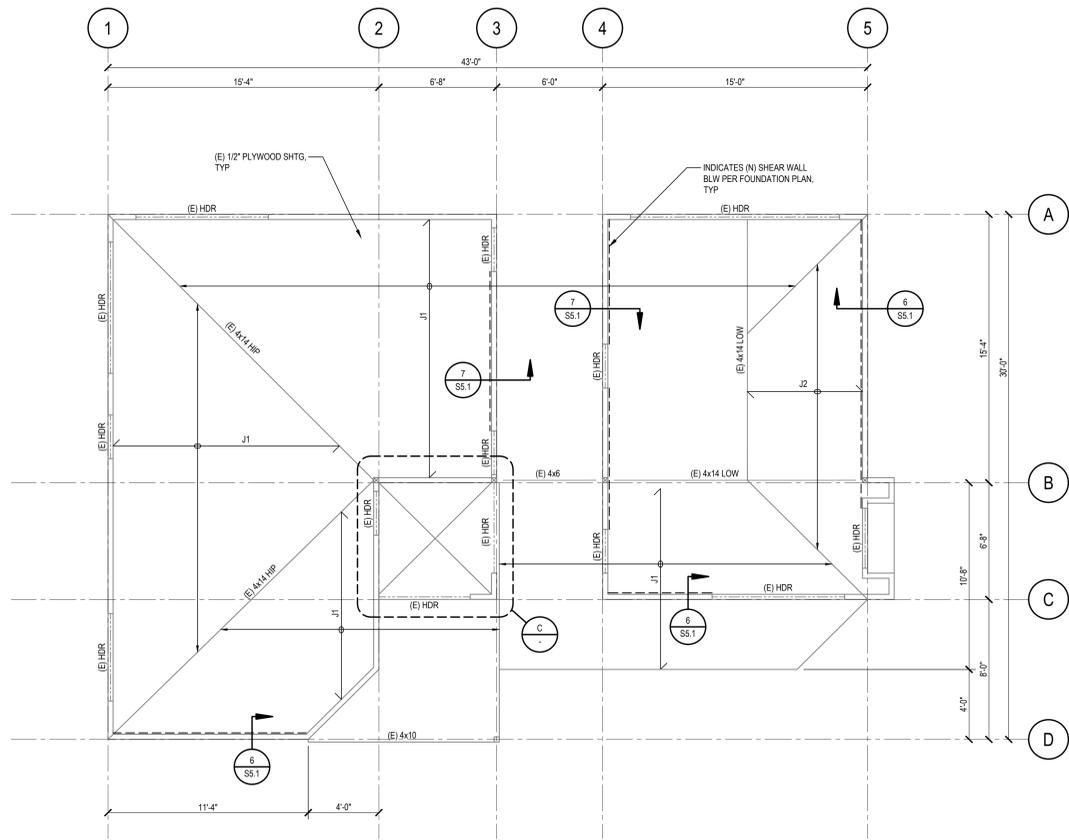

(B) ROOF FRAMING PLAN - BUILDING 20 (RECREATION CENTER)

NOTES:
 1. SEE 15-S2.1 FOR SCHEDULES, LEGEND AND PLAN NOTES.

1/4" = 1'-0" north

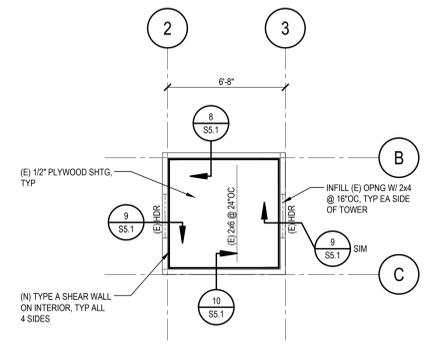


(C) TOWER HIGH ROOF FRAMING PLAN

1/4" = 1'-0"

(E) FRAMING SCHEDULE

MARK	SIZE
J1	2x8 @ 16"OC
J2	2x8 @ 24"OC

OFFICE OF THE STATE FIRE MARSHAL
 APPROVED FIRE AND PANIC ONLY
07/02/2019
 Approval of this plan does not authorize or approve any omission or deviation from applicable regulations. Final approval is subject to field inspection. One set of approved plans shall be available on the project site at all times.
 Reviewed by: *[Signature]*
 Fire and Life Safety Design/Engineer

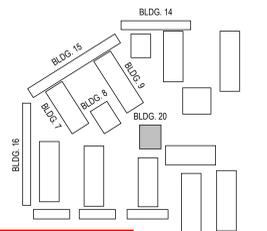

INSPECTIONS REQUIRED
 RIVERSIDE
 Office of Planning, Design & Construction
 Compliance Division
 BUILDING PERMIT
 CA 92507

APPROVED
 UC Riverside
 Planning & Construction
KEY PLAN
 Building & Safety Division
 Campus Building Permit



REVISIONS

1	ADDENDUM 1	6/14/19
2	ADDENDUM 2	6/28/19

UCR PROJECT #: 956390
 UCR CAAN #: P5673
 DATE: 05-10-2019
 DRAWN: M.B.V.

**BUILDING 20
 (REC CTR)
 FOUNDATION &
 ROOF FRAMING
 PLANS
 S20-2.1**




REVISIONS	DATE	DESCRIPTION
1	6/14/19	ADDENDUM 1
2	6/28/19	ADDENDUM 2


UCR PROJECT #: 956390
 UCR CAAN #: P5673
 DATE: 05-10-2019
 DRAWN: M.B.V.

STAIR FRAMING PLANS & DETAILS


S3.1

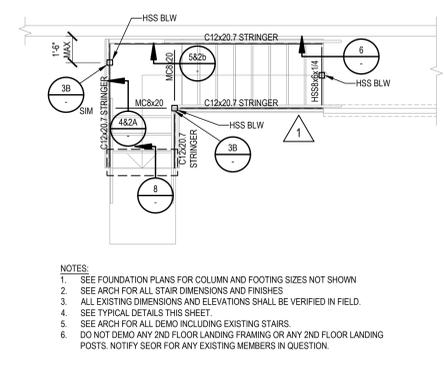


A TYPE-A STAIR FRAMING PLAN
 1/4"=1'-0"

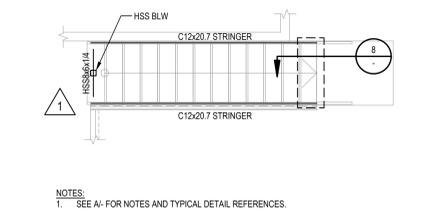


B TYPE-B STAIR FRAMING PLAN
 1/4"=1'-0"

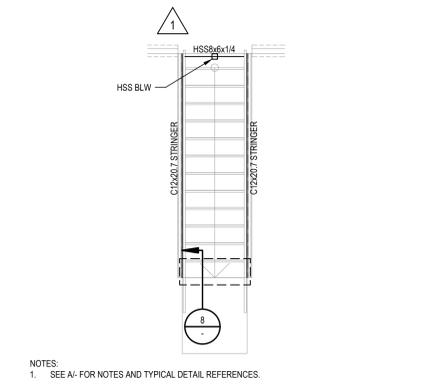


C TYPE-C STAIR FRAMING PLAN
 1/4"=1'-0"

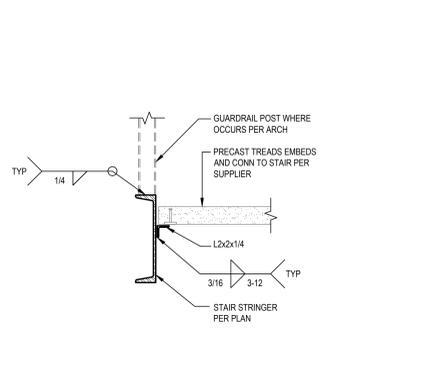


1 TYP PRECAST TREAD AT STRINGER
 1"=1'-0"

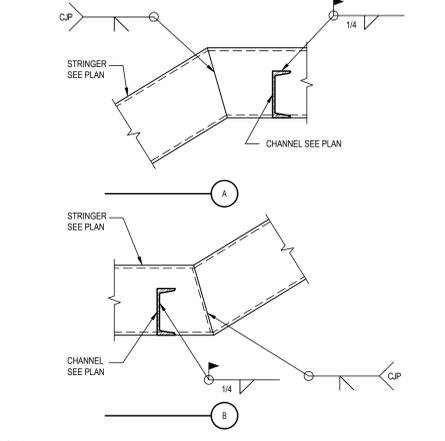


2 TYP BENT STRINGER CONNECTIONS
 1"=1'-0"

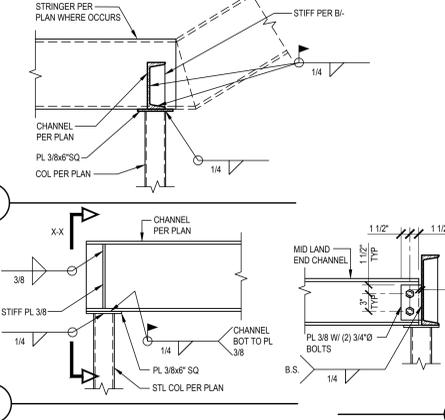


3 TYPICAL STRINGER POST DETAIL
 1"=1'-0"

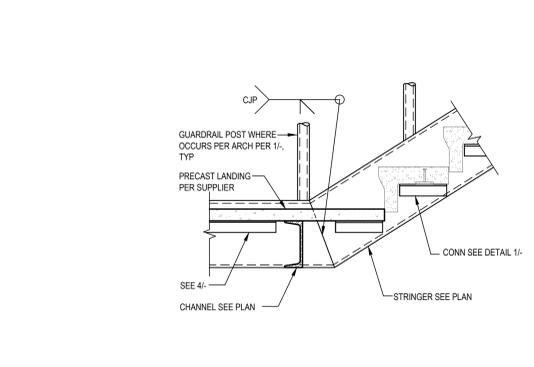


5 TYP PRECAST TREAD AT STRINGER
 1"=1'-0"

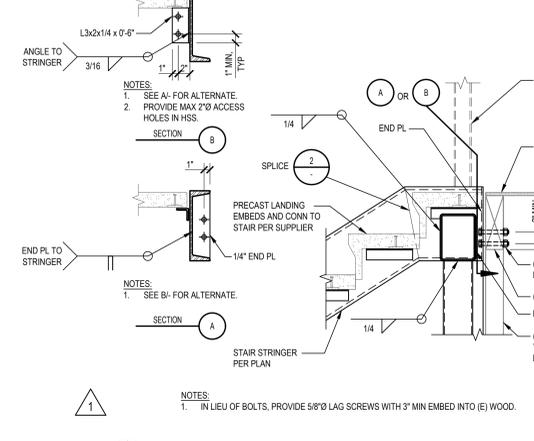


6 STRINGER AT WOOD LANDING
 1"=1'-0"

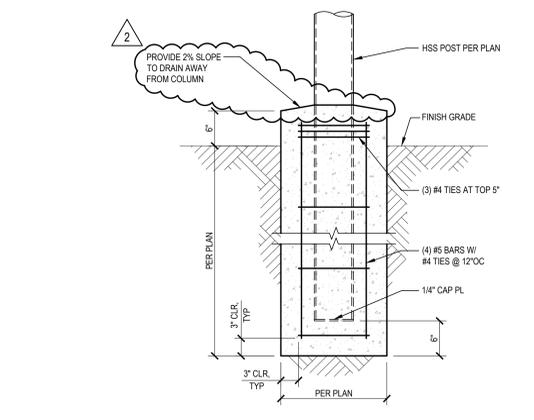

7 POST FOOTING DETAIL
 1"=1'-0"

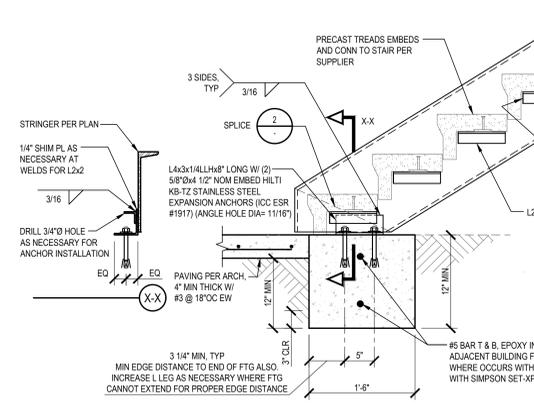

8 STRINGER AT FOUNDATION
 1"=1'-0"

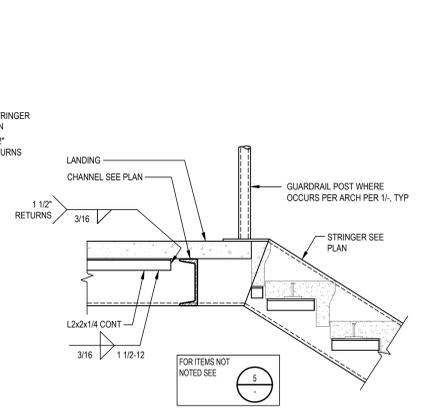

4 STAIRS AT MID LANDING
 1"=1'-0"

- NOTES:
 1. SEE FOUNDATION PLANS FOR COLUMN AND FOOTING SIZES NOT SHOWN
 2. SEE ARCH FOR ALL STAIR DIMENSIONS AND FINISHES
 3. ALL EXISTING DIMENSIONS AND ELEVATIONS SHALL BE VERIFIED IN FIELD.
 4. SEE TYPICAL DETAILS THIS SHEET
 5. SEE ARCH FOR ALL DEMO INCLUDING EXISTING STAIRS.
 6. DO NOT DEMO ANY 2ND FLOOR LANDING FRAMING OR ANY 2ND FLOOR LANDING POSTS. NOTIFY SEOR FOR ANY EXISTING MEMBERS IN QUESTION.

- NOTES:
 1. SEE A1- FOR NOTES AND TYPICAL DETAIL REFERENCES.


- NOTES:
 1. SEE A1- FOR NOTES AND TYPICAL DETAIL REFERENCES.

INSPECTIONS REQUIRED
 UC RIVERSIDE
 Office of Planning, Design & Construction
 Signed: *Robert K. Williams*
 Building, Safety and Compliance Division
 CAMPUS BUILDING PERMIT
 ALL WORK SHALL BE REVIEWED BY UC RIVERSIDE


APPROVED
 UC Riverside
 Planning, Design and Construction
 Campus Building Official
 Signature: *Robert K. Williams*
 Building & Safety Division
 Campus Building Permit

OFFICE OF THE STATE FIRE MARSHAL
 APPROVED FIRE AND PANIC ONLY
07/02/2019
 Approval of this plan does not authorize or approve any erection or deviation from applicable regulations. Final approval is subject to field inspection. One set of approved plans shall be available on the project site at all times.
 Reviewed by: *Scott Johnson*
 Fire and Life Safety Division


1/2019/MI1904011.00 - Falkirk, Site & Seismic Improvements Project/Drawings/MI1904011.00-S3.1.dwg 08/28/19 05:57 mrc/mrc

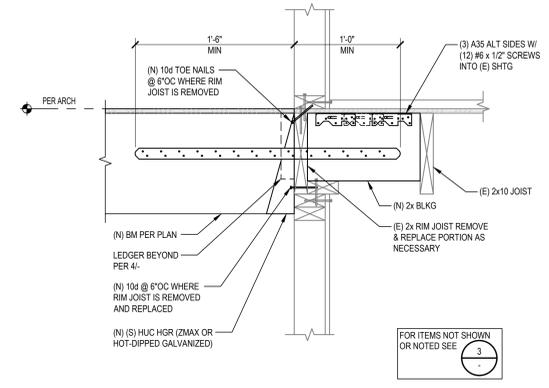



5 BALCONY BEAM TO (E) WALL AND (E) PERPENDICULAR JOISTS
1-1/2"=1'-0"

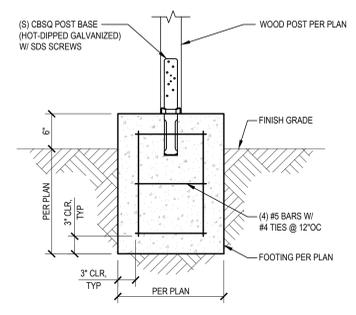


1 POST FOOTING DETAIL
1"=1'-0"

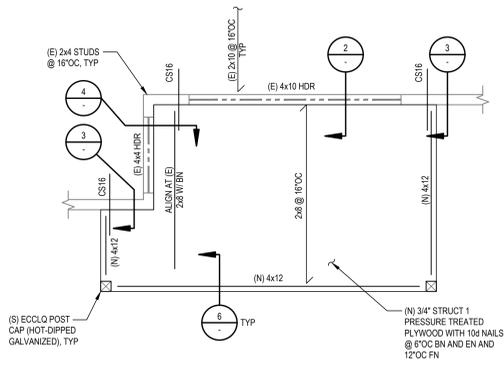


A TYPE-A BALCONY FRAMING PLAN (BLDG 7&8)
1/2"=1'-0"

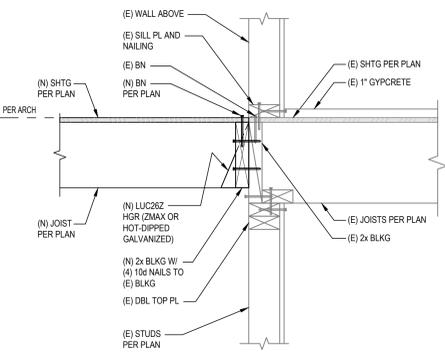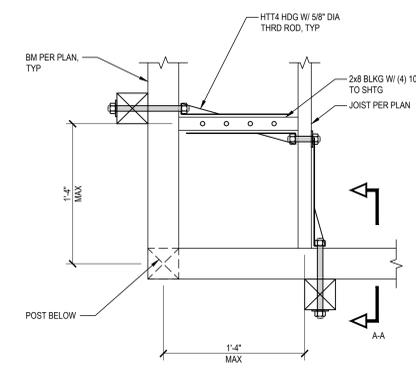


2 BALCONY JOISTS TO (E) WALL
1-1/2"=1'-0"

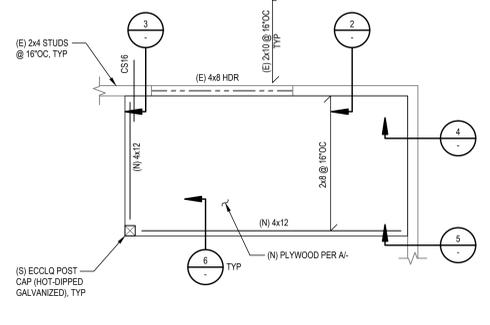


B TYPE-B BALCONY FRAMING PLAN (BLDG 9)
1/2"=1'-0"

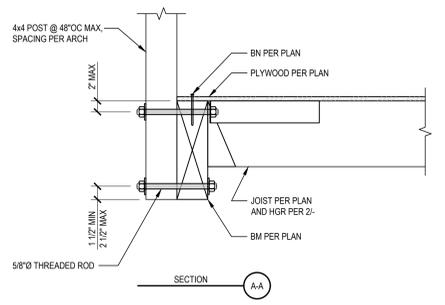


6 HANDRAIL POST CONNECTION
1-1/2"=1'-0"

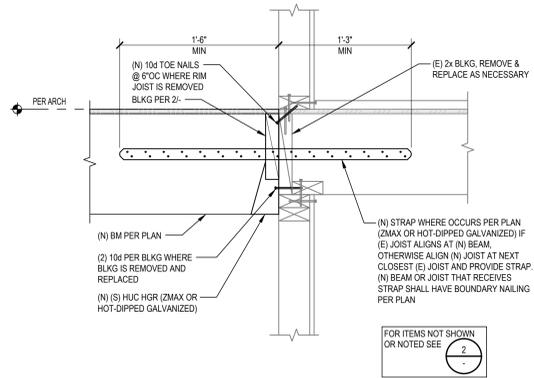


3 BALCONY BEAM TO (E) WALL AND (E) PARALLEL JOISTS
1-1/2"=1'-0"

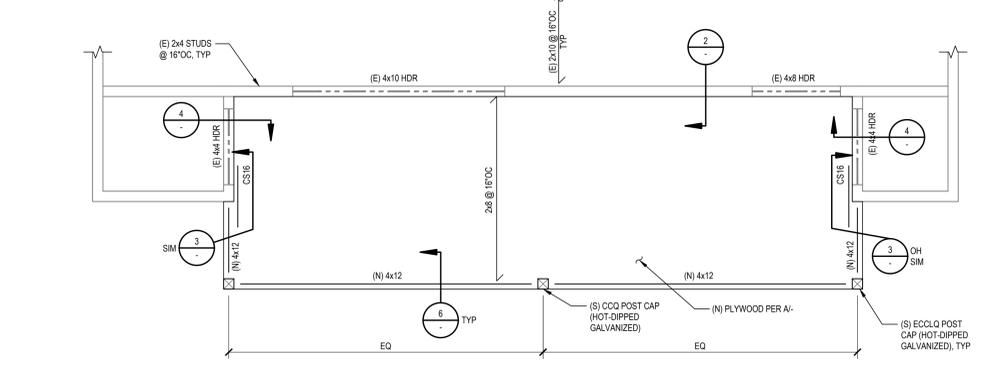

C TYPE-C BALCONY FRAMING PLAN (BLDG 9)
1/2"=1'-0"

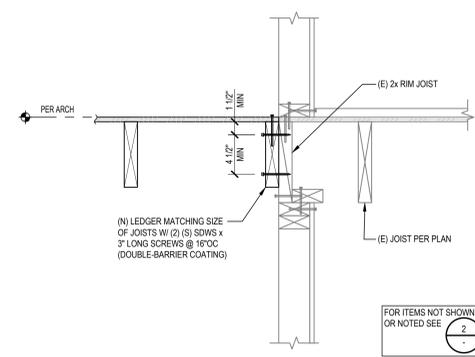

4 BALCONY LEDGER TO (E) WALL
1-1/2"=1'-0"

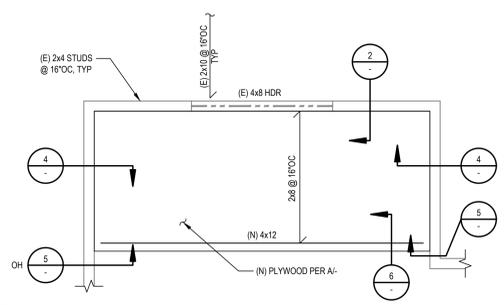

D TYPE-D BALCONY FRAMING PLAN (BLDG 9)
1/2"=1'-0"

- FRAMING PLAN NOTES**
- SEE S0.1 FOR GENERAL NOTES AND S1.1 AND THIS SHEET FOR TYPICAL DETAILS.
 - SEE S0.1 WOOD GENERAL NOTES FOR WOOD AND CONNECTORS EXPOSED TO THE ELEMENTS.
 - SEE FOUNDATION PLANS FOR COLUMN AND FOOTING SIZES NOT SHOWN.
 - SEE ARCH FOR ALL BALCONY DIMENSIONS, ELEVATIONS, FINISHES, WATERPROOFING AND DEMO.
 - EXISTING DIMENSIONS, ELEVATIONS AND FRAMING SHALL BE VERIFIED IN FIELD.

UNIVERSITY OF CALIFORNIA, RIVERSIDE
FALKIRK SITE AND SEISMIC IMPROVEMENTS - SUMMER 2019
3429 CANYON CREST DRIVE
RIVERSIDE, CA 92507

REVISIONS

1	ADDENDUM 1	6/14/19
2	ADDENDUM 2	6/28/19

UCR PROJECT #: 956390
UCR CAAN #: P5673
DATE: 05-10-2019
DRAWN: M.B.V.

BALCONY FRAMING PLANS & DETAILS
S3.2

OFFICE OF THE STATE FIRE MARSHAL
APPROVED FIRE AND PLUMB ONLY
07/02/2019
Approval of this plan does not constitute or approve any ordinance or deviation from applicable regulations. Final approval is subject to field inspection. One set of approved plans shall be available on the project site at all times.
Reviewed by: *[Signature]*
Fire and Life Safety Division

INSPECTIONS REQUIRED
UCR RIVERSIDE
Office of Planning, Design & Construction
Signed CBO: *[Signature]*
Building Safety and Compliance Division
BUILDING PERMITS
APPROVED

APPROVED
UC Riverside
Planning, Design and Construction
Campus Building Official
Signature: *[Signature]*
Building & Safety Division
BUILDING PERMITS
APPROVED

I:\2019\1904011.00 - Falkirk, Site & Seismic Improvements\ProjectDrawings\1904011.00-S3.2.dwg 08/02/19 05:58 mrcmcc

miyamoto.
 1901 East Alton Avenue, Suite 100
 Santa Ana, CA 92705
 MI1904011.00
 T: (949) 579-1770
 miyamotointernational.com















UNIVERSITY OF CALIFORNIA, RIVERSIDE
 FALKIRK SITE AND SEISMIC IMPROVEMENTS - SUMMER 2019
 3429 CANYON CREST DRIVE
 RIVERSIDE, CA 92507

REVISIONS	ADDENDUM 1	6/14/19
1	ADDENDUM 2	6/28/19

UCR PROJECT #: 956390
 UCR CAAN #: P5673
 DATE: 05-10-2019
 DRAWN: M.B.V.

FRAMING DETAILS
S5.1

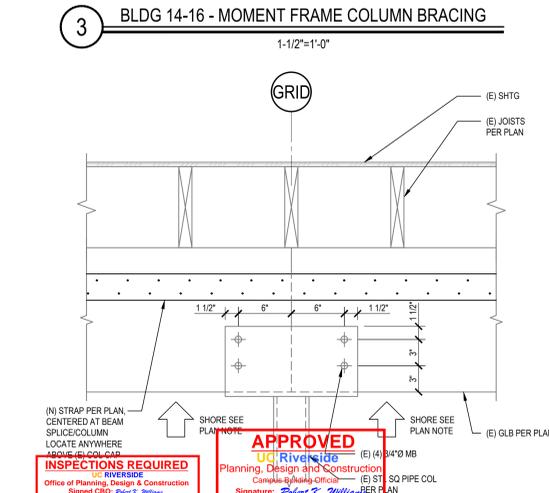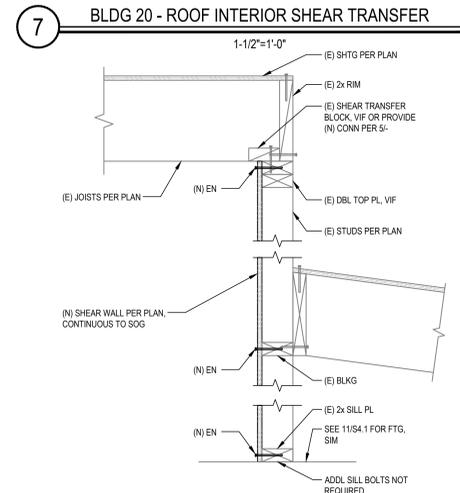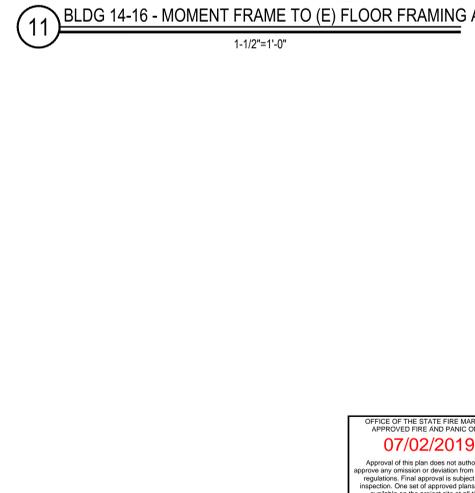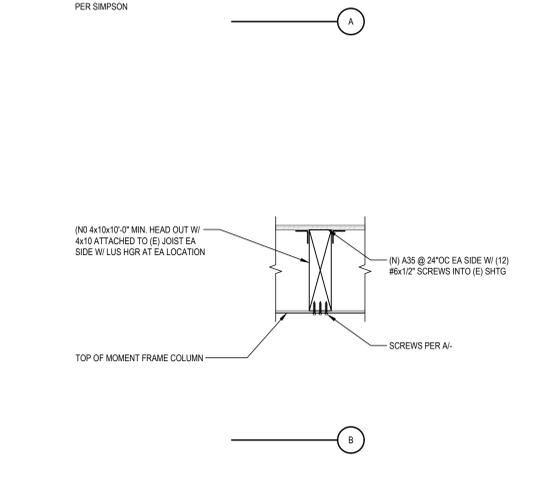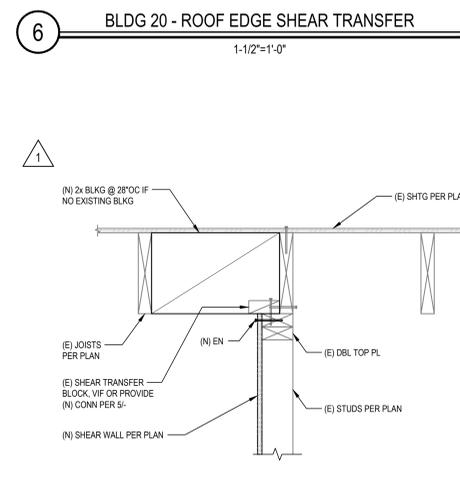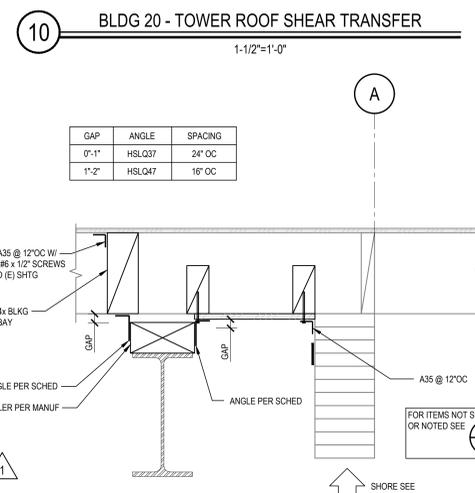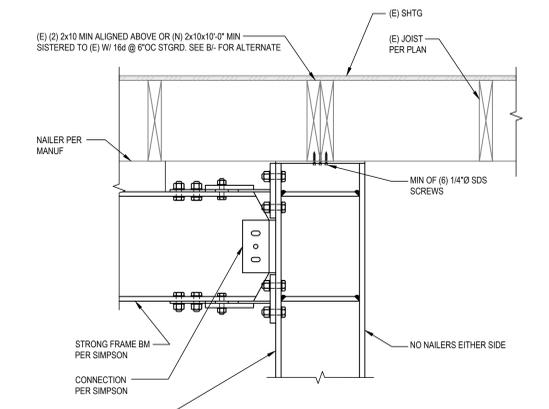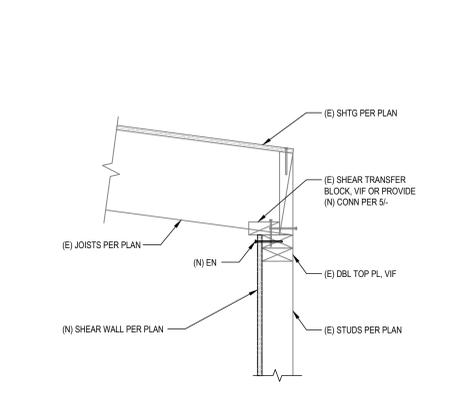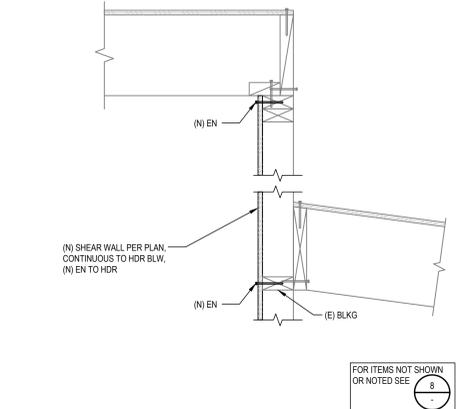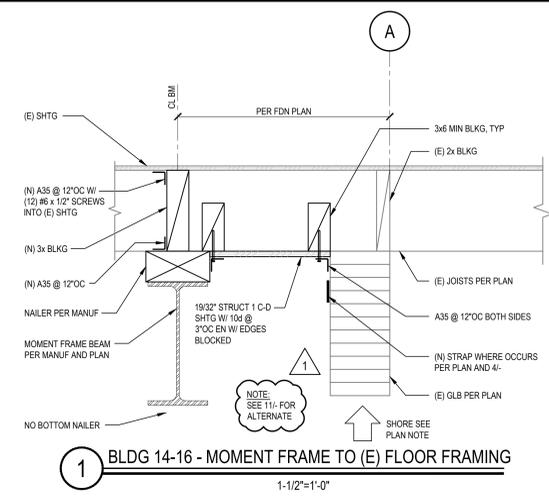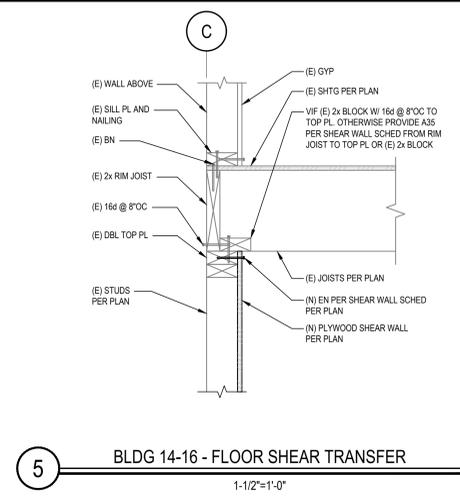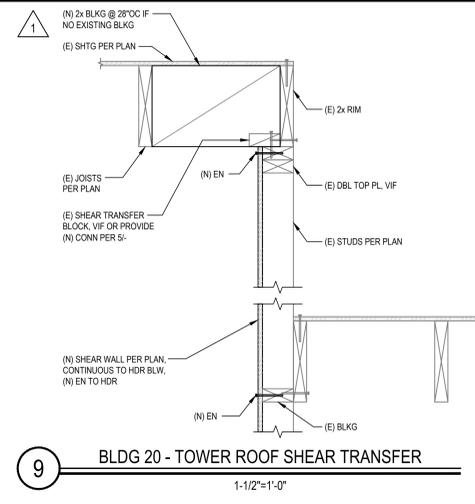

OFFICE OF THE STATE FIRE MARSHAL
 APPROVED FIRE AND PANIC ONLY
07/02/2019
 Approval of this plan does not authorize or approve any omission or deviation from applicable regulations. Final approval is subject to field inspection. One set of approved plans shall be available on the project site at all times.
 Reviewed by: *[Signature]*
 Fire and Life Safety Division

APPROVED
 UC Riverside
 Planning, Design and Construction
 Camille G. Belski, Director
 Signature: *Robert K. Williams*
 Building Safety and Compliance Division
 BUILDING PERMIT
 07/02/2019 09:58:00 AM

1/2019/MI1904011.00 - Falkirk, Site & Seismic Improvements Project/Drawings/MI1904011.00-S5.1.dwg 08/02/19 05:58 mrc/mrc

- GENERAL NOTES:**
- SIMPSON STRONG-TIE® STRONG FRAME® AND THE YIELD-LINK® STRUCTURAL FUSE ARE PROTECTED UNDER ONE OR MORE OF THE FOLLOWING US PATENTS AND APPLICATIONS: US PATENT NO. 8,001,734 B2, US PATENT NO. 8,375,652 B2, AND US PATENT PUBLICATION NO. 2015/0159362, AND MUST BE SUPPLIED OR LICENSED THROUGH SIMPSON STRONG-TIE.
 - STRONG FRAME® SPECIAL MOMENT FRAME IS MANUFACTURED AND TRADEMARKED BY "SIMPSON STRONG-TIE COMPANY INC." HOME OFFICE: 5956 W. LAS POSITAS BLVD., PLEASANTON, CA 94588 TEL: (800) 999-5099, FAX: (925) 847-1597. "SIMPSON STRONG-TIE COMPANY INC." IS AN ISO 9001 REGISTERED COMPANY.
 - DESIGN FOR STRONG FRAME® MOMENT FRAMES ARE IN ACCORDANCE WITH THE FOLLOWING:
 - 2015 AND 2012 INTERNATIONAL BUILDING CODE
 - AISC SPECIFICATION FOR STRUCTURAL STEEL BUILDINGS (ANSI/AISC 360-05, 360-10)
 - AISC SEISMIC PROVISIONS (ANSI/AISC 341-05, 341-10)
 - RCSC SPECIFICATION FOR STRUCTURAL JOINTS USING ASTM A325 OR A490 BOLTS
 - BUILDING CODE REQUIREMENTS FOR STRUCTURAL CONCRETE (ACI318-11, ACI318-14)
 - USE OF THIS PRODUCT IS SUBJECT TO THE APPROVAL OF THE LOCAL BUILDING DEPARTMENT.
 - THIS PRODUCT IS PART OF THE OVERALL LATERAL FORCE RESISTING SYSTEM OF THE STRUCTURE. DESIGN OF THE BUILDING'S LATERAL FORCE RESISTING SYSTEM, INCLUDING THE LOAD PATH TO TRANSFER LATERAL FORCES FROM THE STRUCTURE TO THE GROUND, IS THE RESPONSIBILITY OF THE DESIGNER.
 - THE DESIGNER MUST SPECIFY THE REQUIRED COMPONENTS OF THE COMPLETE LOAD TRANSFER PATH INCLUDING DIAPHRAGMS, SHEAR TRANSFER, CHORDS AND COLLECTORS AND FOUNDATIONS.
 - ALL CONNECTED MEMBERS AND RELATED ELEMENTS SHALL BE DESIGNED BY THE DESIGNER.
 - DESIGNER IS PERMITTED TO MODIFY DETAILS FOR SPECIFIC CONDITIONS. SEE LIMITATIONS NOTED ON SHEET SMF3.
 - ANCHORAGE LENGTHS PROVIDED ARE SHOWN FOR MINIMUM EMBEDMENT INTO FOOTING BASED ON TENSION ANCHORAGE DESIGN ONLY. ACTUAL LENGTH OF ANCHORAGE SHALL BE PER DESIGNER'S SPECIFICATIONS AND PROJECT SPECIFIC INSTALLATION REQUIREMENTS.
 - PRE-ASSEMBLED ANCHORAGE KITS PROVIDED BY SIMPSON (MFSL OR MFAB) SHALL BE SPECIFIED BY DESIGNER AND SHOULD INCLUDE ANCHORAGE TYPE, ROD GRADE, AND LENGTH OF ASSEMBLY. REFER TO DETAIL 2 FOR AVAILABLE LENGTHS OF FULLY ASSEMBLED ANCHORAGE ASSEMBLIES. EXTENSION KITS IN 36" LENGTHS ARE AVAILABLE FOR USE IN STEMWALLS OR APPLICATIONS WHERE DEEPER EMBEDMENT IS REQUIRED.
 - FOOTING DIMENSIONS SHOWN ARE THE MINIMUMS REQUIRED FOR CONCRETE ANCHORAGE REQUIREMENTS ONLY. THE DESIGNER MUST DETERMINE REQUIRED FOOTING SIZE AND REINFORCING FOR OTHER DESIGN LIMITS, SUCH AS FOUNDATION SHEAR AND BENDING, SOIL BEARING SHEAR TRANSFER, AND FRAME STABILITY / OVERTURNING.
 - DESIGNER MUST DETAIL ACTUAL FOOTING / GRADE BEAM SIZE AND REINFORCING.
 - HOLES IN BASE PLATES ARE OVER-SIZED FOR ERECTION TOLERANCE. DESIGNER MUST EVALUATE EFFECTS OF OVER-SIZED HOLES AND PROVIDE PLATE WASHER WITH STANDARD-SIZE HOLES WELDED TO BASE PLATE OR REQUEST BASE PLATES WITH STANDARD SIZE HOLES WHERE REQUIRED.
 - THE CONTRACTOR SHALL VERIFY ALL DIMENSIONS, CONDITIONS, ELEVATIONS, ETC. PRIOR TO INSTALLATION OF ANY COMPONENTS FOR THE STEEL STRONG FRAME SYSTEM. IF ANY DISCREPANCIES ARE FOUND, THEY SHALL BE BROUGHT TO THE ATTENTION OF THE DESIGNER FOR CLARIFICATION PRIOR TO CONSTRUCTION.
 - INSTALLATION OF PRODUCT SHALL BE DONE IN CONFORMANCE WITH THESE DRAWINGS AND ICC ESR-2802. THE PERFORMANCE OF MODIFIED PRODUCTS OR ALTERED INSTALLATION PROCEDURES ARE THE SOLE RESPONSIBILITY OF THE DESIGNER.
 - SIMPSON STRONG-TIE® COMPANY, INC. RESERVES THE RIGHT TO CHANGE SPECIFICATIONS, DESIGNS, AND MODELS WITHOUT NOTICE OR LIABILITY FOR SUCH CHANGES.
 - ALL HARDWARE CALLED OUT IS SIMPSON STRONG-TIE®.
 - USE OF A SIMPSON STRONG-TIE PRODUCT DOES NOT IMPLY THAT SIMPSON STRONG-TIE ENDORSES ANY PROJECT, STRUCTURE OR USE. NO LICENSE IS GRANTED WITH RESPECT TO ANY SIMPSON STRONG-TIE TRADEMARK OR OTHER INTELLECTUAL PROPERTY RIGHTS. WRITTEN PERMISSION MUST BE OBTAINED PRIOR TO USING ANY SIMPSON STRONG-TIE TRADEMARKS OR PROPRIETARY DOCUMENTS AND MATERIALS.
 - SIMPSON STRONG-TIE IS NOT AFFILIATED WITH, AND DOES NOT SPONSOR OR ENDORSE, THE DESIGNER, INSTALLER OR USERS OF THIS DRAWING, NOR DOES SIMPSON STRONG-TIE HAVE ANY JOINT VENTURE, PARTNERSHIP, AGENCY, EMPLOYMENT OR FIDUCIARY RELATIONSHIP WITH SUCH PERSONS.

- MATERIAL:**
- BARS/PLATES: ASTM 572 GR. 50, ASTM A529 GR. 50, OR ASTM A1011 HSLAS GR. 50
 - W-SECTIONS (HOT ROLLED SECTIONS): ASTM A992
 - LINK TO COLUMN FLANGE HIGH STRENGTH BOLTS: 7/8" DIA. ASTM A325, TYPE 1 (SNUG-TIGHT)
 - BRP TO BEAM FLANGE AND SHEAR PLATE TO BEAM WEB HIGH STRENGTH BOLTS: ASTM A325, TYPE 1 (SNUG-TIGHT)
 - LINK TO BEAM FLANGE HIGH STRENGTH BOLTS: ASTM F2280 TWIST OFF TYPE (A490 EQUIVALENT) (PRETENSIONED)
 - BEAM TOP FLANGE WOOD NAILER BOLT: ASTM A307 GR. A
 - CARRIAGE BOLTS: ASTM A307 GR. A
 - ANCHOR RODS: ASTM F1554 GR 36 OR A36 (MFAB, MFSL, AND MF-ATR6EXT-LS); ASTM A449 (MFAB-HS, MFSL-HS, AND MF-ATR6EXT-HS)
 - GROUT: ASTM C1107, MINIMUM 5,000 PSI COMPRESSIVE STRENGTH

INSTALLATION AND FIELD MODIFICATIONS:

THESE GENERAL INSTRUCTIONS FOR THE INSTALLER ARE PROVIDED TO ENSURE PROPER SELECTION AND INSTALLATION OF SIMPSON STRONG-TIE COMPANY INC. PRODUCTS AND MUST BE FOLLOWED CAREFULLY. THESE GENERAL INSTRUCTIONS ARE IN ADDITION TO THE SPECIFIC INSTALLATION INSTRUCTIONS AND NOTES PROVIDED FOR EACH PARTICULAR PRODUCT, ALL OF WHICH SHOULD BE CONSULTED PRIOR TO AND DURING INSTALLATION OF SIMPSON STRONG-TIE COMPANY INC. PRODUCTS.

- PROPER PRODUCT INSTALLATION REQUIRES CAREFUL ATTENTION TO ALL NOTES AND INSTRUCTIONS. IN ADDITIONAL TO THE NOTES, WARNINGS, AND INSTRUCTIONS PROVIDED IN THE CATALOG, INSTALLERS, DESIGNERS, ENGINEERS AND CONSUMERS SHOULD CONSULT THE SIMPSON STRONG-TIE COMPANY INC. WEBSITE AT WWW.STRONGTIE.COM TO OBTAIN ADDITIONAL INFORMATION FOR INSTALLATION, SPECIFICATIONS, CODE REPORTS, TECHNICAL FLIERS AND BULLETINS, FAQs, AND OTHER PERTINENT INFORMATION.
- PROVIDE TEMPORARY DIAGONAL BRACING OF STRONG FRAME® AS REQUIRED UNTIL FRAME IS TIED INTO THE FLOOR OR ROOF FRAMING ABOVE.
- USE PROPER SAFETY AND INSTALLATION EQUIPMENT DURING INSTALLATION OF STRONG FRAME®.
- ALL SPECIFIED FASTENERS MUST BE INSTALLED ACCORDING TO THE INSTRUCTIONS PROVIDED IN THE CATALOG, CODE REPORT, AND INSTALLATION DETAILS. INCORRECT FASTENER QUANTITY, SIZE, PLACEMENT, TYPE, MATERIAL, OR FINISH MAY CAUSE THE CONNECTION TO FAIL.
- FILL ALL FASTENER HOLES AS SPECIFIED IN THE INSTALLATION INSTRUCTIONS FOR THE SPECIFIED PRODUCT. INSTALL ALL FASTENERS BEFORE LOADING THE FRAME. SOME PRE-INSTALLED ITEMS MAY NOT USE ALL HOLES.
- NUTS SHALL BE INSTALLED SUCH THAT THE END OF THE THREADED ROD OR BOLT IS AT LEAST FLUSH WITH THE TOP OF THE NUT.
- REFER TO DETAIL 12/SMF3 FOR ALLOWABLE HOLE OPENINGS IN BEAM AND COLUMNS.
- WELDING SHALL BE IN ACCORDANCE WITH AWS D1.1 AND AWS D1.8 (AS APPLICABLE FOR SEISMIC). WELDS SHALL BE SPECIFIED BY THE DESIGNER. PROVIDE WELDING SPECIAL INSPECTION AS REQUIRED BY THE LOCAL BUILDING DEPARTMENT.

- INSPECTIONS:**
- WELDING OF FRAME MEMBERS AND APPLICABLE WELDING SPECIAL INSPECTIONS REQUIRED BY IBC SECTION 1707 ARE PERFORMED ON THE PREMISES OF A FABRICATOR REGISTERED AND APPROVED IN ACCORDANCE WITH THE REQUIREMENTS OF IBC SECTION 1704.2.5 FOR FABRICATOR APPROVAL.
 - PRE-INSTALLATION VERIFICATION TESTING IS PERFORMED ON HIGH-STRENGTH FASTENER ASSEMBLIES.
 - INSPECTION REQUIREMENTS OUTSIDE THE SHOP MANUFACTURING AND ASSEMBLY PROCESS SHALL BE IN ACCORDANCE WITH THE LOCAL CODE, BASED ON BUILDING OCCUPANCY, CONCRETE STRENGTH, REQUIREMENTS OF THE LOCAL BUILDING OFFICIAL, AND OTHER CONSIDERATIONS AND SHALL BE SPECIFIED BY THE DESIGNER.
 - GROUTING UNDER COLUMN BASE PLATE MAY REQUIRE SPECIAL INSPECTION, CONTACT THE LOCAL BUILDING DEPARTMENT FOR COMPLIANCE REQUIREMENTS.
 - CONTACT SIMPSON STRONG-TIE® AT 800-999-5099 TO REQUEST PRE-INSTALLATION TESTING, WELDING REPORTS, MILL CERTS, ETC. WHEN REQUIRED.


GENERAL NOTES 1

MODEL NO.	ROD SIZE & NUMBER	LENGTH (in)	l _a (in)	BEARING PLATE (in)
ALL SMF COLUMNS				
MFAB3.75-14-6	4 - 3/8"	14	8	3/8" x 7 x 7
MFAB3.75-14-HS6	4 - 3/8"	14	8	
MFAB3.75-18-6	4 - 3/8"	18	12	
MFAB3.75-18-HS6	4 - 3/8"	18	12	
MFAB3.75-24-6	4 - 3/8"	24	18	
MFAB3.75-24-HS6	4 - 3/8"	24	18	
MFAB3.75-30-6	4 - 3/8"	30	24	
MFAB3.75-30-HS6	4 - 3/8"	30	24	
MFAB3.75-36-6	4 - 3/8"	36	30	
MFAB3.75-36-HS6	4 - 3/8"	36	30	


THE MFAB ANCHOR ASSEMBLIES HAVE BEEN ENGINEERED TO PROVIDE A SOLUTION MEETING THE 2012 AND 2015 INTERNATIONAL BUILDING CODE REQUIREMENTS FOR BOTH TENSION AND SHEAR.

INSPECTION IS EASY; THE HEAD IS STAMPED WITH A "NO EQUAL" SYMBOL FOR IDENTIFICATION, BOLT LENGTH, BOLT DIAMETER, AND OPTIONAL "HS" FOR HIGH STRENGTH IF SPECIFIED.


MFAB ANCHOR ASSEMBLIES REQUIRE ADDITIONAL REINFORCING TO PROVIDE A COMPLETE TENSION AND SHEAR SOLUTION. DESIGNER MUST SPECIFY ADDITIONAL REINFORCING TIES OR HAIRPINS AS REQUIRED FOR SHEAR.

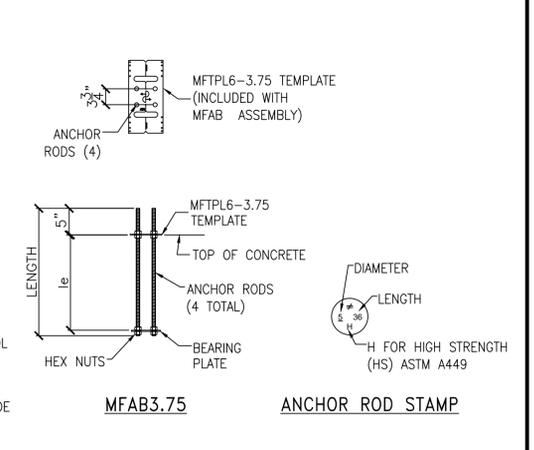


MFAB ANCHORAGE ASSEMBLIES 2

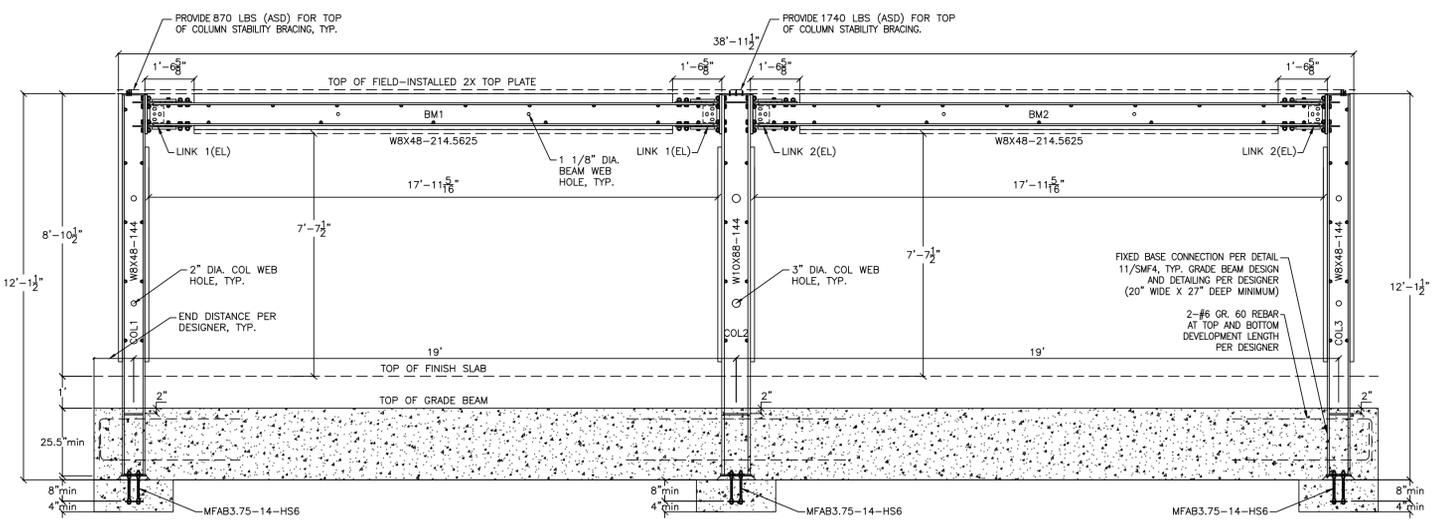


NOTE: REFER TO GENERAL NOTES 9, 10, 11, AND 12 REGARDING MINIMUM ANCHORAGE LENGTHS, ANCHORAGE EMBEDMENT, AND FOOTING DIMENSIONS, REINFORCING, AND DESIGN.

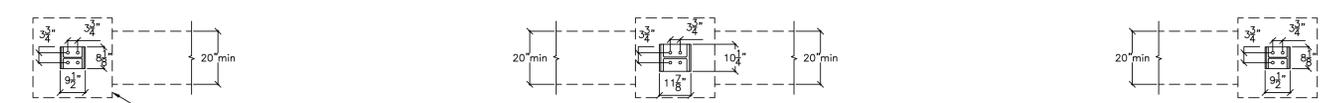

FRAME ELEVATION
SCALE: 3/8" = 1'-0"

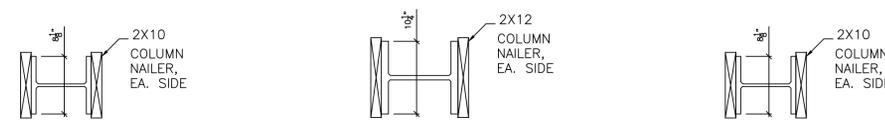

COLUMN SECTION
SCALE: 1" = 1'-0"

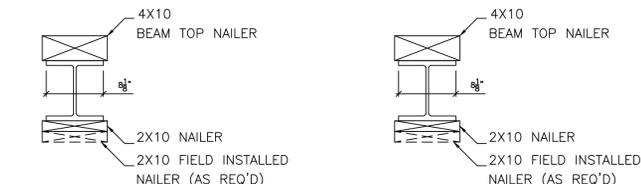


BEAM SECTION
SCALE: 1" = 1'-0"

OFFICE OF THE STATE FIRE MARSHAL
APPROVED FIRE AND PANIC ONLY
07/02/2019
Approval of this plan does not authorize or approve any omission or deviation from applicable regulations. Final approval is subject to field inspection. One set of approved plans shall be available on the project site at all times.
Reviewed by: *Scott Johnson*
Fire and Life Safety Division/600m

Simpson Strong-Tie® Strong Frame® and the Yield-Link™ structural fuse are protected under one or more of the following US patents and applications: US patent No. 8,001,734 B2, US patent No. 8,375,652 B2, and US patent publication No. 2015/0159362, and must be supplied or licensed through Simpson Strong-Tie.

REVISIONS

NO.	DATE	

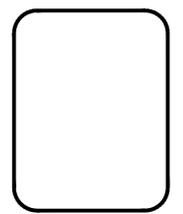


THE MOMENT FRAME(S) IS DESIGNED FOLLOWING INFORMATION PROVIDED BY: Myamoto Information, Inc. DATE OF PLANS (D.O.P.): 8/17/2018 PROVIDED TO SIMPSON STRONG-TIE BY: Jonathan Buckley


STRONG-FRAME®
FRAME ELEVATION DRAWING
ENGINEERED DESIGN
3429 CANYON CREST DRIVE - MF-1

NAME: D.H.
DATE: 08/17/2018
SCALE: N.T.S.
SHEET:
MF-1


JOB NO. ES-183167
6-14-2019 ADDENDUM 1 SUBMITTAL SET
07/02/2019

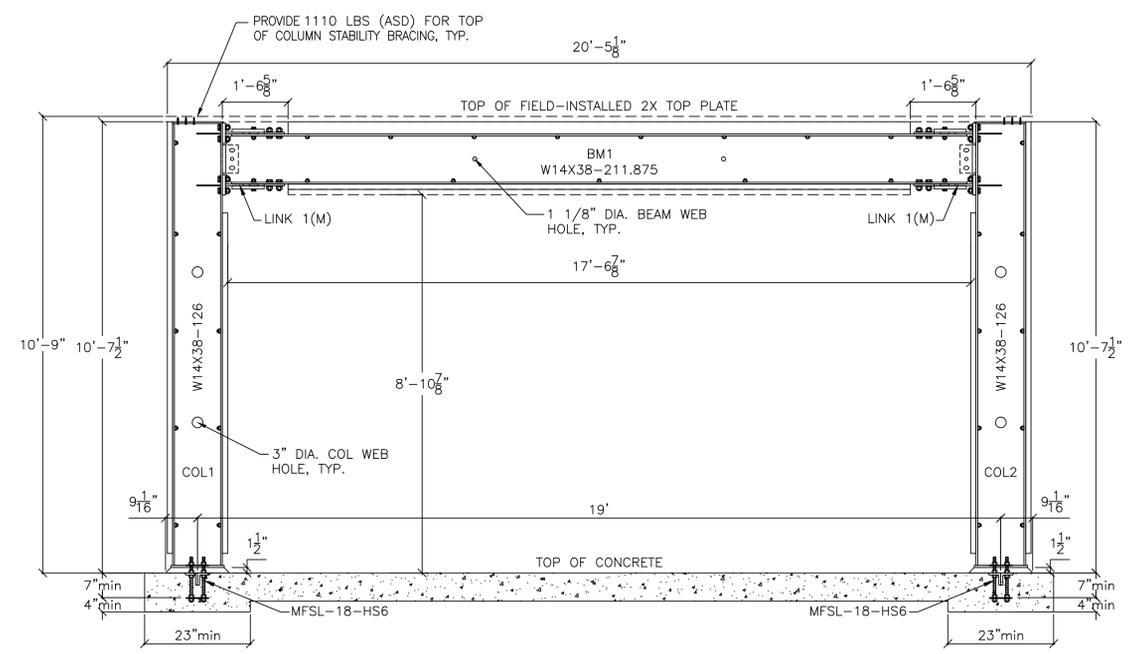

NOTE:
REFER TO GENERAL NOTES 9, 10, 11, AND 12 REGARDING
MINIMUM ANCHORAGE LENGTHS, ANCHORAGE EMBEDMENT, AND
FOOTING DIMENSIONS, REINFORCING, AND DESIGN.

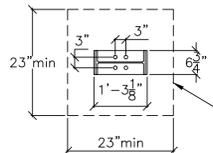

CONCRETE FOUNDATION
23" SQUARE MIN., TYP.

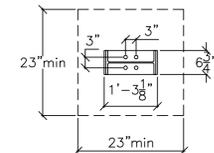


FRAME MODEL: SMFX1414-211.875x126-M

FRAME ELEVATION
SCALE: 1/2" = 1'-0"



COLUMN SECTION
SCALE: 1" = 1'-0"

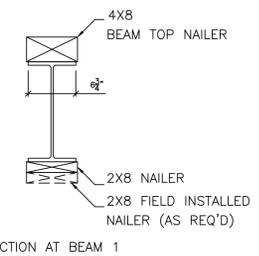

BEAM SECTION
SCALE: 1" = 1'-0"

APPROVED
UC Riverside
Planning, Design and Construction
Campus Building Official
Signature: Robert K. Williams
Building & Safety Division
Campus Building Permit

INSPECTIONS REQUIRED
UC RIVERSIDE
Office of Planning, Design & Construction
Signed CBO: Robert K. Williams
Building, Safety and Compliance Division
CAMPUS BUILDING PERMIT
ALL INSPECTIONS SHALL BE REQUESTED USING THE eCIBS SYSTEM

OFFICE OF THE STATE FIRE MARSHAL
APPROVED FIRE AND PANIC ONLY
07/02/2019
Approval of this plan does not authorize or
approve any omission or deviation from applicable
regulations. Final approval is subject to field
inspection. One set of approved plans shall be
available on the project site at all times.
Reviewed by: *Scott Johnson*
Fire and Life Safety Division

GENERAL NOTES:

- SIMPSON STRONG-TIE® STRONG FRAME® AND THE YIELD-LINK® STRUCTURAL FUSE ARE PROTECTED UNDER ONE OR MORE OF THE FOLLOWING US PATENTS AND APPLICATIONS: US PATENT NO. 8,001,734 B2, US PATENT NO. 8,375,652 B2, AND US PATENT PUBLICATION NO. 2015/0159362, AND MUST BE SUPPLIED OR LICENSED THROUGH SIMPSON STRONG-TIE.
- STRONG FRAME® SPECIAL MOMENT FRAME IS MANUFACTURED AND TRADEMARKED BY "SIMPSON STRONG-TIE COMPANY INC." HOME OFFICE: 5956 W. LAS POSITAS BLVD., PLEASANTON, CA 94588 TEL: (800) 999-5099, FAX: (925) 847-1597. "SIMPSON STRONG-TIE COMPANY INC." IS AN ISO 9001 REGISTERED COMPANY.
- DESIGN FOR STRONG FRAME® MOMENT FRAMES ARE IN ACCORDANCE WITH THE FOLLOWING:
 - 2015 AND 2012 INTERNATIONAL BUILDING CODE
 - AISC SPECIFICATION FOR STRUCTURAL STEEL BUILDINGS (ANSI/AISC 360-05, 360-10)
 - AISC SEISMIC PROVISIONS (ANSI/AISC 341-05, 341-10)
 - RCSC SPECIFICATION FOR STRUCTURAL JOINTS USING ASTM A325 OR A490 BOLTS
 - BUILDING CODE REQUIREMENTS FOR STRUCTURAL CONCRETE (ACI318-11, ACI318-14)
- USE OF THIS PRODUCT IS SUBJECT TO THE APPROVAL OF THE LOCAL BUILDING DEPARTMENT.
- THIS PRODUCT IS PART OF THE OVERALL LATERAL FORCE RESISTING SYSTEM OF THE STRUCTURE. DESIGN OF THE BUILDING'S LATERAL FORCE RESISTING SYSTEM, INCLUDING THE LOAD PATH TO TRANSFER LATERAL FORCES FROM THE STRUCTURE TO THE GROUND, IS THE RESPONSIBILITY OF THE DESIGNER.
- THE DESIGNER MUST SPECIFY THE REQUIRED COMPONENTS OF THE COMPLETE LOAD TRANSFER PATH INCLUDING DIAPHRAGMS, SHEAR TRANSFER, CHORDS AND COLLECTORS AND FOUNDATIONS.
- ALL CONNECTED MEMBERS AND RELATED ELEMENTS SHALL BE DESIGNED BY THE DESIGNER.
- DESIGNER IS PERMITTED TO MODIFY DETAILS FOR SPECIFIC CONDITIONS. SEE LIMITATIONS NOTED ON SHEET SMF3.
- ANCHORAGE LENGTHS PROVIDED ARE SHOWN FOR MINIMUM EMBEDMENT INTO FOOTING BASED ON TENSION ANCHORAGE DESIGN ONLY. ACTUAL LENGTH OF ANCHORAGE SHALL BE PER DESIGNER'S SPECIFICATIONS AND PROJECT SPECIFIC INSTALLATION REQUIREMENTS.
- PRE-ASSEMBLED ANCHORAGE KITS PROVIDED BY SIMPSON (MFSL OR MFAB) SHALL BE SPECIFIED BY DESIGNER AND SHOULD INCLUDE ANCHORAGE TYPE, ROD GRADE, AND LENGTH OF ASSEMBLY. REFER TO DETAIL 2 FOR AVAILABLE LENGTHS OF FULLY ASSEMBLED ANCHORAGE ASSEMBLIES. EXTENSION KITS IN 36" LENGTHS ARE AVAILABLE FOR USE IN STEMWALLS OR APPLICATIONS WHERE DEEPER EMBEDMENT IS REQUIRED.
- FOOTING DIMENSIONS SHOWN ARE THE MINIMUMS REQUIRED FOR CONCRETE ANCHORAGE REQUIREMENTS ONLY. THE DESIGNER MUST DETERMINE REQUIRED FOOTING SIZE AND REINFORCING FOR OTHER DESIGN LIMITS, SUCH AS FOUNDATION SHEAR AND BENDING, SOIL BEARING SHEAR TRANSFER, AND FRAME STABILITY / OVERTURNING.
- DESIGNER MUST DETAIL ACTUAL FOOTING / GRADE BEAM SIZE AND REINFORCING.
- HOLES IN BASE PLATES ARE OVER-SIZED FOR ERECTION TOLERANCE. DESIGNER MUST EVALUATE EFFECTS OF OVER-SIZED HOLES AND PROVIDE PLATE WASHER WITH STANDARD-SIZE HOLES WELDED TO BASE PLATE OR REQUEST BASE PLATES WITH STANDARD SIZE HOLES WHERE REQUIRED.
- THE CONTRACTOR SHALL VERIFY ALL DIMENSIONS, CONDITIONS, ELEVATIONS, ETC. PRIOR TO INSTALLATION OF ANY COMPONENTS FOR THE STEEL STRONG FRAME SYSTEM. IF ANY DISCREPANCIES ARE FOUND, THEY SHALL BE BROUGHT TO THE ATTENTION OF THE DESIGNER FOR CLARIFICATION PRIOR TO CONSTRUCTION.
- INSTALLATION OF PRODUCT SHALL BE DONE IN CONFORMANCE WITH THESE DRAWINGS AND ICC ESR-2802. THE PERFORMANCE OF MODIFIED PRODUCTS OR ALTERED INSTALLATION PROCEDURES ARE THE SOLE RESPONSIBILITY OF THE DESIGNER.
- SIMPSON STRONG-TIE® COMPANY, INC. RESERVES THE RIGHT TO CHANGE SPECIFICATIONS, DESIGNS, AND MODELS WITHOUT NOTICE OR LIABILITY FOR SUCH CHANGES.
- ALL HARDWARE CALLED OUT IS SIMPSON STRONG-TIE®.
- USE OF A SIMPSON STRONG-TIE PRODUCT DOES NOT IMPLY THAT SIMPSON STRONG-TIE ENDORSES ANY PROJECT, STRUCTURE OR USE. NO LICENSE IS GRANTED WITH RESPECT TO ANY SIMPSON STRONG-TIE TRADEMARK OR OTHER INTELLECTUAL PROPERTY RIGHTS. WRITTEN PERMISSION MUST BE OBTAINED PRIOR TO USING ANY SIMPSON STRONG-TIE TRADEMARKS OR PROPRIETARY DOCUMENTS AND MATERIALS.
- SIMPSON STRONG-TIE IS NOT AFFILIATED WITH, AND DOES NOT SPONSOR OR ENDORSE, THE DESIGNER, INSTALLER OR USERS OF THIS DRAWING, NOR DOES SIMPSON STRONG-TIE HAVE ANY JOINT VENTURE, PARTNERSHIP, AGENCY, EMPLOYMENT OR FIDUCIARY RELATIONSHIP WITH SUCH PERSONS.

MATERIAL:

- BARS/PLATES: ASTM 572 GR. 50, ASTM A529 GR. 50, OR ASTM A1011 HSLAS GR. 50
- W-SECTIONS (HOT ROLLED SECTIONS): ASTM A992
- LINK TO COLUMN FLANGE HIGH STRENGTH BOLTS: 7/8" DIA. ASTM A325, TYPE 1 (SNUG-TIGHT)
- BRP TO BEAM FLANGE AND SHEAR PLATE TO BEAM WEB HIGH STRENGTH BOLTS: ASTM A325, TYPE 1 (SNUG-TIGHT)
- LINK TO BEAM FLANGE HIGH STRENGTH BOLTS: ASTM F2280 TWIST OFF TYPE (A490 EQUIVALENT) (PRETENSIONED)
- BEAM TOP FLANGE WOOD NAILER BOLT: ASTM A307 GR. A
- CARRIAGE BOLTS: ASTM A307 GR. A
- ANCHOR RODS: ASTM F1554 GR 36 OR A36 (MFAB, MFSL, AND MF-ATR6EXT-LS); ASTM A449 (MFAB-HS, MFSL-HS, AND MF-ATR6EXT-HS)
- GROUT: ASTM C1107, MINIMUM 5,000 PSI COMPRESSIVE STRENGTH

INSTALLATION AND FIELD MODIFICATIONS:

THESE GENERAL INSTRUCTIONS FOR THE INSTALLER ARE PROVIDED TO ENSURE PROPER SELECTION AND INSTALLATION OF SIMPSON STRONG-TIE COMPANY INC. PRODUCTS AND MUST BE FOLLOWED CAREFULLY. THESE GENERAL INSTRUCTIONS ARE IN ADDITION TO THE SPECIFIC INSTALLATION INSTRUCTIONS AND NOTES PROVIDED FOR EACH PARTICULAR PRODUCT, ALL OF WHICH SHOULD BE CONSULTED PRIOR TO AND DURING INSTALLATION OF SIMPSON STRONG-TIE COMPANY INC. PRODUCTS.


- PROPER PRODUCT INSTALLATION REQUIRES CAREFUL ATTENTION TO ALL NOTES AND INSTRUCTIONS. IN ADDITIONAL TO THE NOTES, WARNINGS, AND INSTRUCTIONS PROVIDED IN THE CATALOG, INSTALLERS, DESIGNERS, ENGINEERS AND CONSUMERS SHOULD CONSULT THE SIMPSON STRONG-TIE COMPANY INC. WEBSITE AT WWW.STRONGTIE.COM TO OBTAIN ADDITIONAL INFORMATION FOR INSTALLATION, SPECIFICATIONS, CODE REPORTS, TECHNICAL FLIERS AND BULLETINS, FAQs, AND OTHER PERTINENT INFORMATION.
- PROVIDE TEMPORARY DIAGONAL BRACING OF STRONG FRAME® AS REQUIRED UNTIL FRAME IS TIED INTO THE FLOOR OR ROOF FRAMING ABOVE.
- USE PROPER SAFETY AND INSTALLATION EQUIPMENT DURING INSTALLATION OF STRONG FRAME®.
- ALL SPECIFIED FASTENERS MUST BE INSTALLED ACCORDING TO THE INSTRUCTIONS PROVIDED IN THE CATALOG, CODE REPORT, AND INSTALLATION DETAILS. INCORRECT FASTENER QUANTITY, SIZE, PLACEMENT, TYPE, MATERIAL, OR FINISH MAY CAUSE THE CONNECTION TO FAIL.
- FILL ALL FASTENER HOLES AS SPECIFIED IN THE INSTALLATION INSTRUCTIONS FOR THE SPECIFIED PRODUCT. INSTALL ALL FASTENERS BEFORE LOADING THE FRAME. SOME PRE-INSTALLED ITEMS MAY NOT USE ALL HOLES.
- NUTS SHALL BE INSTALLED SUCH THAT THE END OF THE THREADED ROD OR BOLT IS AT LEAST FLUSH WITH THE TOP OF THE NUT.
- REFER TO DETAIL 12/SMF3 FOR ALLOWABLE HOLE OPENINGS IN BEAM AND COLUMNS.
- REFER TO DETAIL 11/SMF3 FOR CONNECTION PROTECTED ZONE.
- WELDING SHALL BE IN ACCORDANCE WITH AWS D1.1 AND AWS D1.8 (AS APPLICABLE FOR SEISMIC). WELDS SHALL BE SPECIFIED BY THE DESIGNER. PROVIDE WELDING SPECIAL INSPECTION AS REQUIRED BY THE LOCAL BUILDING DEPARTMENT.

INSPECTIONS:

- WELDING OF FRAME MEMBERS AND APPLICABLE WELDING SPECIAL INSPECTIONS REQUIRED BY IBC SECTION 1707 ARE PERFORMED ON THE PREMISES OF A FABRICATOR REGISTERED AND APPROVED IN ACCORDANCE WITH THE REQUIREMENTS OF IBC SECTION 1704.2.5 FOR FABRICATOR APPROVAL.
- PRE-INSTALLATION VERIFICATION TESTING IS PERFORMED ON HIGH-STRENGTH FASTENER ASSEMBLIES.
- INSPECTION REQUIREMENTS OUTSIDE THE SHOP MANUFACTURING AND ASSEMBLY PROCESS SHALL BE IN ACCORDANCE WITH THE LOCAL CODE, BASED ON BUILDING OCCUPANCY, CONCRETE STRENGTH, REQUIREMENTS OF THE LOCAL BUILDING OFFICIAL, AND OTHER CONSIDERATIONS AND SHALL BE SPECIFIED BY THE DESIGNER.
- GROUTING UNDER COLUMN BASE PLATE MAY REQUIRE SPECIAL INSPECTION, CONTACT THE LOCAL BUILDING DEPARTMENT FOR COMPLIANCE REQUIREMENTS.
- CONTACT SIMPSON STRONG-TIE® AT 800-999-5099 TO REQUEST PRE-INSTALLATION TESTING, WELDING REPORTS, MILL CERTS, ETC. WHEN REQUIRED.

GENERAL NOTES

MODEL NO.	ROD SIZE & NUMBER	LENGTH (in)	l _e (in)	BEARING PLATE (in)
MFSL-14-6	4 - 3/4	14	8 1/2	3/8" x 7" x 7"
MFSL-14-HS6	4 - 3/4	14	8 1/2	
MFSL-18-6	4 - 3/4	18	12 1/2	
MFSL-18-HS6	4 - 3/4	18	12 1/2	
MFSL-24-6	4 - 3/4	24	18 1/2	
MFSL-24-HS6	4 - 3/4	24	18 1/2	
MFSL-30-6	4 - 3/4	30	24 1/2	
MFSL-30-HS6	4 - 3/4	30	24 1/2	
MFSL-36-6	4 - 3/4	36	30 1/2	
MFSL-36-HS6	4 - 3/4	36	30 1/2	

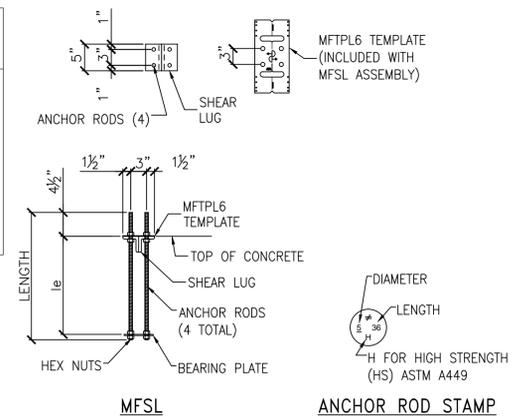

THE MFSL ANCHOR ASSEMBLIES HAVE BEEN ENGINEERED TO PROVIDE A COMPLETE ANCHORAGE SOLUTION MEETING THE 2012 AND 2015 INTERNATIONAL BUILDING CODE REQUIREMENTS FOR BOTH TENSION AND SHEAR.

ANCHOR RODS AND THE MFTPL TEMPLATE ARE INCLUDED PRE-ATTACHED WITH THE ASSEMBLY.

INSPECTION IS EASY; THE HEAD IS STAMPED WITH A "NO EQUAL" SYMBOL FOR IDENTIFICATION, BOLT LENGTH, BOLT DIAMETER, AND OPTIONAL "HS" FOR HIGH STRENGTH IF SPECIFIED.

MFSL ANCHORAGE ASSEMBLIES

NO.	DATE	REVISIONS
1	08/17/2018	ADDENDUM 2




SIMPSON STRONG-TIE CO. INC.
5956 W. Las Positas Blvd.
Pleasanton, CA 94588
Tel: (800) 999-5099
Fax: (925) 847-1597
Web site: www.strongtie.com
THERE IS NO EQUAL

THE MOMENT FRAME(S) IS DESIGNED FOLLOWING INFORMATION PROVIDED BY: Myamoto Information, Inc. DATE OF PLANS (D.O.P.): 8/17/2018 PROVIDED TO SIMPSON STRONG-TIE BY: Jonathan Buckley

STRONG-FRAME®
FRAME ELEVATION DRAWING
ENGINEERED DESIGN
3429 CANYON CREST DRIVE - MF-2


NAME: D.H.
DATE: 08/17/2018
SCALE: N.T.S.
SHEET:
MF-2
JOB NO. ES-183167

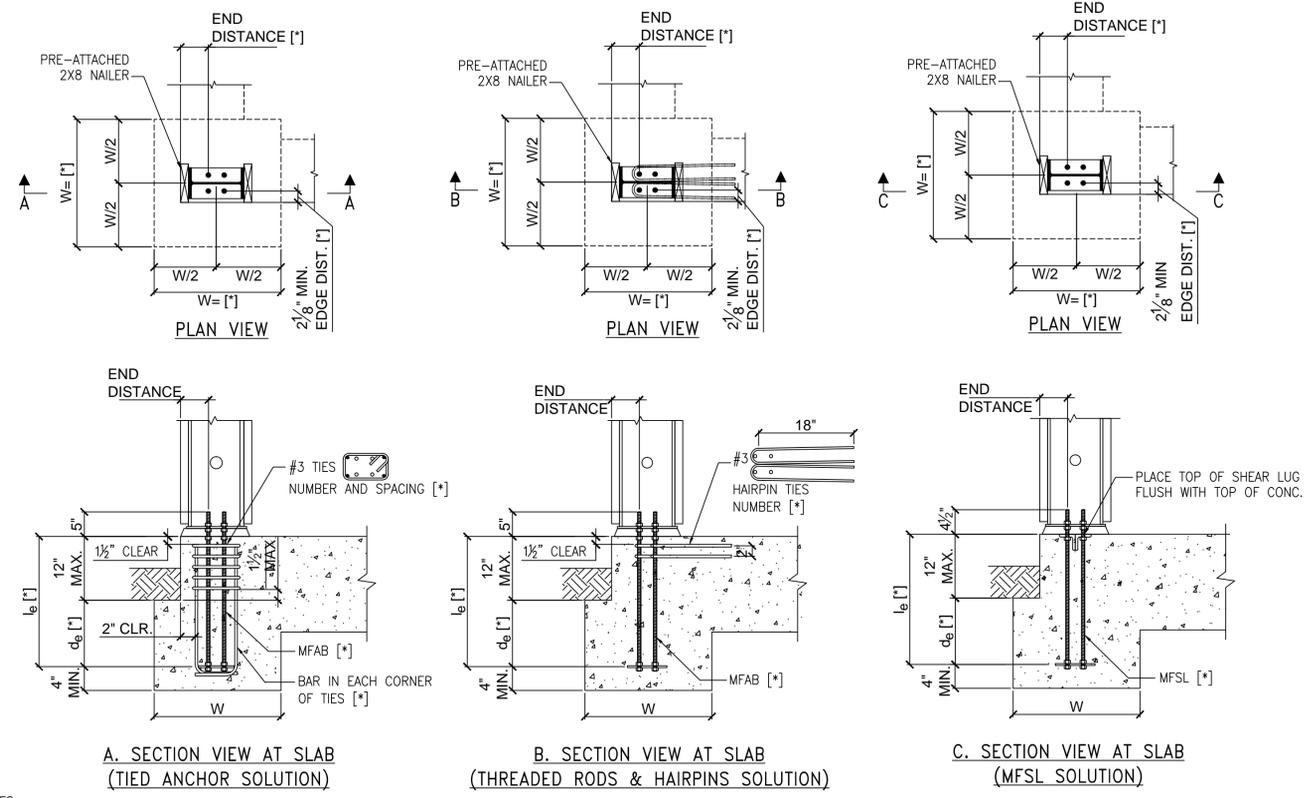

NOTES:
 1. [*] DENOTES INFORMATION TO BE PROVIDED BY DESIGNER
 2. FOOTING/GRADE BEAM SIZE AND REINFORCING SHALL BE SPECIFIED BY THE DESIGNER AS REQUIRED TO RESIST IMPOSED LOADS, SUCH AS FOUNDATION SHEAR AND BENDING, SOIL BEARING PRESSURE, SHEAR TRANSFER, AND FRAME STABILITY/OVERTURNING

SLAB-ON-GRADE FOUNDATION ANCHORAGE DETAILS


1

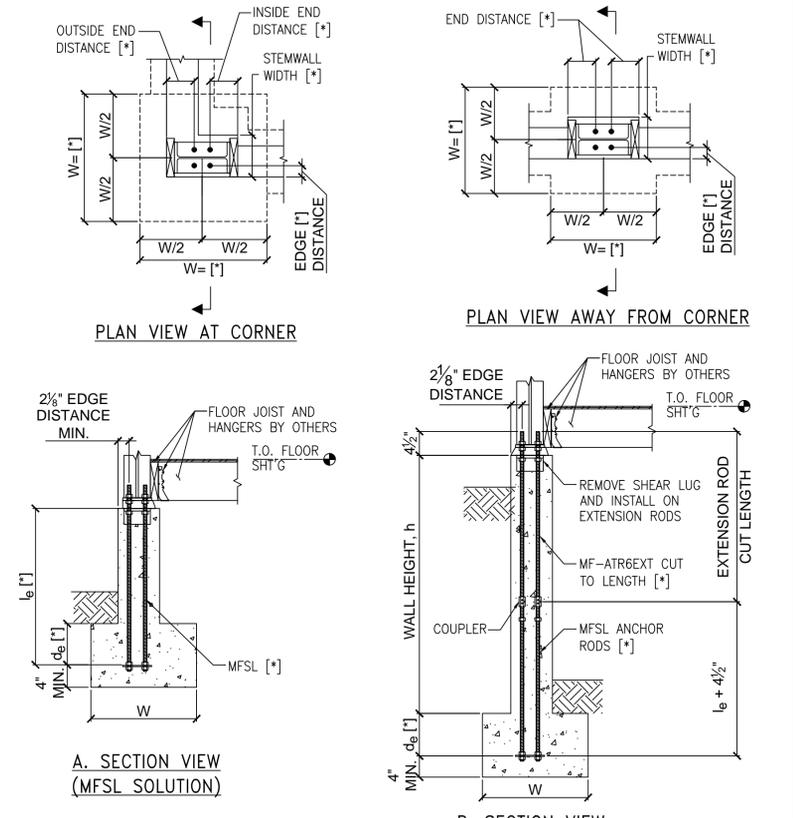

NOTES:
 SEE NOTES ON 1/SMF2

STEMWALL FOUNDATION ANCHORAGE DETAILS


3

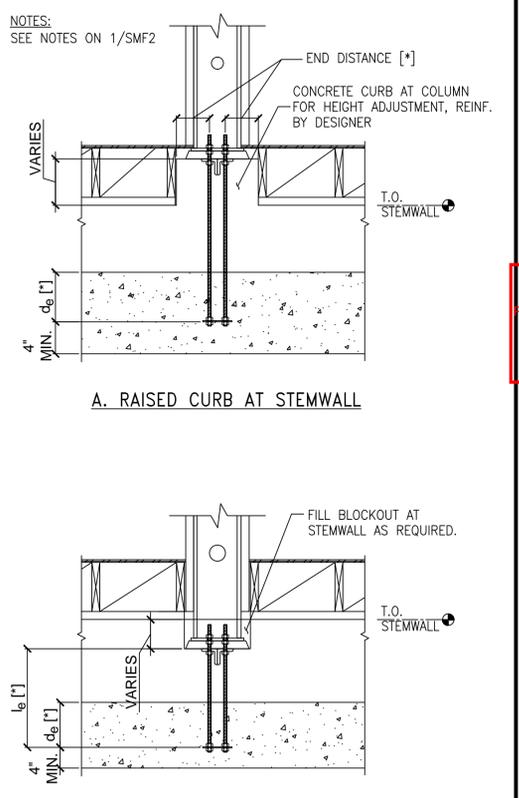

NOTES:
 SEE NOTES ON 1/SMF2

COL. HEIGHT ADJ. AT STEMWALL


6

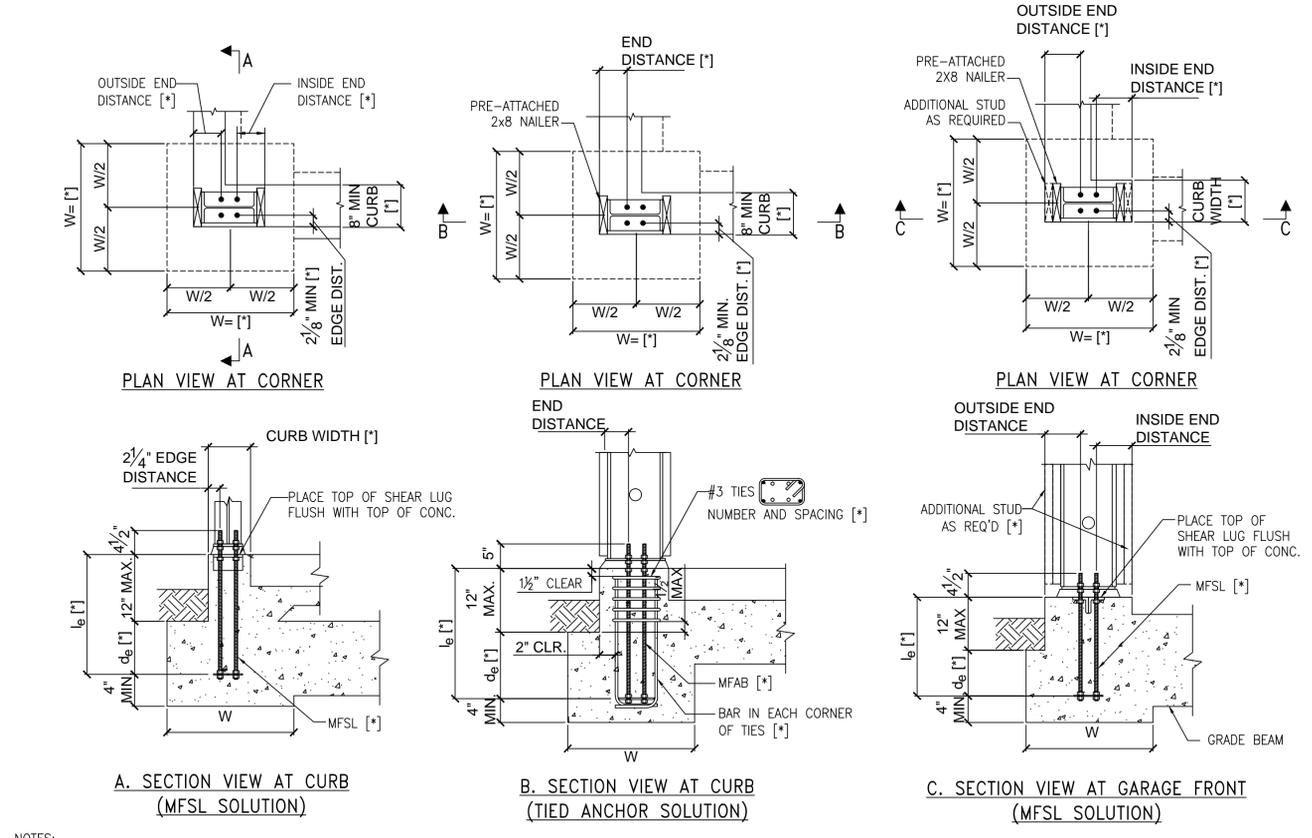

NOTES:
 SEE NOTES ON 1/SMF2

CONCRETE CURB FOUNDATION ANCHORAGE DETAILS


2

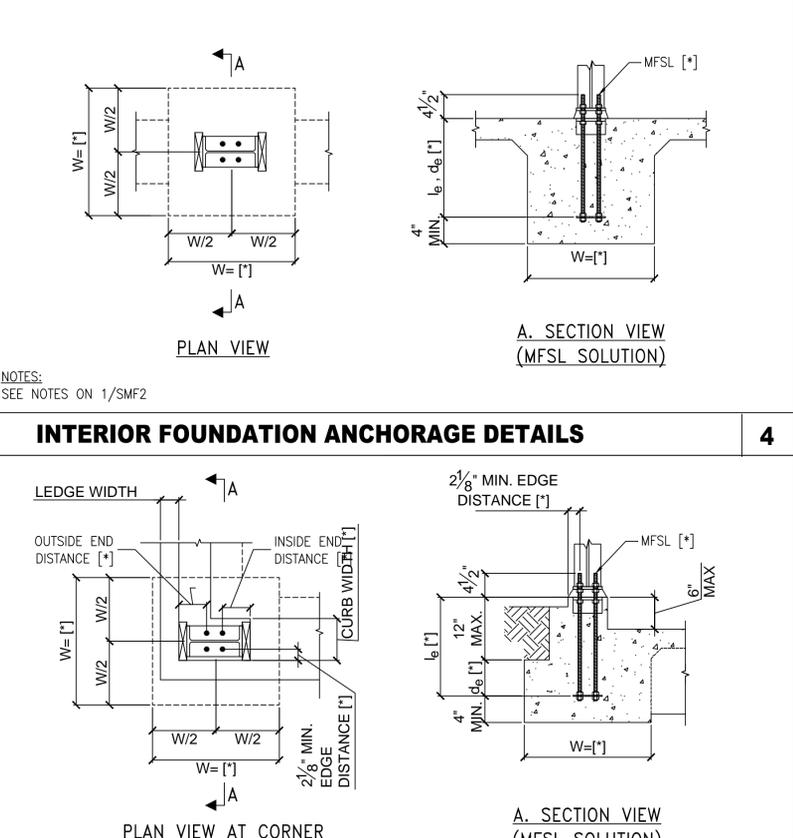

NOTES:
 SEE NOTES ON 1/SMF2

BRICK LEDGE FOUNDATION ANCHORAGE DETAILS

5

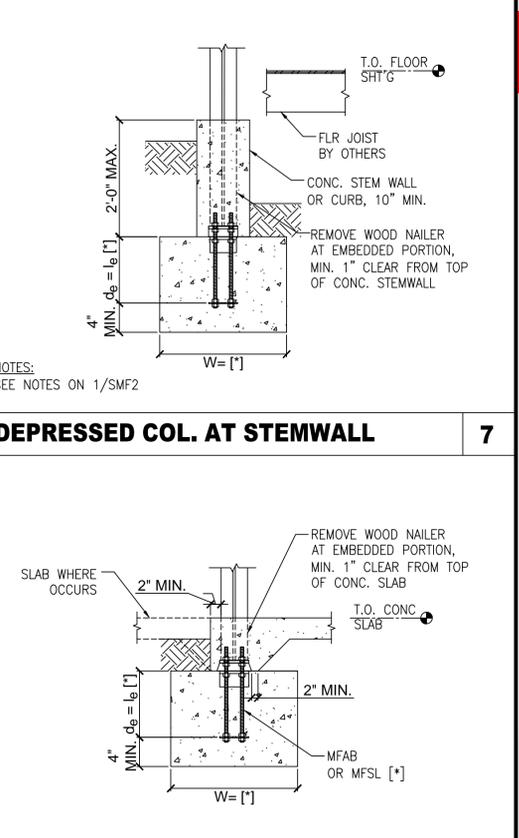

NOTES:
 SEE NOTES ON 1/SMF2

DEPRESSED COL. AT S.O.G.

8

NO.	DATE	REVISIONS

APPROVED
 UC Riverside
 Planning, Design and Construction
 Campus Building Official
 Signature: Robert K. Williams
 Building & Safety Division
 Campus Building Permit


SIMPSON STRONG-TIE, CO. INC.
 5956 W. Los Positos Blvd.
 Pleasanton, CA 94588
 Tel: (800) 999-5099
 Fax: (925) 947-1977
 Web site: www.strongtie.com
Strong-Tie
 THERE IS NO EQUAL

INSPECTIONS REQUIRED
 UC RIVERSIDE
 Office of Planning, Design & Construction
 Signed CBO: Robert K. Williams
 Building, Safety and Compliance Division
 CAMPUS BUILDING PERMIT
 Inspected by: [Signature]


STRONG-FRAME
 SMF FOUNDATION DETAILS
 ENGINEERED DESIGN
 3429 CANYON CREST DRIVE

OFFICE OF THE STATE FIRE MARSHAL
 APPROVED FIRE AND PANIC ONLY
 07/02/2019
 Approval of this plan does not authorize or
 remove any condition or deviation from applicable
 regulations. Final approval is subject to field
 inspection. One set of approved plans shall be
 available on the project site at all times.
 Reviewed by: [Signature]
 Fire and Life Safety Division


NAME: D.H.
 DATE: 08/17/2018
 SCALE: N.T.S.
 SHEET:
SMF2
 JOB NO.
 ES-183167

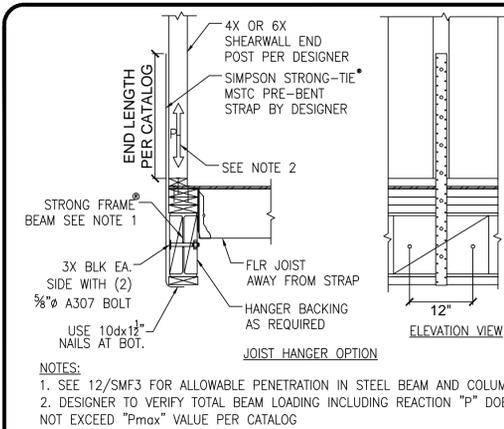


HOLDOWN POST TO SMF BEAM 1

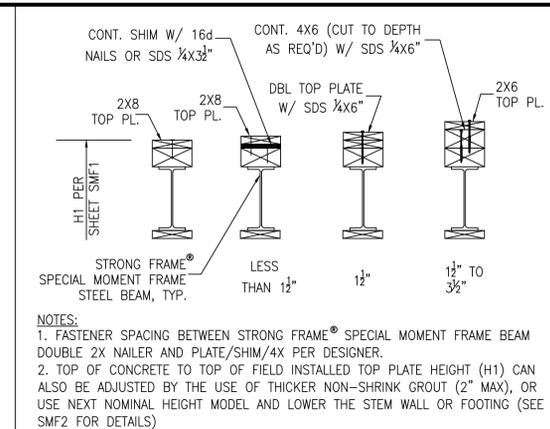


TOP OF FRAME ADJUSTMENT 5

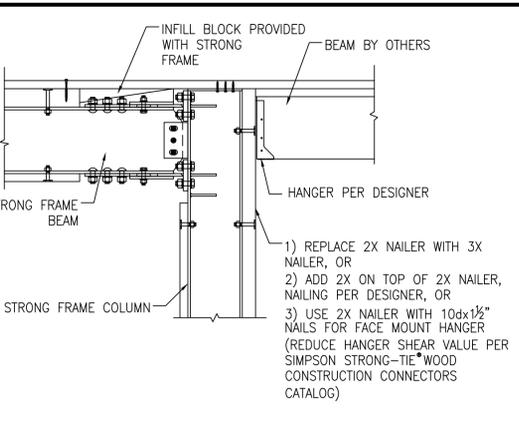


WOOD BM TO SMF COL. CONN. 8

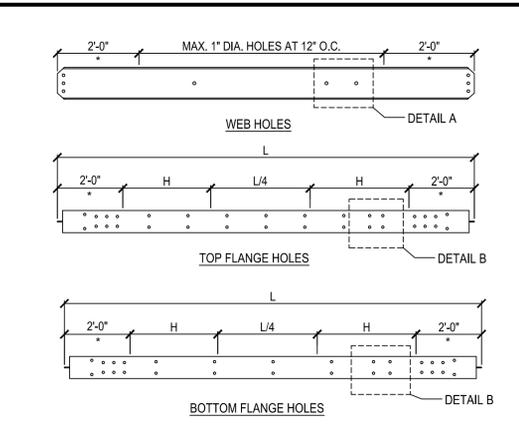


ALLOWABLE BEAM AND COLUMN PENETRATIONS 12

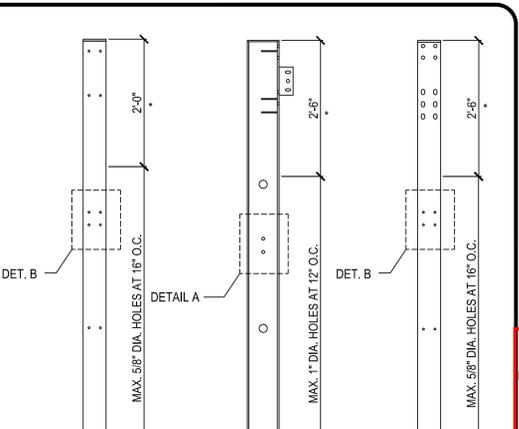


WOOD INFILLS 13

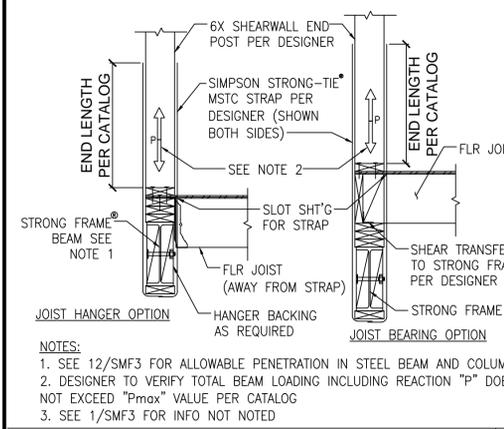


6x HOLDOWN POST TO SMF BEAM 2

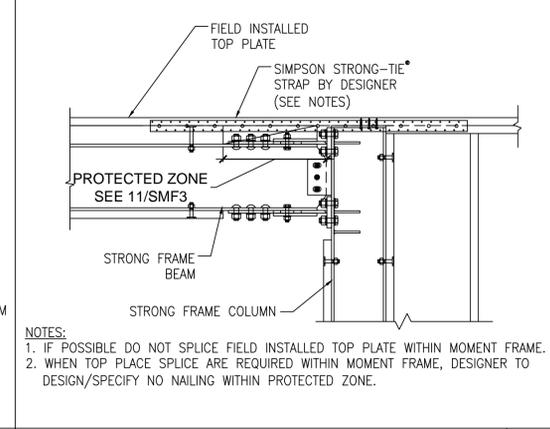


TOP PLATE SPLICE DETAIL 6

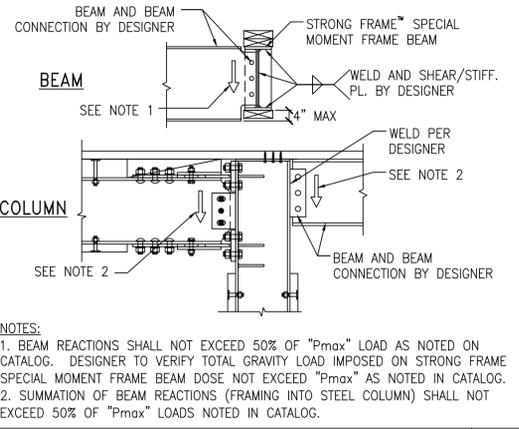


STEEL BEAM TO SMF BEAM/COL. 9

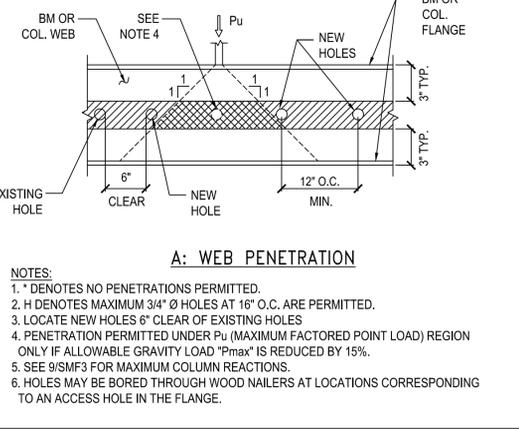


PROTECTED ZONE 11

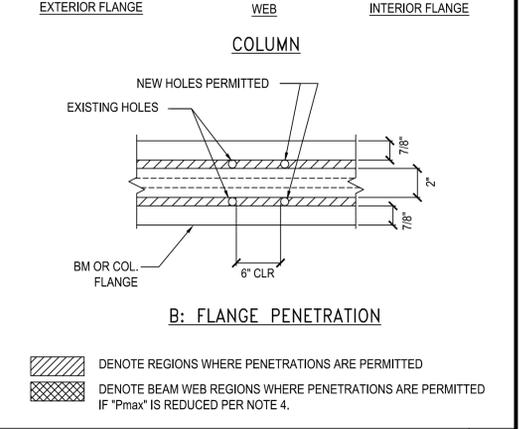


BEAM-TO-COLUMN CONNECTION 15

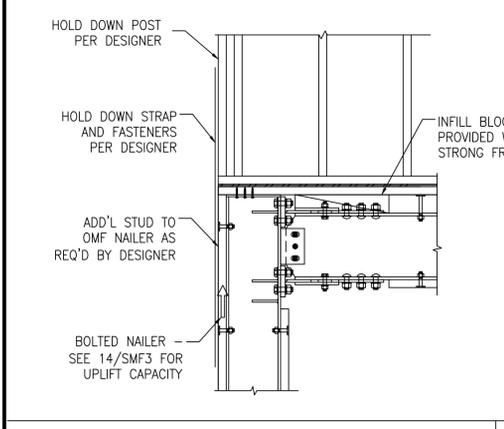


HOLDOWN POST TO SMF COL. 3

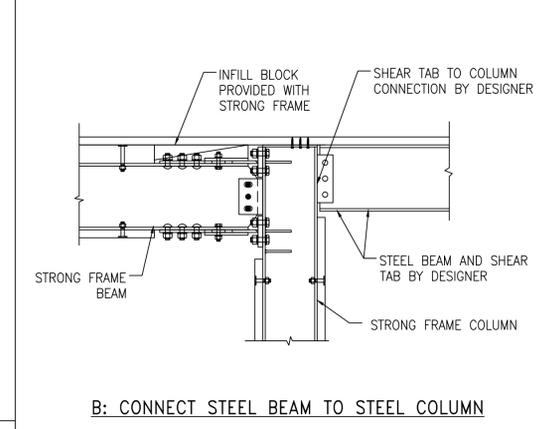


COLLECTOR DETAILS 7

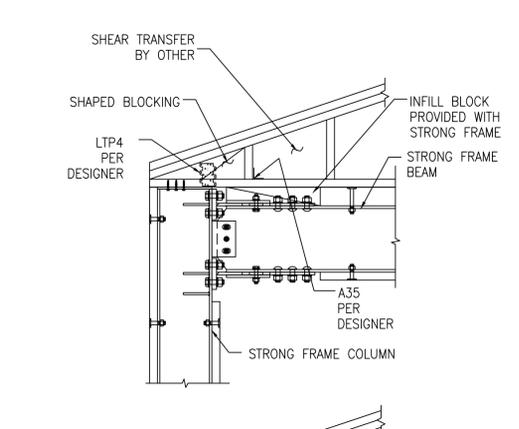


RAKE WALL DETAILS 10

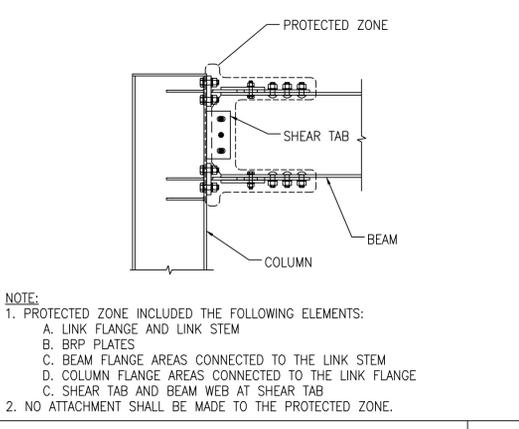


NAILER BOLT ALLOWABLE LOADS 14

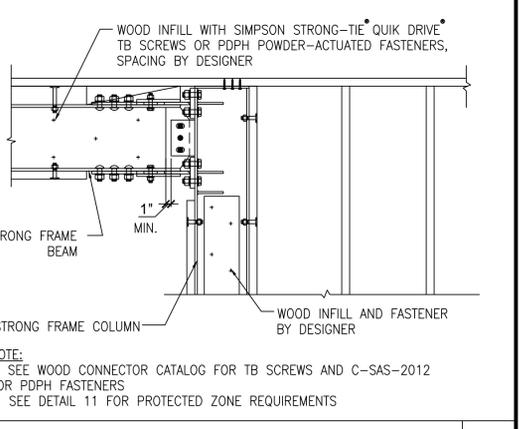


BEAM-TO-COLUMN CONNECTION 15

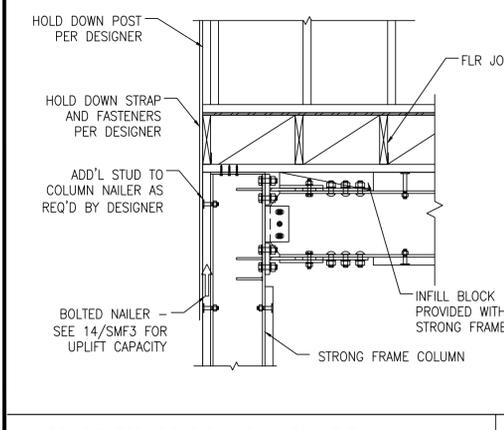


HOLDOWN POST TO SMF COL. 4

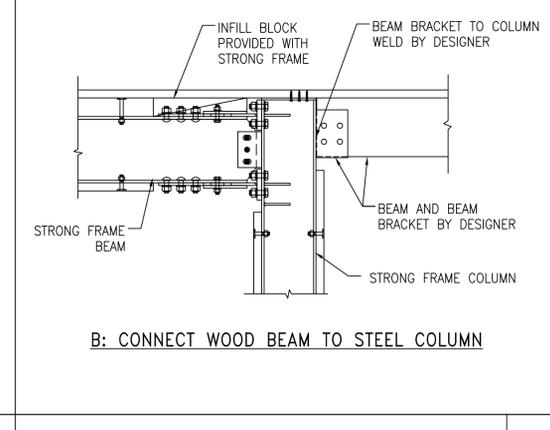


COLLECTOR DETAILS 7

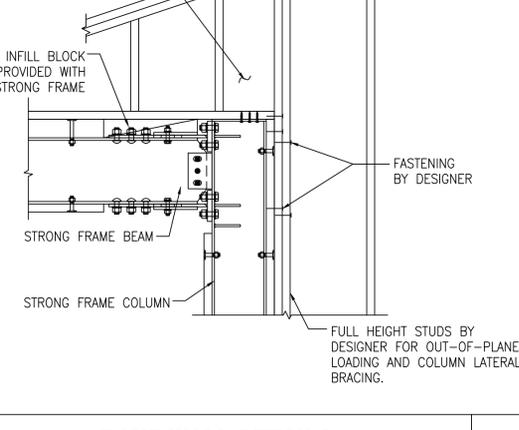

RAKE WALL DETAILS 10

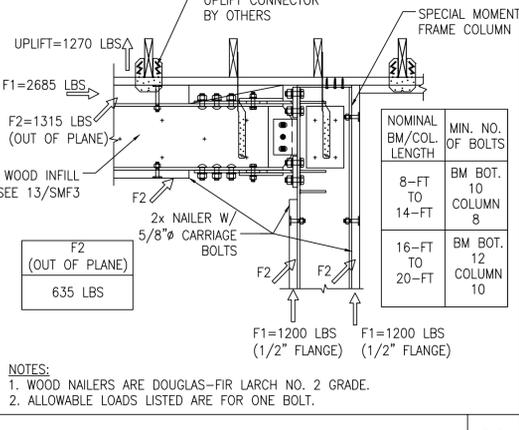

NAILER BOLT ALLOWABLE LOADS 14

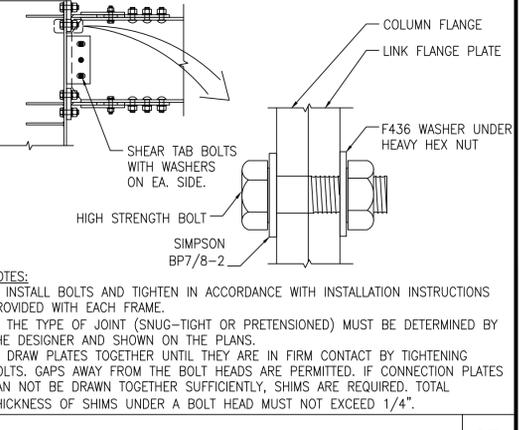

BEAM-TO-COLUMN CONNECTION 15

NO.	DATE	REVISIONS

APPROVED
 UC Riverside
 Planning, Design and Construction
 Signature: Robert K. Williams
 Building & Safety Division
 Campus Building Permit

SIMPSON STRONG-TIE, CO. INC.
 5956 W. Los Positos Blvd.
 Pleasanton, CA 94588
 Tel: (800) 999-5099
 Fax: (925) 947-15977
 Web site: www.strongtie.com


SIMPSON StrongTie
 THERE IS NO EQUAL

INSPECTIONS REQUIRED
 UC RIVERSIDE
 Office of Planning, Design & Construction
 Signed CEO: Robert K. Williams
 Building, Safety and Compliance Division
 CAMPUS BUILDING PERMIT
 INSPECTIONS SHALL BE REQUIRED UNDER THE EGRESS PERMIT

STRONG-FRAME
 SMF INSTALLATION DETAILS
 ENGINEERED DESIGN
 3429 CANYON CREST DRIVE


OFFICE OF THE STATE FIRE MARSHAL
 APPROVED FIRE AND PANIC ONLY
07/02/2019
 Approval of this plan does not authorize or approve any omission or deviation from applicable regulations. Final approval is subject to inspection. One set of approved plans shall be available on the project site at all times.
 Reviewed by: *Heath Johnson*
 Fire and Life Safety Division

NAME: D.H.
 DATE: 08/17/2018
 SCALE: N.T.S.
 SHEET:
SMF3
 JOB NO. ES-183167

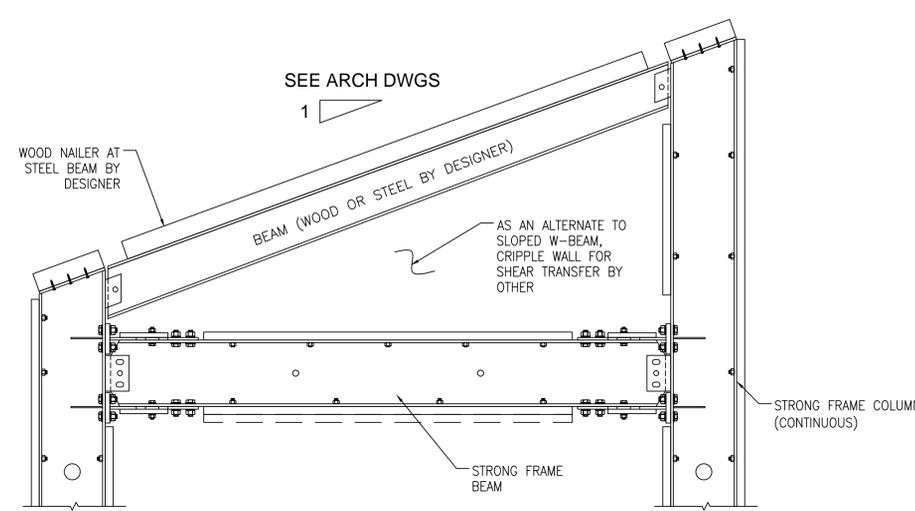


SST SMF WITH SLOPED ROOF BEAM

1

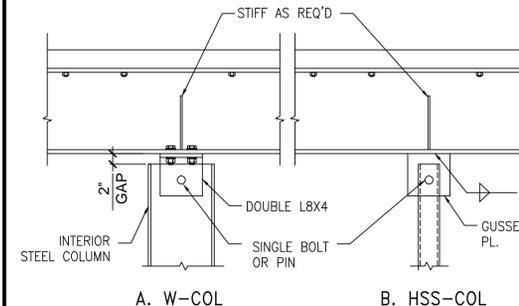


INTERIOR PINNED BEARING COL.

2

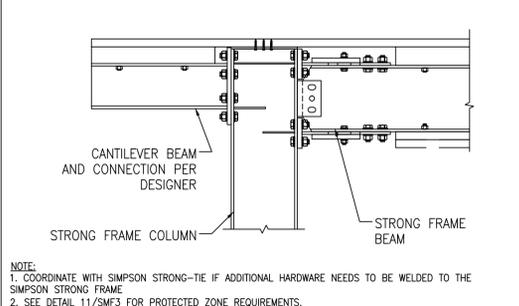


CANTILEVER BEAM TO COLUMN

5

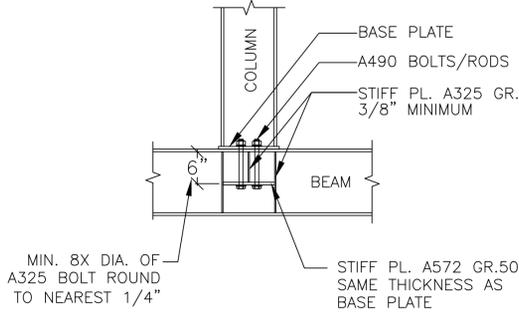


SMF COLUMN ON STEEL BEAM

9

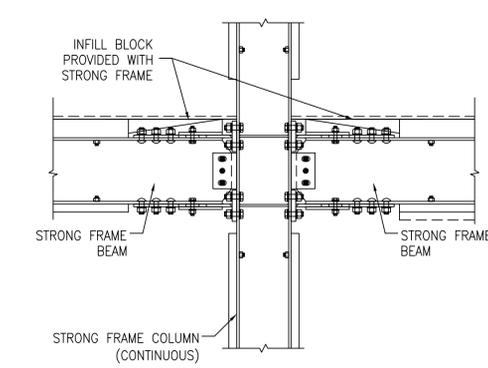


MULTI-STORY COLUMNS (2 BEAMS)

12

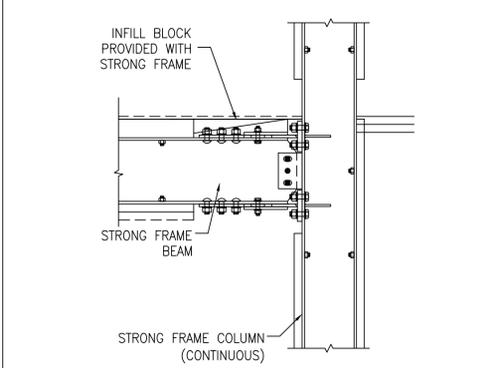


MULTI-STORY COLUMNS (1-BEAM)

15

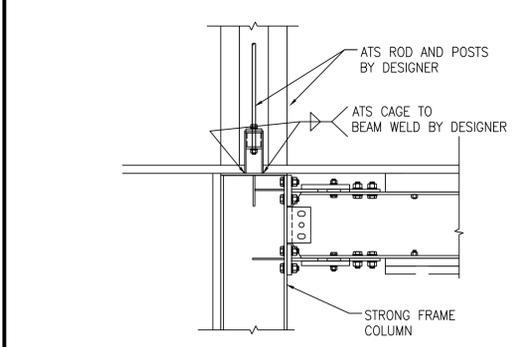


ATS ROD//HD ON STEEL COLUMN

3

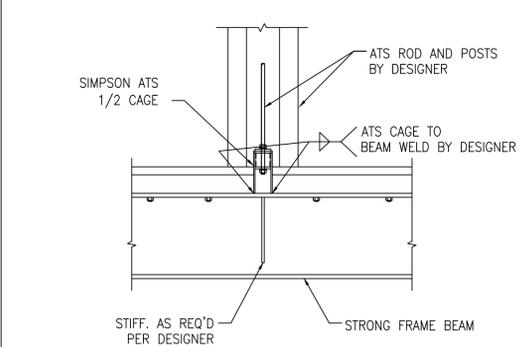


ATS ROD ON STEEL BEAM

6

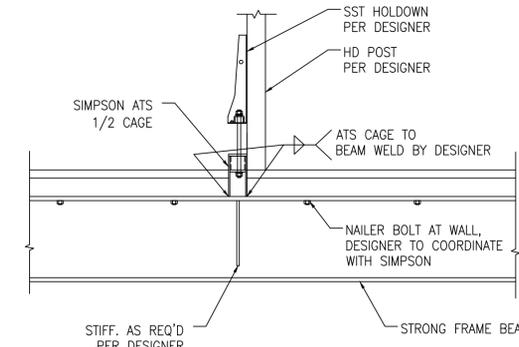


SHEAR WALL HD ON STEEL BEAM

10

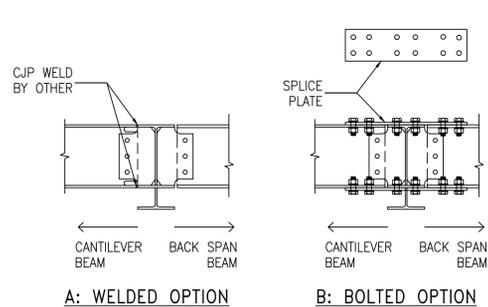


CANTILEVER STEEL BEAM CON.

13

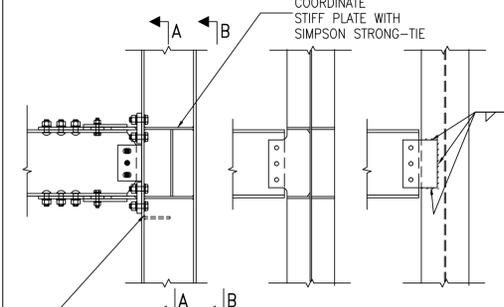


BEAM CONNECTION TO COLUMN

17

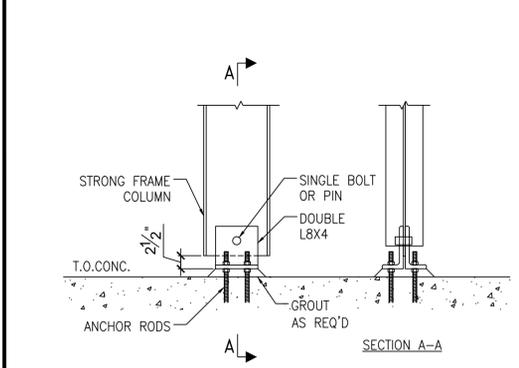


SINGLE BOLT PINNED BASE DETAIL

4

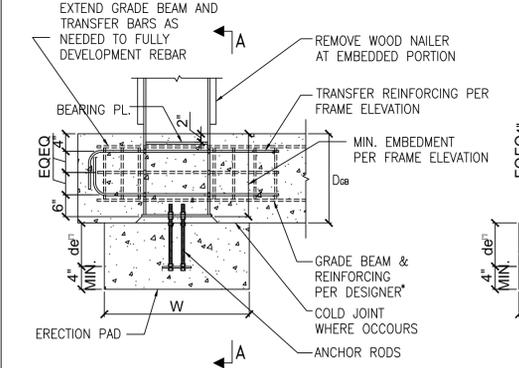


FIXED BASE CONNECTION

11

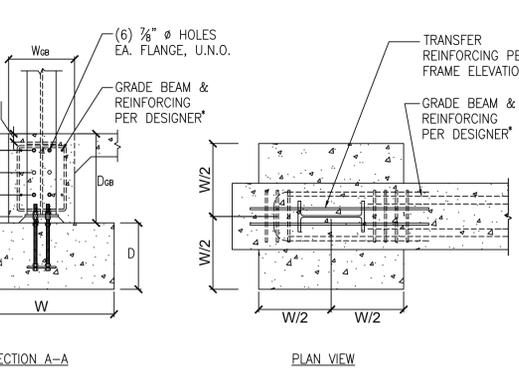

COL. BRACING AT FLOOR LEVEL

14

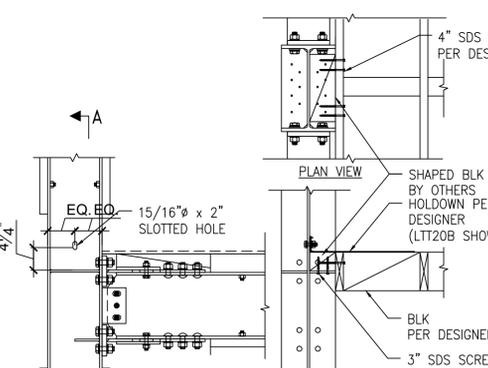

BOLTED COLUMN SPLICE

18

NO.	DATE	REVISIONS

APPROVED
UC Riverside
 Planning, Design and Construction
 Campus Building Official
 Signature: *Robert K. Williams*
 Building & Safety Division
 Campus Building Permit

SIMPSON STRONG-TIE, CO. INC.
 5956 W. Los Positos Blvd.
 Pleasanton, CA 94588
 Tel: (800) 999-5099
 Fax: (925) 847-1597
 Web site: www.strongtie.com

SIMPSON Strong-Tie

✓ THERE IS NO EQUAL

INSPECTIONS REQUIRED
 UC RIVERSIDE
 Office of Planning, Design & Construction
 Signed CSO: *Robert K. Williams*
 Building, Safety and Compliance Division
 CAMPUS BUILDING PERMIT
 ALL REVISIONS SHALL BE PROBABLY UNDER THE DESIGNER'S CONTROL

STRONG-FRAME
 SMF INSTALLATION DETAILS
 ENGINEERED DESIGN
 3429 CANYON CREST DRIVE

OFFICE OF THE STATE FIRE MARSHAL
 APPROVED FIRE AND PANIC ONLY
07/02/2019
 Approval of this plan does not authorize or approve any omission or deviation from applicable regulations. Final approval is subject to field inspection. One set of approved plans shall be available on the project site at all times.
 Reviewed by: *Scott Johnson*
 Safety Division

NAME: D.H.
 DATE: 08/17/2018
 SCALE: N.T.S.
 SHEET:
SMF4
 JOB NO. ES-183167

GENERAL ELECTRICAL NOTES

- 1. ALL MATERIALS AND WORKMANSHIP SHALL CONFORM TO THE LATEST CALIFORNIA CODE OF REGULATIONS (CCR), NATIONAL ELECTRICAL CODE EDITION AND ALL APPLICABLE LOCAL CODES AND REGULATIONS.
2. WHERE WIRE SIZES ARE INDICATED ON PLANS, FOR INDIVIDUAL CIRCUITS, THE WIRE SIZE INDICATED SHALL APPLY TO THE COMPLETE CIRCUIT, UNLESS OTHERWISE NOTED.
3. CONTRACTOR SHALL COORDINATE THE LOCATION OF ALL WALL AND CEILING OUTLET BOXES FOR DETECTORS, HORNSTROBES, FIRE ALARM PULL STATIONS AND OTHER DEVICES WITH EXISTING CABINETS, FURNITURE, EQUIPMENT ETC., TO AVOID CONFLICT.
4. FURNISH PULL WIRES IN EACH RACEWAY RUN OVER 10' IN LENGTH, IN WHICH PERMANENT WIRING IS NOT INSTALLED.
5. PROVIDE PULL BOXES WHEREVER NECESSARY TO FACILITATE PULLING OF CONDUCTORS. COORDINATE LOCATIONS OF BOXES WITH OTHER TRADES TO AVOID CONFLICT. PULL BOXES SHALL BE ACCESSIBLE. THE SIZE OF PULL BOX SHALL COMPLY WITH N.E.C. REQUIREMENTS.
6. ALL EXTERIOR ELECTRICAL DEVICES AND EQUIPMENT INCLUDING THOSE THAT ARE EXPOSED TO OUTSIDE ENVIRONMENT (UP TO 16) SHALL BE WEATHERPROOF TYPE, NEMA 3R.
7. ALL WIRING IN FIRE RATED WALL IS TO BE INSTALLED IN A METALLIC CONDUIT SYSTEM.
8. ALL ELECTRIC MATERIAL SHALL BE LISTED BY "UL" FOR THE TYPE OF APPLICATION AND "UL" LABEL SHALL APPEAR ON ALL ELECTRICAL EQUIPMENT.
9. (SECTION 16121-2-01-A11A2) CONDUCTORS SHALL HAVE UNDERWRITERS' LABORATORIES, INC (UL) LISTED, 600 VOLT INSULATION OF TYPE SPECIFIED BELOW OR ELSEWHERE IN THE SPECIFICATIONS. CONDUCTORS SHALL BE COPPER.
10. WIRING METHOD SHALL BE WIREMOLD AND EMT ABOVE GROUND (AS SHOWN ON PLAN DRAWINGS) AND SCHEDULE-40 PVC FOR UNDERGROUND INSTALLATION UNLESS NOTED OTHERWISE.
11. NO SCREW TIGHT FITTINGS SHALL BE ALLOWED. ALL CONDUIT FITTINGS SHALL BE COMPRESSION TYPE.

ABBREVIATIONS

Table with 3 columns: Abbreviation, Description, and Unit/Value. Includes terms like AMPERE, ABOVE FINISHED FLOOR, AMPERE INTERRUPTING CAPACITY, etc.

APPLICABLE CODES

- 1. 2016 BUILDING STANDARDS ADMINISTRATIVE CODE, PART 1, TITLE 24 C.C.R.
2. 2016 CALIFORNIA BUILDING CODE (CBC), PART 2, TITLE 24 C.C.R. (UBC WITH AMENDMENTS)
3. 2016 CALIFORNIA ELECTRICAL CODE (CEC), PART 3, TITLE 24 C.C.R. (NEC WITH AMENDMENTS)
4. 2016 CALIFORNIA MECHANICAL CODE (CMC), PART 4, TITLE 24 C.C.R. (UMC WITH AMENDMENTS)
5. 2016 CALIFORNIA PLUMBING CODE (CPC), PART 5, TITLE 24 C.C.R. (UPC WITH AMENDMENTS)
6. 2016 CALIFORNIA FIRE CODE, PART 9, TITLE 24 C.C.R. (IFC WITH AMENDMENTS)
7. 2016 CALIFORNIA REFERENCED STANDARDS, PART 12, TITLE 24 C.C.R.
8. 2016 TITLE 19 C.C.R., PUBLIC SAFETY, STATE FIRE MARSHAL REGULATIONS.
9. NFPA 72 NATIONAL FIRE ALARM CODE (CALIFORNIA AMENDED) 2016 EDITION.

LEGEND AND SYMBOLS

Table with 2 columns: SYMBOL and DESCRIPTION. Includes symbols for ABOVE CEILING CONCEALED JUNCTION BOX, RECESSED WALL MOUNTED JUNCTION BOX, BRANCH PANELBOARD, MAIN SWITCHBOARD, CONDUIT TURNED DOWN, etc.

NOTE TO CONTRACTOR

DO NOT SCALE DRAWINGS
CONTRACTOR SHALL VERIFY PLANS AND EXISTING DIMENSIONS AND CONDITIONS ON THE JOB SITE AND SHALL IMMEDIATELY NOTIFY THE ARCHITECT IN WRITING OF ANY DISCREPANCIES BEFORE PROCEEDING WITH THE WORK OR BE RESPONSIBLE FOR THE SAME.

BUILDING ANALYSIS

Table with 2 columns: Field and Value. Includes BUILDING ADDRESS: 3429 CANYON CREST DRIVE, RIVERSIDE, CA 92507; OCCUPANCY GROUP: GROUP R (APARTMENT); TYPE OF CONSTRUCTION: WOOD; NUMBER OF STORIES: TWO; EXISTING BUILDING S.F.: NET 142,000 S.F.

SEQUENCE OF OPERATIONS

Sequence of Operations table with columns for System Inputs (1-12) and System Outputs (Control Unit Annunciation, Notification, Required Fire Safety Control). Includes notes like 'Activate control panel trouble bypass on LED' and 'Annunciate at control panel alarm indicator'.

FIRE ALARM SYSTEM EQUIPMENT LIST

Table with 6 columns: SYMBOL, MFG., PART NO., DESCRIPTION, REMARKS, CSFM LISTING. Lists equipment like FACP, FVAM, FATC, RPS, and various sensors.

FIRE ALARM SYSTEM WORK SCOPE

- PROVIDE A COMPLETE ADDRESSABLE FIRE ALARM SYSTEM FOR THE ENTIRE UNIVERSITY APARTMENT COMPLEX. SYSTEM SHALL PROVIDE FULL COVERAGE IN COMPLIANCE WITH CURRENT BUILDING AND FIRE CODES, ADA REQUIREMENTS AND UCR STANDARDS AND REQUIREMENTS. NEW SYSTEM SHALL BE APPROVED BY UCR CAMPUS FIRE MARSHALL. PROVIDE SHOP DRAWINGS TO ENGINEER OF RECORD FOR REVIEW. INSTALLATION WORK SCOPE INCLUDES FOLLOWING (BUT NOT LIMITED TO):
1. PROVIDE AND INSTALL A NEW ADDRESSABLE FIRE ALARM CONTROL PANEL FIRE AT THE EXISTING RECREATION BUILDING (BUILDING 20)
2. PROVIDE AND INSTALL NEW FIRE ALARM DEVICES AT (3) APARTMENT BUILDINGS AND THE RECREATION BUILDING. PROVIDE AND INSTALL ALL NECESSARY WIRING INSIDE EACH BUILDING. PROVIDE POWER SUPPLY UNITS AT EACH BUILDING FOR THE NOTIFICATION DEVICES. ENSURE FIRE ALARM PANEL HAS ADEQUATE AMPLIFICATION POWER FOR SPEAKERS AS SHOWN ON FLOOR PLANS. CONNECT 120VAC FROM EXISTING PANELBOARDS TO THE POWER SUPPLY UNITS AT EACH BUILDING.
3. INSTALL AN UNDERGROUND CONDUIT SYSTEM THROUGHOUT THE APARTMENT COMPLEX WITH PULL BOXES FOR THE NEW FIRE ALARM SYSTEM WIRING.
4. INSTALL ALL HOMERUN WIRING FROM EACH BUILDING TO THE NEW FIRE ALARM CONTROL PANEL. PROGRAM ALL ADDRESSABLE DEVICES AT THE NEW FIRE ALARM CONTROL PANEL IN ACCORDANCE WITH THE BUILDING'S AREA DESIGNATIONS WITH FLOOR AND UNIT IDENTIFICATIONS.
5. PERFORM ALL NECESSARY TESTS AND ENSURE ALL EQUIPMENT IS WORKING PROPERLY.
6. PERFORM ALL REQUIRED FIRE INSPECTIONS BY THE CAMPUS FIRE MARSHALL AND OBTAIN FINAL APPROVAL.
7. PROVIDE TRAINING IF NEEDED TO UCR PERSONNEL TO OPERATE AND MAINTAIN THE NEW FIRE ALARM SYSTEM.

FIRE ALARM NOTES

- 1. THE FIRE ALARM SYSTEM AND EQUIPMENT INDICATED ON THESE DRAWINGS SHALL BE INSPECTED AND APPROVED BY UCR CAMPUS FIRE MARSHALL AND SHALL BE INSTALLED AS DESCRIBED ON THESE DRAWINGS AND AS NOTED IN THE SPECIFICATIONS PER CFC 901.5. ANY CHANGES TO THESE PLANS, SUCH AS DELETION, RELOCATION, ADDING OF DEVICES OR EQUIPMENT SUBSTITUTIONS SHALL BE RESUBMITTED TO THE CAMPUS FIRE MARSHALL FOR APPROVAL AT NO ADDITIONAL COST TO THE OWNER.
2. ALL WIRING AND INITIATING DEVICES SHALL BE SUPERVISED TO THE PRINCIPAL POINT OF ANNUNCIATION (FIRE ALARM CONTROL PANEL TO SUPERVISE ALL CIRCUITS AND INITIATING DEVICES).
3. WIRING SHALL NOT BE LOOPED THROUGH DEVICES. WIRES MUST BE CUT FOR IN AND FOR OUT.
4. EXPOSED CONDUIT BELOW CEILING SHALL NOT BE ACCEPTED INSIDE APARTMENT UNITS. FIRST FLOOR INTERIOR WIRING SHALL BE IN WALL MOUNT METAL WIREMOLD RACEWAY.
5. ALL TERMINATIONS IN JUNCTION BOXES, PULL BOXES AND TERMINAL CABINETS SHALL BE ON BOX MOUNTED TERMINAL BLOCKS. DO NOT USE WIRE NUTS FOR SPLICING. DO NOT SPLICE WIRES IN ANY BOXES.
6. ALL RACEWAY SIZES INDICATED IN DRAWINGS ARE MINIMUM. CONTRACTOR TO ADJUST SIZE FOR FIELD CONDITIONS BUT CONDUITS SHALL NOT BE SMALLER THAN 3/4 INCH.
7. ALL FIRE ALARM WIRING MUST TEST FREE OF OPENS, SHORTS AND GROUNDS.
8. FIRE ALARM DRAWINGS ARE SCHEMATIC IN NATURE ONLY. CONTRACTOR TO ROUTE WIRING AND RACEWAY AS FIELD CONDITIONS INDICATE.
9. RACEWAY AND JUNCTIONBOX BOXES ARE NOT TO BE USED FOR UNRELATED WIRING.
10. THE SYSTEM SHALL CONFORM TO TITLES 19 AND 24 AS APPLICABLE TO THIS PROJECT.
11. UPON COMPLETION OF SYSTEM INSTALLATION, THE SYSTEM SHALL BE TESTED IN THE PRESENCE OF, AND IN A MANNER ACCEPTABLE, TO THE OWNER AND UCR CAMPUS MARSHALL.
12. CONDUCTOR LENGTHS AND DEVICE QUANTITIES ARE SHOWN SOLELY FOR CALCULATION PURPOSES ONLY, AND SHALL NOT BE USED FOR BID TAKE-OFF.
13. THE FIRE ALARM SYSTEM SHALL CONFORM TO ARTICLE 780 OF CALIFORNIA ELECTRICAL CODE. INSTALLATION OF THE FIRE ALARM SYSTEM SHALL NOT BE STARTED UNTIL DETAILED PLANS AND CUTSHEETS, INCLUDING CALIFORNIA STATE FIRE MARSHAL LISTING NUMBERS FOR EACH COMPONENT OF THE SYSTEM HAVE BEEN APPROVED BY UCR CAMPUS FIRE MARSHALL. UPON COMPLETION OF THE INSTALLATION OF THE FIRE ALARM SYSTEM A SATISFACTORY TEST OF THE ENTIRE SYSTEM SHALL BE MADE IN THE PRESENCE OF THE CAMPUS FIRE MARSHALL.
14. PENETRATIONS OF PIPES, CONDUITS, ETC., IN FIRE RATED WALLS REQUIRING PROTECTED OPENINGS SHALL BE FIRE STOPPED. FIRE STOP MATERIAL SHALL BE A TEST ASSEMBLY ACCEPTABLE TO THE CAMPUS FIRE MARSHALL.
15. ALL FIRE ALARM AND COMMUNICATIONS WIRES AND CABLES SHALL BE ONE CONTINUOUS LENGTH FROM A BUILDING TERMINAL CABINET TO ANOTHER BUILDING TERMINAL CABINET OR JUNCTION BOX. ABSOLUTELY NO SUBGRADE SPLICES WILL BE PERMITTED. PROVIDE TERMINAL BLOCKS WITH MOUNTING IN TERMINAL CABINETS ONLY AS REQUIRED.
16. THE FIRE ALARM DEVICE SUPPLIER SHALL FURNISH ALL SURFACE MOUNT ENCLOSURES FOR PULL STATIONS AND SKIRTS FOR ALL VISUAL AND AUDIO VISUAL DEVICES TO CONCEAL 4S BACK BOXES.
17. AFTER THE SYSTEM IS COMPLETED, ALL ADDRESSABLE DEVICES SHALL BE PROGRAMMED AT THE FIRE ALARM CONTROL ACCORDING TO THE ACTUAL APARTMENT UNIT NUMBER OR LOCATION DESCRIPTIONS AS INDICATED BY THE UNIVERSITY.
18. POWER SERVICES SHALL BE ON A DEDICATED BRANCH CIRCUIT WITH A RED MARKING AND IDENTIFIED AS "FIRE ALARM".
19. AUDIBLE FIRE ALARM SOUND LEVEL SHALL BE AT LEAST 90 dBA MEASURED AT 10 FEET FROM THE DEVICE.
20. FIRE ALARM CONTRACTOR SHALL PROVIDE A "RECORD OF COMPLETION" TO THE CAMPUS FIRE MARSHALL PRIOR COMPLETION OF OPERATION ACCEPTANCE TEST.
21. CONTRACTOR SHALL MAKE ALL NECESSARY ARRANGEMENTS WITH THE CAMPUS MARSHALL FOR THE PRE-WIRE INSPECTION OF EACH SYSTEM AS REQUIRED. APPROVAL BY THE CAMPUS FIRE MARSHALL SHALL BE OBTAINED BEFORE FURTHER INSTALLATIONS ARE COMMENCED.
22. EACH NEW SYSTEM, UPON COMPLETION, SHALL BE CERTIFIED AS PER CAMPUS FIRE MARSHALL REQUIREMENTS.
23. FIRE ALARM CABLING SHALL BE NEATLY BUNDLED ABOVE CEILING SPACE. CADDY CLIP ALL WIRE BUNDLES.
24. ALL CONDUIT STRAPS SHALL BE (2) HOLE TYPE. (1) HOLE TYPE CONDUIT STRAPS ARE NOT ALLOWED.
25. CONDUIT SET-SCREW - FITTINGS ARE NOT ALLOWED.

PROJECT: 2019-05-07, FALKIRK, AND, (A) IMPROVEMENTS TO FA/FAC/RS/ST, 2019-05-07, SAMUEL, ELIA

miyamoto. logo and contact information: 1901 East Alton Avenue, Suite 100, Santa Ana, CA 92705, MI19001100

DESIGN WEST ENGINEERING logo and contact information: 225 W. Highland Ave, Suite #100, San Bernardino, CA 92408, Fax: 909.392.0700, Email: ccs@designwesteng.com


UNIVERSITY OF CALIFORNIA, RIVERSIDE logo and project title: FALKIRK SITE AND SEISMIC IMPROVEMENTS - SUMMER 2019, 3429 CANYON CREST DRIVE, RIVERSIDE, CA 92507

REVISIONS table with columns for revision number, description, and date. Includes 'ADDENDUM 1 6/14/19' and 'ADDENDUM 2 6/26/19'. Also includes 'FIRE ALARM LEGENDS & NOTES FA-0.1' and 'OFFICE OF THE STATE FIRE MARSHAL APPROVED FIRE AND PANIC ONLY 07/02/2019'.

DESIGNATION	TYPE
S	#18/4 FPLP SHIELDED FIRE CABLE (DATA LOOP)
N	#12/2 FPLP FIRE CABLE (HORN/VISUAL)
D	#18/4 FPLP FIRE CABLE (REMOTE ANNUNCIATOR)
E	2#14THWN AWG BUILDING WIRE
'U' - DESIGNATES UNDERGROUND RATED CABLING	

GENERAL NOTES

- ALL WIRING AND CABLING SHOWN IN UNDERGROUND INSTALLATIONS SHALL BE RATED FOR UNDERGROUND USE.
- REFERENCE ELECTRICAL DRAWINGS FOR EXACT CONDUIT ROUTING.
- FIRST FLOOR CABLING SHALL BE RAN USING WIREMOLD RACEWAYS. REFERENCE SHEET FA-3.1 FOR EXACT WIREMOLD REQUIREMENTS.

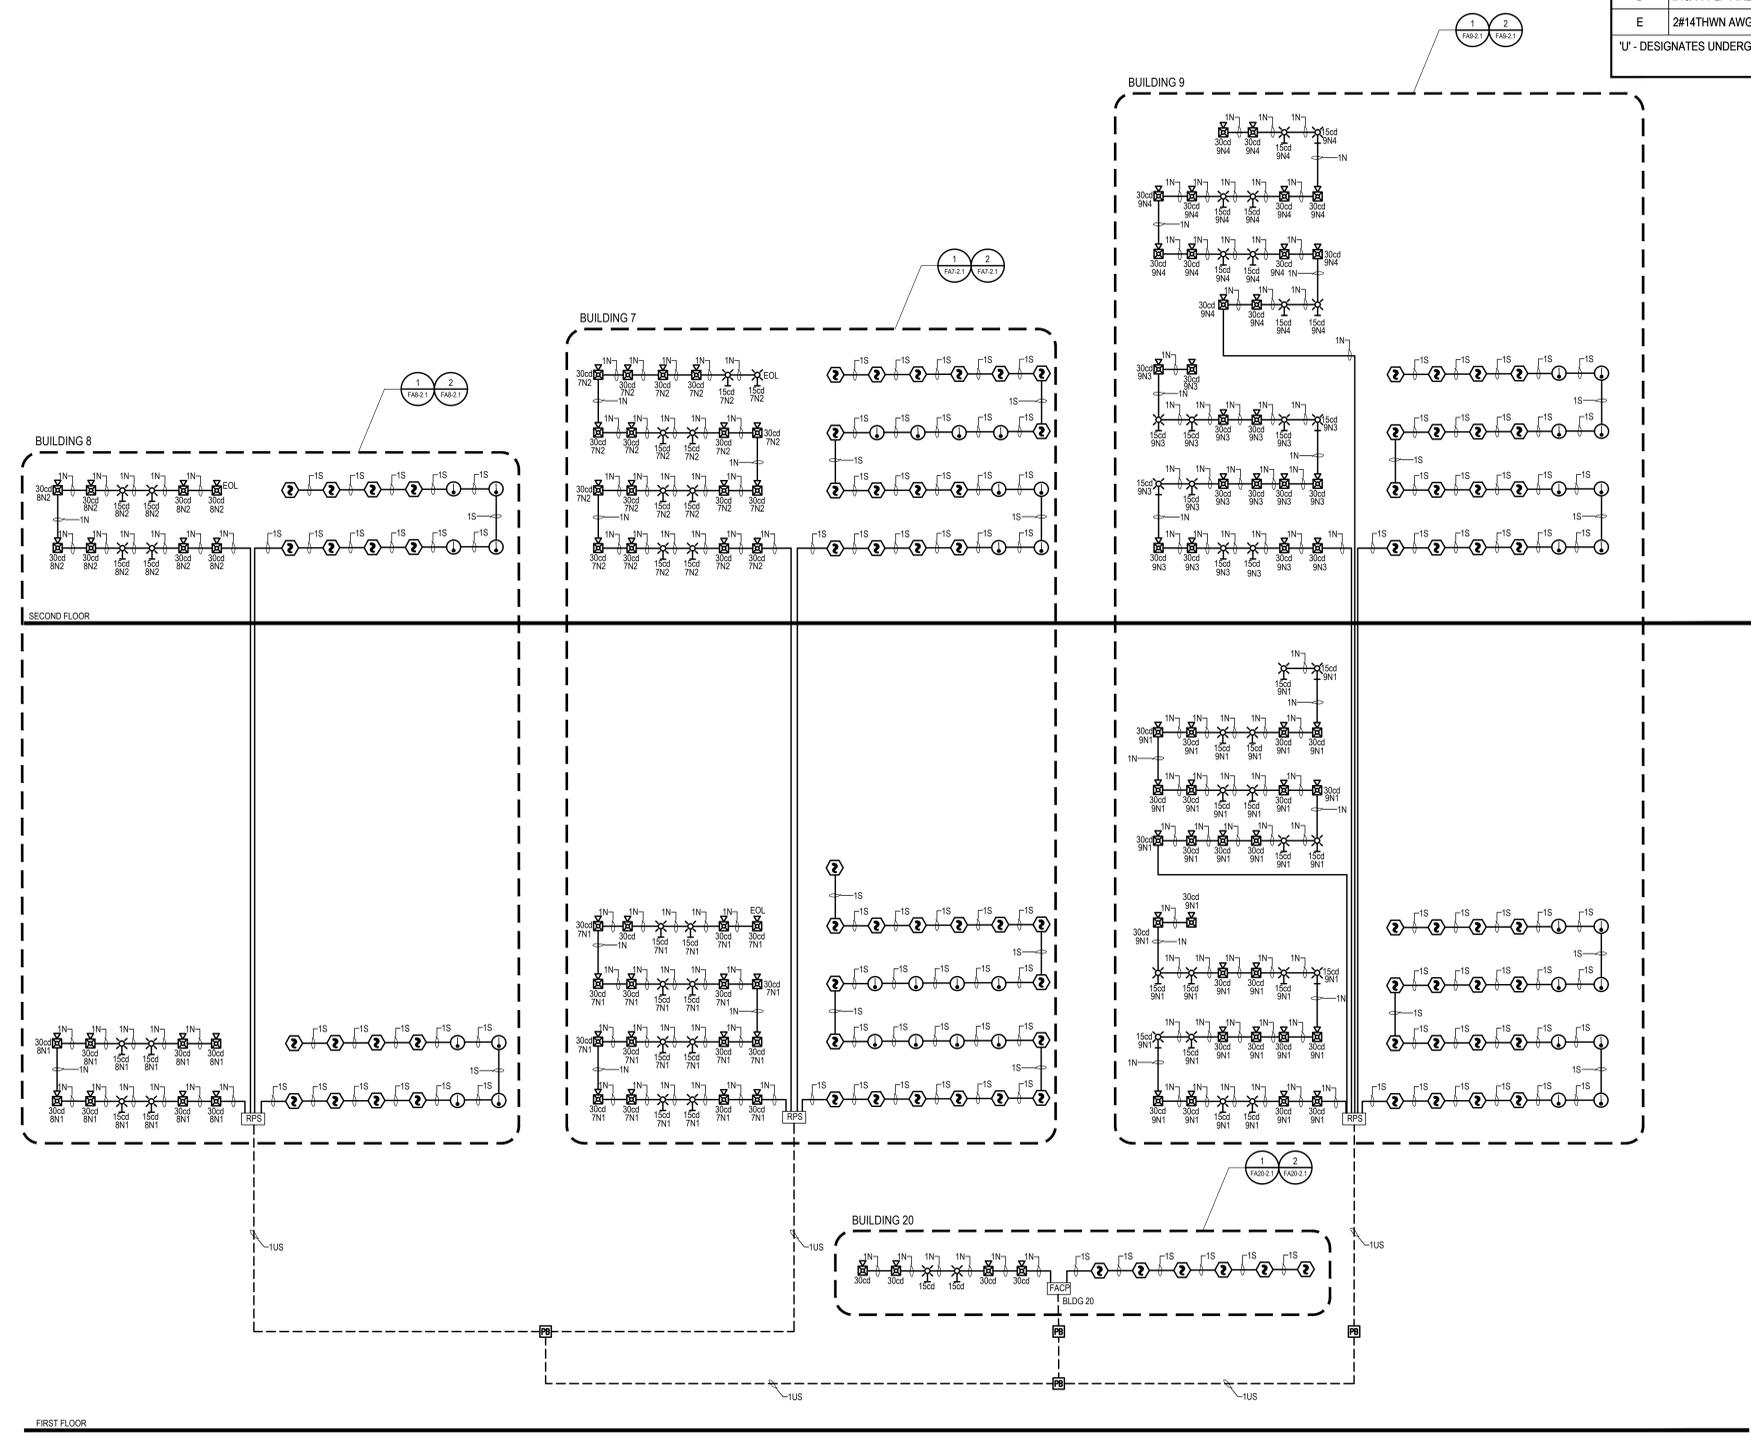

CONSTRUCTION NOTES

miyamoto.
 1901 East Alton Avenue, Suite 100
 Santa Ana, CA 92705
 T: (949) 579-1770
 mmiyamoto@miyamoto.com



221 W. Highland Ave., Suite #100
 San Bernardino, CA 92408
 P: (909) 392-0700
 Email: ccs@designwesteng.com

DESIGN WEST ENGINEERING
 MECHANICAL • ELECTRICAL • ENERGY CONSULTANTS

UNIVERSITY OF CALIFORNIA, RIVERSIDE
 FALKIRK SITE AND SEISMIC IMPROVEMENTS - SUMMER 2019
 3429 CANYON CREST DRIVE
 RIVERSIDE, CA 92507

REVISIONS

1	ADDENDUM 1	6/14/19
2	ADDENDUM 2	6/26/19

UCR PROJECT #: 956390
 UCR CAAN #: P5673
 DATE: 06-14-2019
 DRAWN: S.V

RISER DIAGRAM
FA-0.2

INSPECTIONS REQUIRED
 UC RIVERSIDE
 Office of Planning, Design & Construction
 Signed CBO: *Robert K. Williams*
 Building, Safety and Compliance Division
 CAMPUS BUILDING PERMIT
 ALL WORK SHALL BE PERFORMED TO THE 2019 CALIFORNIA ELECTRICAL CODE

APPROVED
 UC Riverside
 Planning, Design and Construction
 Campus Building Official
 Signature: *Robert K. Williams*
 Building & Safety Division
 Campus Building Permit

OFFICE OF THE STATE FIRE MARSHAL
 APPROVED FIRE AND PANIC ONLY
07/02/2019
 Approval of this plan does not authorize or approve any emission or deviation from applicable regulations. Final approval is subject to field inspection. One set of approved plans shall be available on the project site at all times.
 Reviewed by: *Heath Johnson*
 Fire and Life Safety Division

RISER DIAGRAM SCALE: 1/8" = 1'-0" 1

BATTERY SIZING CALCULATION 06/28/19
UCR FALKIRK - BUILDING 7
RPS7

Quantity	Device Type	Model Number	Standby Current	Total Standby Current	Alarm Current	Total Alarm Current
1	AL100ZULADA	AL100ZULADA	0.09000	0.09000	0.17500	0.17500
32	Hom/Strobe	P2W (30cd)	0.00000	0.00000	0.10700	3.42400
16	Strobe	SW (15cd)	0.00000	0.00000	0.06600	1.05600

Standby Load: 0.090
Alarm Load: 4.655

Standby Load: 0.090 Amps
Standby Time: 24 Hours
Total Standby Load: 2.16 Amp*Hours

Alarm Load: 4.655 Amps
Alarm Time: 5 Minutes
Total Alarm Load: 0.39 Amp*Hours

Batteries Provided: (2) BAT-1270
Available Battery: 5.60 A.H.
Battery Size: 7.00 A.H.
De-Rated Size(80%): 5.60 A.H.

BATTERY SIZING CALCULATION 06/14/19
UCR FALKIRK - BUILDING 8
RPS8

Quantity	Device Type	Model Number	Standby Current	Total Standby Current	Alarm Current	Total Alarm Current
1	AL100ZULADA	AL100ZULADA	0.09000	0.09000	0.17500	0.17500
16	Hom/Strobe	P2W (30cd)	0.00000	0.00000	0.10700	1.71200
8	Strobe	SW (15cd)	0.00000	0.00000	0.06600	0.52800

Standby Load: 0.090
Alarm Load: 2.415

Standby Load: 0.090 Amps
Standby Time: 24 Hours
Total Standby Load: 2.16 Amp*Hours

Alarm Load: 2.415 Amps
Alarm Time: 5 Minutes
Total Alarm Load: 0.20 Amp*Hours

Batteries Provided: (2) BAT-1270
Available Battery: 5.60 A.H.
Battery Size: 7.00 A.H.
De-Rated Size(80%): 5.60 A.H.

BATTERY SIZING CALCULATION 06/14/19
UCR FALKIRK - BUILDING 9
RPS9

Quantity	Device Type	Model Number	Standby Current	Total Standby Current	Alarm Current	Total Alarm Current
1	AL100ZULADA	AL100ZULADA	0.09000	0.09000	0.17500	0.17500
48	Hom/Strobe	P2W (30cd)	0.00000	0.00000	0.10700	5.13600
32	Strobe	SW (15cd)	0.00000	0.00000	0.06600	2.11200

Standby Load: 0.090
Alarm Load: 7.423

Standby Load: 0.090 Amps
Standby Time: 24 Hours
Total Standby Load: 2.16 Amp*Hours

Alarm Load: 7.423 Amps
Alarm Time: 5 Minutes
Total Alarm Load: 0.62 Amp*Hours

Batteries Provided: (2) BAT-1270
Available Battery: 5.60 A.H.
Battery Size: 7.00 A.H.
De-Rated Size(80%): 5.60 A.H.

BATTERY SIZING CALCULATION 06/14/19
UCR FALKIRK
MAIN FIRE ALARM CONTROL PANEL

Quantity	Device Type	Model Number	Standby Current	Total Standby Current	Alarm Current	Total Alarm Current
1	4100	4100	0.12000	0.12000	0.20000	0.20000
40	Heat Det	4098-9402	0.00030	0.01200	0.00680	0.27200
87	Smoke Det	4098-9754	0.00030	0.02610	0.00680	0.59160
4	Hom/Strobe	P2W (30cd)	0.00000	0.00000	0.10700	0.42800
2	Strobe	SW (15cd)	0.00000	0.00000	0.06600	0.13200

Standby Load: 0.158
Alarm Load: 1.624

Standby Load: 0.158 Amps
Standby Time: 24 Hours
Total Standby Load: 3.79 Amp*Hours

Alarm Load: 1.624 Amps
Alarm Time: 5 Minutes
Total Alarm Load: 0.14 Amp*Hours

Batteries Provided: (2) BAT-12180
Available Battery: 14.40 A.H.
Battery Size: 18.00 A.H.
De-Rated Size(80%): 14.40 A.H.

VOLTAGE DROP CALCULATION 06/28/19
UCR FALKIRK - BUILDING 7
RPS7

SYSTEM SENSOR	DEVICE CURR. (AMPS)	SIGNAL CIRCUIT	SIGNAL CIRCUIT	SIGNAL CIRCUIT	SIGNAL CIRCUIT	QTY	TOTAL
Hom/Strobe	0.107	16	1.712	16	1.712	0.000	0.000
Strobe	0.066	8	0.528	8	0.528	0.000	0.000
SW (15cd)	0.066	8	0.528	8	0.528	0.000	0.000

TOTAL CURRENT ON CIRCUIT: 2.340 AMPS
 TOTAL WIRE LENGTH: 450 FT.
 WIRE SIZE: 12 AWG
 CIRCULAR MILS: 6530 CIRC MILS
 VOLTAGE DROP: 3.33 VOLTS
 VOLTAGE @ END OF CIRCUIT: 17.1 VOLTS
 CIRCUIT LOCATION: 1ST FLOOR

VOLTAGE DROP = TOTAL CURRENT x DISTANCE x 21.6
 CIRCULAR MILS
 18 AWG = 1620
 16 AWG = 2580
 14 AWG = 4110
 12 AWG = 6530

LISTED CIRCUIT VOLTAGE = 24V
 STARTING CIRCUIT VOLTAGE = 20.4V (85% LISTED VOLTAGE)
 OPERATING VOLTAGE RANGE FOR 24V NOTIFICATION APPLIANCES TO BE 16V-33V

VOLTAGE DROP CALCULATION 06/28/19
UCR FALKIRK - BUILDING 8
RPS8

SYSTEM SENSOR	DEVICE CURR. (AMPS)	SIGNAL CIRCUIT	SIGNAL CIRCUIT	SIGNAL CIRCUIT	SIGNAL CIRCUIT	QTY	TOTAL
Hom/Strobe	0.107	8	0.856	8	0.856	0.000	0.000
Strobe	0.066	4	0.264	4	0.264	0.000	0.000
SW (15cd)	0.066	4	0.264	4	0.264	0.000	0.000

TOTAL CURRENT ON CIRCUIT: 1.120 AMPS
 TOTAL WIRE LENGTH: 280 FT.
 WIRE SIZE: 12 AWG
 CIRCULAR MILS: 6530 CIRC MILS
 VOLTAGE DROP: 1.04 VOLTS
 VOLTAGE @ END OF CIRCUIT: 19.4 VOLTS
 CIRCUIT LOCATION: 1ST FLOOR

VOLTAGE DROP = TOTAL CURRENT x DISTANCE x 21.6
 CIRCULAR MILS
 18 AWG = 1620
 16 AWG = 2580
 14 AWG = 4110
 12 AWG = 6530

LISTED CIRCUIT VOLTAGE = 24V
 STARTING CIRCUIT VOLTAGE = 20.4V (85% LISTED VOLTAGE)
 OPERATING VOLTAGE RANGE FOR 24V NOTIFICATION APPLIANCES TO BE 16V-33V

VOLTAGE DROP CALCULATION 06/28/19
UCR FALKIRK - BUILDING 9
RPS9

SYSTEM SENSOR	DEVICE CURR. (AMPS)	SIGNAL CIRCUIT	SIGNAL CIRCUIT	SIGNAL CIRCUIT	SIGNAL CIRCUIT	QTY	TOTAL
Hom/Strobe	0.107	12	1.284	12	1.284	12	1.284
Strobe	0.066	8	0.528	8	0.528	8	0.528
SW (15cd)	0.066	8	0.528	8	0.528	8	0.528

TOTAL CURRENT ON CIRCUIT: 1.812 AMPS
 TOTAL WIRE LENGTH: 300 FT.
 WIRE SIZE: 12 AWG
 CIRCULAR MILS: 6530 CIRC MILS
 VOLTAGE DROP: 1.68 VOLTS
 VOLTAGE @ END OF CIRCUIT: 18.7 VOLTS
 CIRCUIT LOCATION: 1ST FLOOR

VOLTAGE DROP = TOTAL CURRENT x DISTANCE x 21.6
 CIRCULAR MILS
 18 AWG = 1620
 16 AWG = 2580
 14 AWG = 4110
 12 AWG = 6530

LISTED CIRCUIT VOLTAGE = 24V
 STARTING CIRCUIT VOLTAGE = 20.4V (85% LISTED VOLTAGE)
 OPERATING VOLTAGE RANGE FOR 24V NOTIFICATION APPLIANCES TO BE 16V-33V

VOLTAGE DROP CALCULATION 06/28/19
UCR FALKIRK - FACP
FACP

SYSTEM SENSOR	DEVICE CURR. (AMPS)	SIGNAL CIRCUIT	SIGNAL CIRCUIT	SIGNAL CIRCUIT	SIGNAL CIRCUIT	QTY	TOTAL
Hom/Strobe	0.107	4	0.428	0.000	0.000	0.000	0.000
Strobe	0.066	2	0.132	0.000	0.000	0.000	0.000
SW (15cd)	0.066	2	0.132	0.000	0.000	0.000	0.000

TOTAL CURRENT ON CIRCUIT: 0.660 AMPS
 TOTAL WIRE LENGTH: 450 FT.
 WIRE SIZE: 12 AWG
 CIRCULAR MILS: 6530 CIRC MILS
 VOLTAGE DROP: 1.68 VOLTS
 VOLTAGE @ END OF CIRCUIT: 19.6 VOLTS
 CIRCUIT LOCATION: 1ST FLOOR

VOLTAGE DROP = TOTAL CURRENT x DISTANCE x 21.6
 CIRCULAR MILS
 18 AWG = 1620
 16 AWG = 2580
 14 AWG = 4110
 12 AWG = 6530

LISTED CIRCUIT VOLTAGE = 24V
 STARTING CIRCUIT VOLTAGE = 20.4V (85% LISTED VOLTAGE)
 OPERATING VOLTAGE RANGE FOR 24V NOTIFICATION APPLIANCES TO BE 16V-33V

BATTERY SIZING CALCULATION 06/28/19
UCR FALKIRK
Dual Path Wireless Communicator

Quantity	Device Type	Model Number	Standby Current	Total Standby Current	Alarm Current	Total Alarm Current
1	IPGSM4G	IPGSM4G	0.23000	0.23000	0.95000	0.95000

Standby Load: 0.230
Alarm Load: 0.950

Standby Load: 0.230 Amps
Standby Time: 24 Hours
Total Standby Load: 5.52 Amp*Hours

Alarm Load: 0.950 Amps
Alarm Time: 5 Minutes
Total Alarm Load: 0.08 Amp*Hours

Batteries Provided: (1) ES7-12
Available Battery: 5.60 A.H.
Battery Size: 7.00 A.H.
De-Rated Size(80%): 5.60 A.H.

miyamoto.
 1901 East Alton Avenue, Suite 100
 Santa Ana, CA 92705
 MI1904011.00
 T: (949) 578-1170
 mmiyamoto@international.com



228 W. Hollywood Blvd, Suite #100
 San Bernardino, CA 92408
 Phone: (909) 392-0700
 Email: ccs@designwestengineering.com
DESIGN WEST ENGINEERING
 MECHANICAL - ELECTRICAL - ENERGY CONSULTANTS

UNIVERSITY OF CALIFORNIA, RIVERSIDE
FALKIRK SITE AND SEISMIC IMPROVEMENTS - SUMMER 2019
 3429 CANYON CREST DRIVE
 RIVERSIDE, CA 92507

REVISIONS

1	ADDENDUM 1	6/14/19
2	ADDENDUM 2	6/28/19

UCR PROJECT #: 956390
 UCR CAAN #: P5673
 DATE: 06-14-2019
 DRAWN: S.V


INSPECTIONS REQUIRED
 UC RIVERSIDE
 Office of Planning, Design & Construction
 Signed CBO: Robert K. Williams
 Building Safety and Compliance Division
 CAMPUS BUILDING PERMIT

APPROVED
 UC Riverside
 Planning, Design and Construction
 Campus Building Official
 Signature: Robert K. Williams
 Building & Safety Division
 Campus Building Division

OFFICE OF THE STATE FIRE MARSHAL
 APPROVED FIRE AND PANIC ONLY
 07/02/2019
 Approval of this plan does not authorize or approve any emission or deviation from applicable regulations. Final approval is subject to field inspection. One set of approved plans shall be available on the project site at all times.
 Reviewed by: [Signature]

FIRE ALARM CALCULATIONS
FA-0.3

R:\PROJECTS\2019\06\UCR FALKIRK\4.00 IMPROVEMENTS\05-07\FALCSE-2019-06-28_SAMUEL.MEA

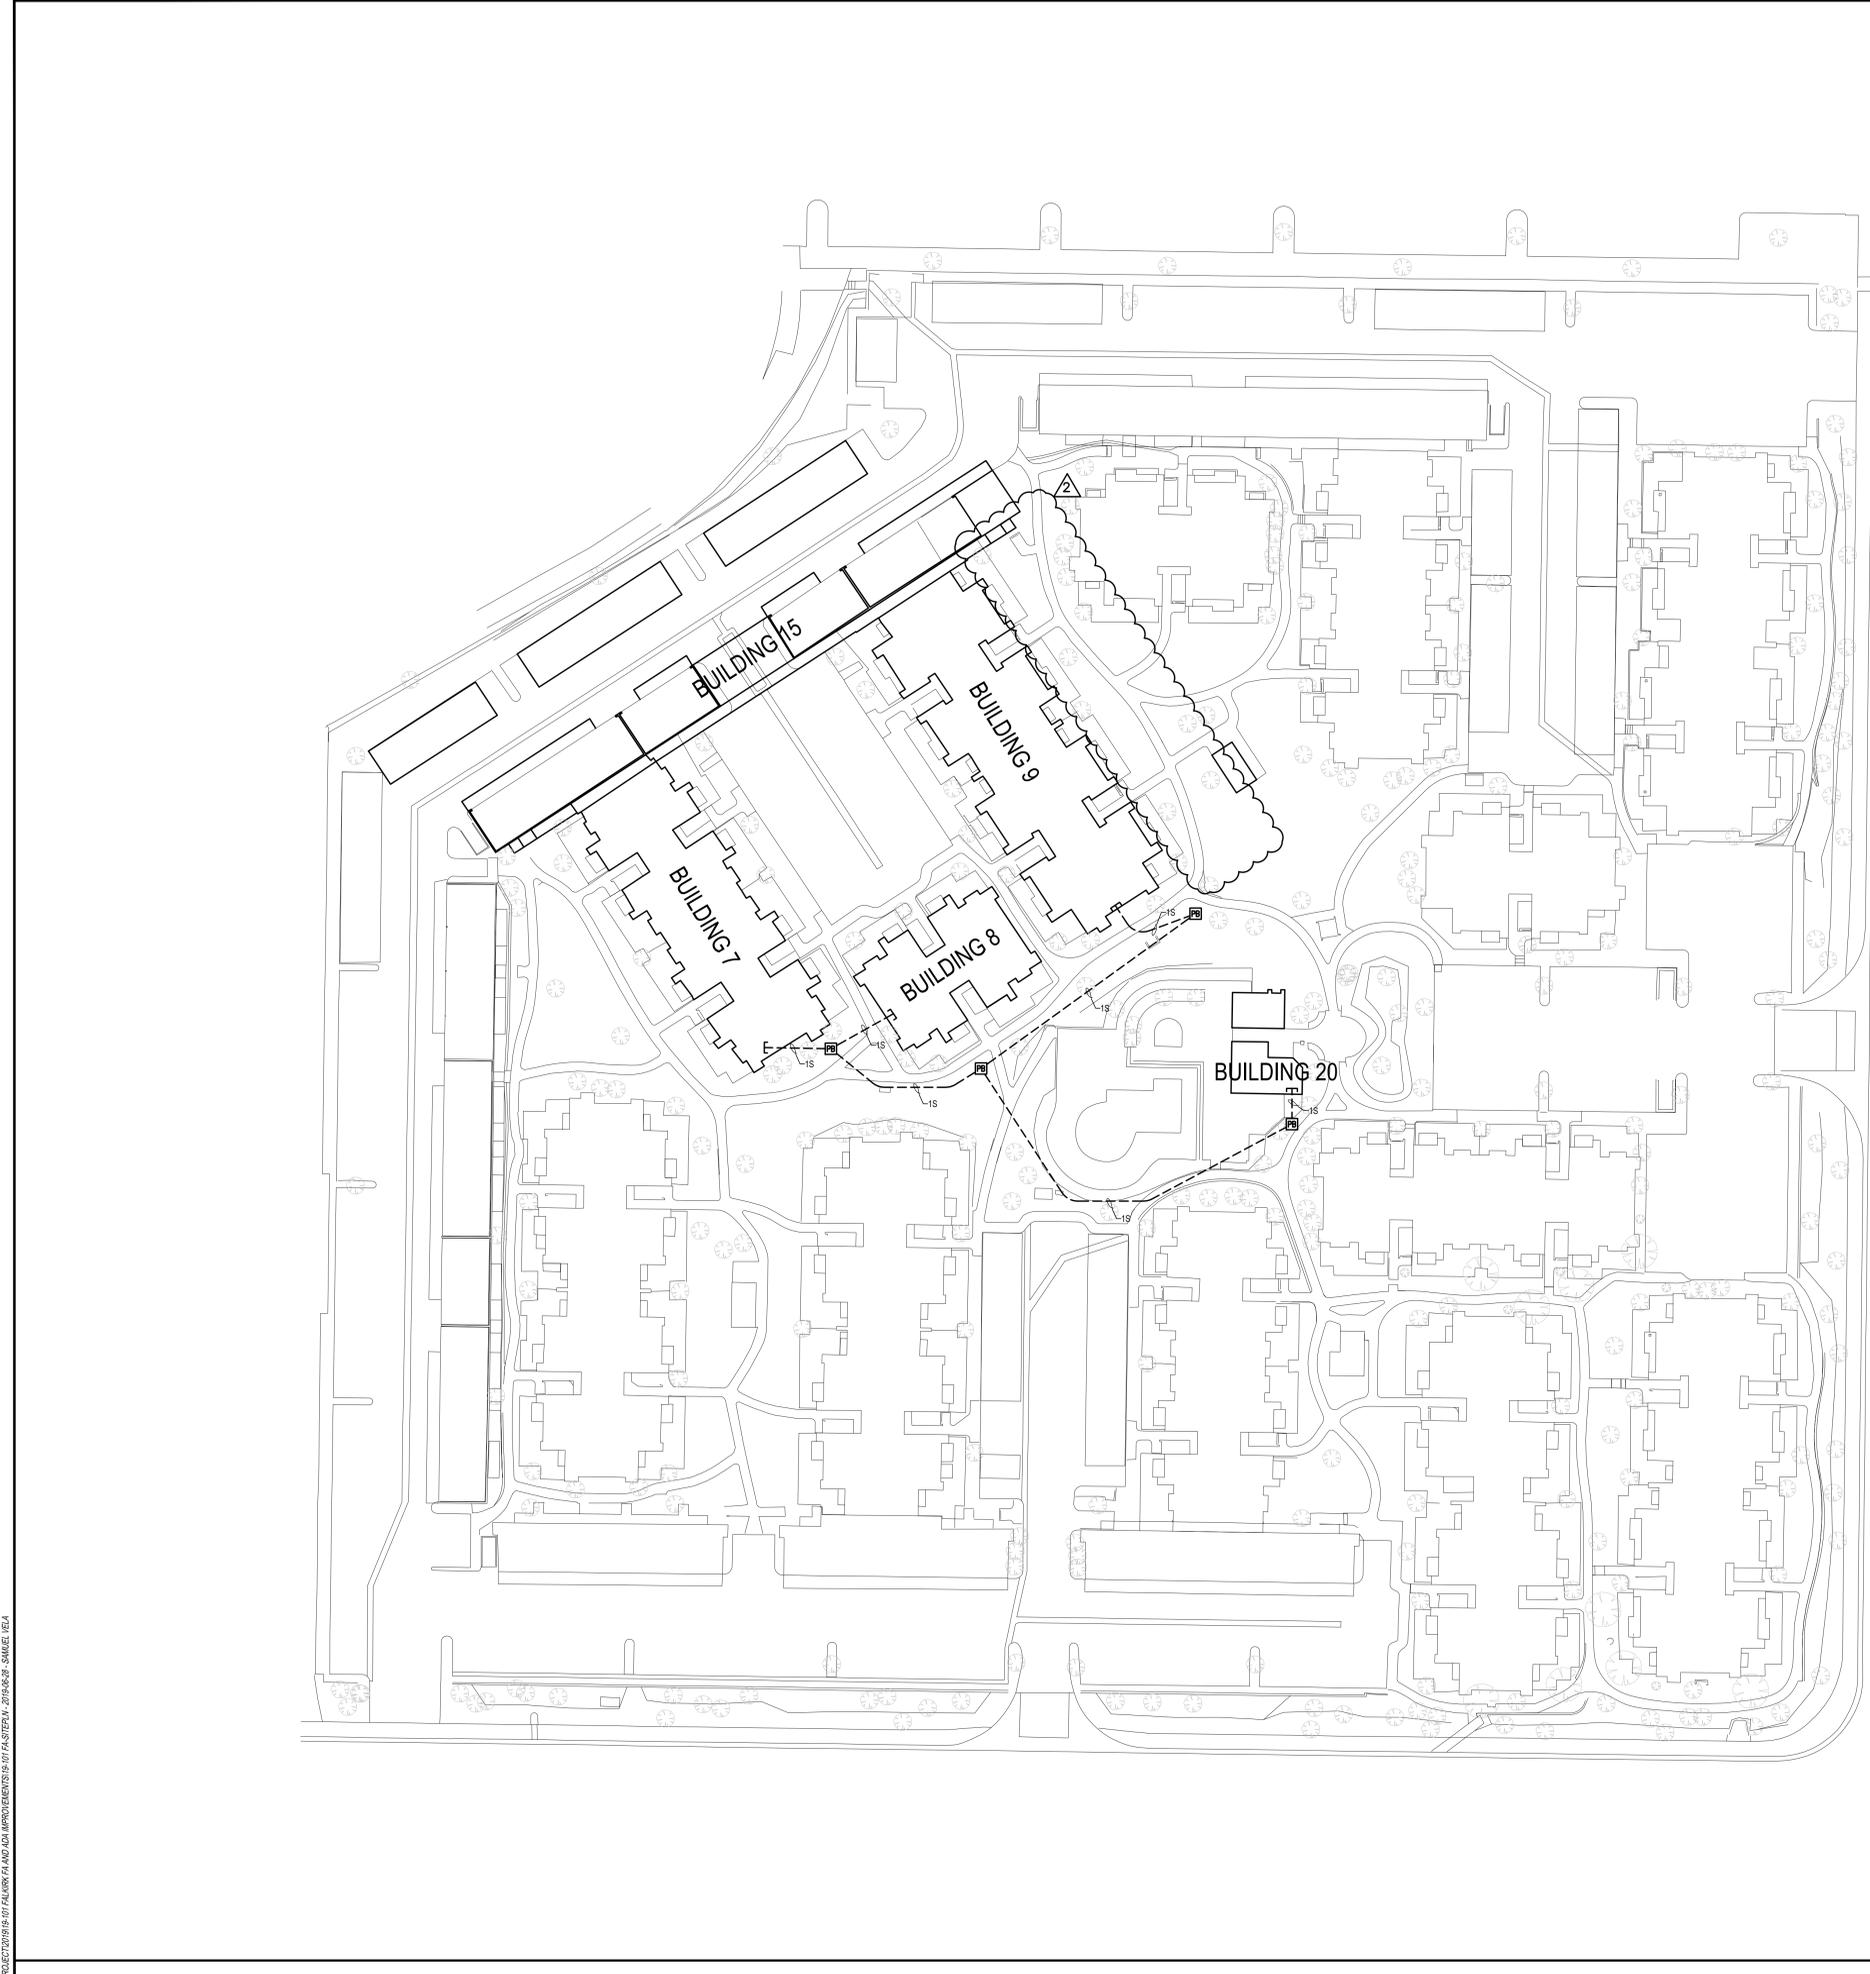

DESIGNATION	TYPE
S	#18/4 FPLP SHIELDED FIRE CABLE (DATA LOOP)
N	#14/2 FPLP FIRE CABLE (HORN/VISUAL)
D	#18/4 FPLP FIRE CABLE (REMOTE ANNUNCIATOR)
E	2#14THWN AWG BUILDING WIRE

GENERAL NOTES

- ALL WIRING AND CABLING SHOWN IN UNDERGROUND INSTALLATIONS SHALL BE RATED FOR UNDERGROUND USE.
- REFERENCE ELECTRICAL DRAWINGS FOR EXACT CONDUIT ROUTING.

CONSTRUCTION NOTES

miyamoto.
 1901 East Alhambra Avenue, Suite 100
 Santa Ana, CA 92705
 T: (949) 579-1770
 myamotointernational.com



221 W. High Street, Suite #100
 San Bernardino, CA 92408
 Tel: (909) 392-0700
 Fax: (909) 392-0700
 Email: ccs@designwesteng.com

DESIGN WEST ENGINEERING
 MECHANICAL • ELECTRICAL • ENERGY CONSULTANTS

UNIVERSITY OF CALIFORNIA, RIVERSIDE
 FALKIRK SITE AND SEISMIC IMPROVEMENTS - SUMMER 2019
 3429 CANYON CREST DRIVE
 RIVERSIDE, CA 92507

REVISIONS

1	ADDENDUM 1	6/14/19
2	ADDENDUM 2	6/26/19

UCR PROJECT #: 956390
 UCR CAAN #: P5673
 DATE: 06-14-2019
 DRAWN: S.V

INSPECTIONS REQUIRED
 UC RIVERSIDE
 Office of Planning, Design & Construction
 Building, Safety and Compliance Division
 CAMPUS BUILDING PERMIT
 All work shall be in accordance with the California Building Code.

APPROVED
 UC Riverside
 Planning, Design and Construction
 Campus Building Official
 Signature: *Robert K. Williams*
 Building & Safety Division
 Campus Building Permit

OFFICE OF THE STATE FIRE MARSHAL
 APPROVED FIRE AND PANIC ONLY
 07/02/2019
 Approval of this plan does not authorize or approve any emission or deviation from applicable regulations. Final approval is subject to field inspection. One set of approved plans shall be available on the project site at all times.
 Reviewed by: *Heath Johnson*
 Fire and Life Safety Division

FIRE ALARM SITE PLAN
FA-1.0

RL PROJECT 2019 05 07 FALKIRK SITE AND SEISMIC IMPROVEMENTS BY FASTENLY 20190528-SAMEE.DWG

DESIGNATION	TYPE
S	#18/4 FPLP SHIELDED FIRE CABLE (DATA LOOP)
N	#12/2 FPLP FIRE CABLE (HORN/VISUAL)
D	#18/4 FPLP FIRE CABLE (REMOTE ANNUNCIATOR)
E	2#14THWN AWG BUILDING WIRE
'U' - DESIGNATES UNDERGROUND RATED CABLING	


GENERAL NOTES

- ALL WIRING AND CABLING SHOWN IN UNDERGROUND INSTALLATIONS SHALL BE RATED FOR UNDERGROUND USE.
- REFERENCE ELECTRICAL DRAWINGS FOR EXACT CONDUIT ROUTING.
- FIRST FLOOR CABLING SHALL BE FOR USING WIREMOLD RACEWAYS. REFERENCE SHEET FA-3.1 FOR EXACT WIREMOLD REQUIREMENTS.

miyamoto.
 1901 East Alton Avenue, Suite 100
 Santa Ana, CA 92705
 MI904011.00
 T: (949) 579-1170
 miyamotointernational.com




221 W. Highland Ave., Suite #100
 San Bernardino, CA 92408
 Tel: (909) 392-0700
 Fax: (909) 392-0700
 Email: ccs@designwesteng.com
DESIGN WEST ENGINEERING
 MECHANICAL • ELECTRICAL • ENERGY CONSULTANTS

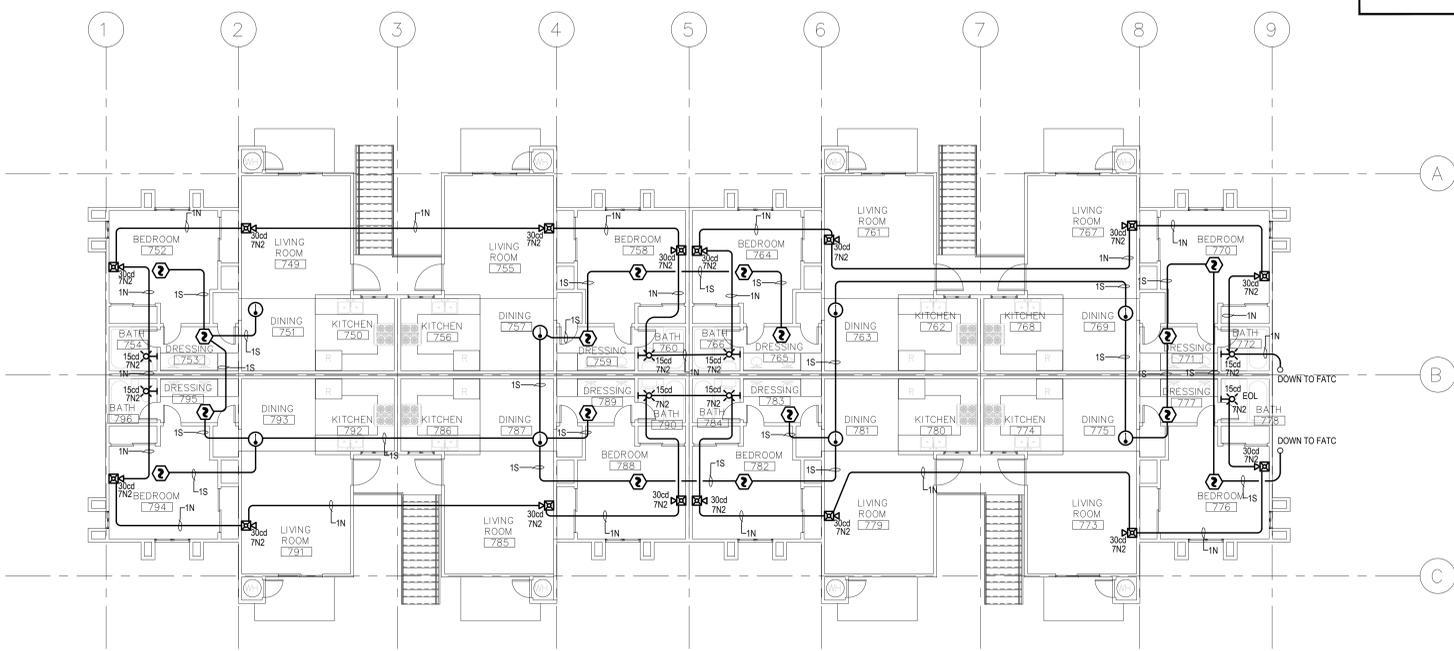

FIRE ALARM PLAN - BUILDING 7 SECOND FLOOR SCALE: 1/8" = 1'-0" 1

CONSTRUCTION NOTES

- PROVIDE J-BOX AT BUILDING BASE FOR IUG CONDUIT STUBUP. CONTINUE WIRING FROM J-BOX INTO ELECTRICAL CLOSET TO THE NEW FATC IN EXPOSED SURFACE CONDUIT.
- ROUTE FIRE ALARM CIRCUITS FROM FATC IN EXPOSED SURFACE CONDUIT THROUGH WALL. CONTINUE CONDUIT BELOW GRADE AND STUB OUTSIDE EXISTING WATER HEATER CLOSET AND INTO CLOSET.

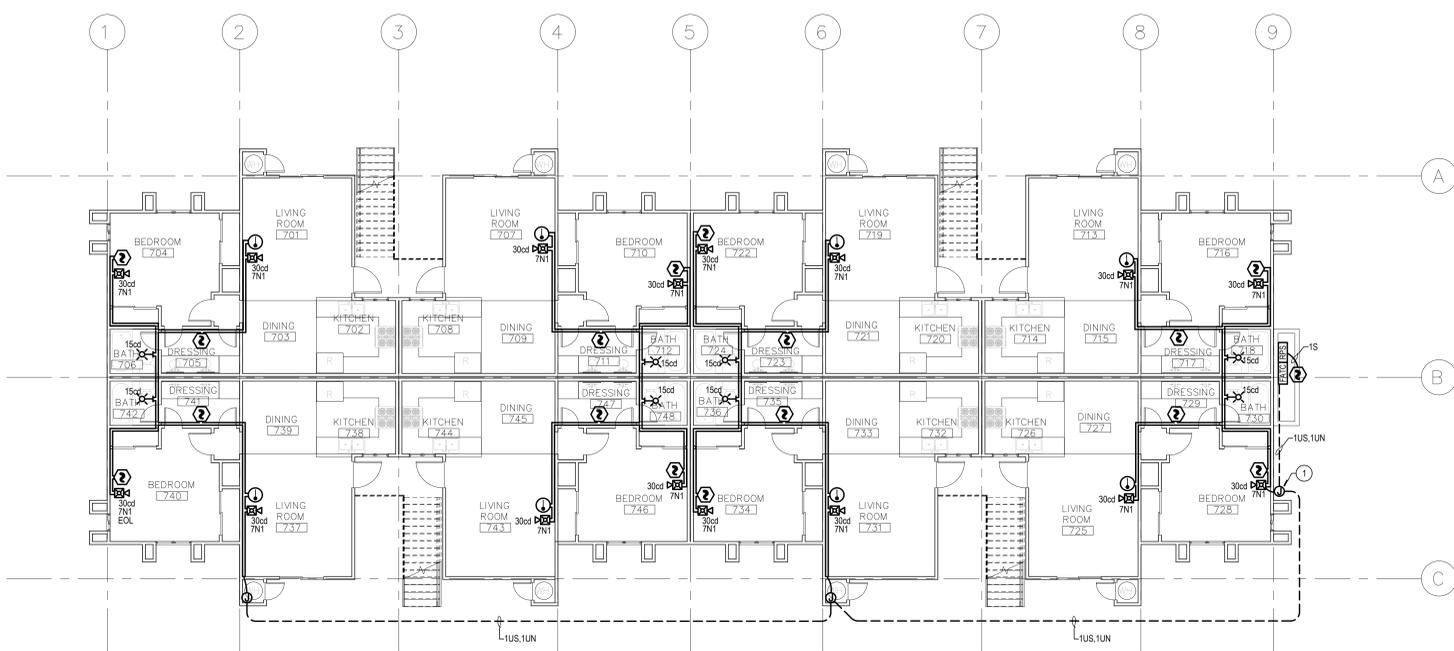

FIRE ALARM PLAN - BUILDING 7 FIRST FLOOR SCALE: 1/8" = 1'-0" 2

UNIVERSITY OF CALIFORNIA, RIVERSIDE
 FALKIRK SITE AND SEISMIC IMPROVEMENTS - SUMMER 2019
 3429 CANYON CREST DRIVE
 RIVERSIDE, CA 92507

REVISIONS

1	ADDENDUM 1	6/14/19
2	ADDENDUM 2	6/28/19

UCR PROJECT #: 956390
 UCR CAAN #: P5673
 DATE: 06-14-2019
 DRAWN: S.V

INSPECTIONS REQUIRED
 UC RIVERSIDE
 Office of Planning, Design & Construction
 Signed: *Robert K. Williams*
 Building, Safety and Compliance Division
 CAMPUS BUILDING PERMIT
ALL WORK SHALL BE IN ACCORDANCE WITH THE CALIFORNIA FIRE CODE

APPROVED
 UC Riverside
 Planning, Design and Construction
 Campus Building Official
 Signature: *Robert K. Williams*
 Building & Safety Division
 Campus Building Permit

OFFICE OF THE STATE FIRE MARSHAL
 APPROVED FIRE AND PANIC ONLY
07/02/2019
 Approval of this plan does not authorize or approve any erection or alteration from applicable regulations. Final approval is subject to field inspection. One set of approved plans shall be available on the project site at all times.
 Reviewed by: *Scott Johnson*
 Fire and Life Safety Division Chief


FIRE ALARM FLOOR PLAN - BUILDING 7
FA7-2.1

RL PROJECT 2019/05/07 FALKIRK SITE AND SEISMIC IMPROVEMENTS BY FAB/CDT/DP/AN - 2019/06/28 - SHAMEL/EA

DESIGNATION	TYPE
S	#18/4 FPLP SHIELDED FIRE CABLE (DATA LOOP)
N	#12/2 FPLP FIRE CABLE (HORN/VISUAL)
D	#18/4 FPLP FIRE CABLE (REMOTE ANNUNCIATOR)
E	2#14THWN AWG BUILDING WIRE
'U' - DESIGNATES UNDERGROUND RATED CABLING	

GENERAL NOTES


- ALL WIRING AND CABLING SHOWN IN UNDERGROUND INSTALLATIONS SHALL BE RATED FOR UNDERGROUND USE.
- REFERENCE ELECTRICAL DRAWINGS FOR EXACT CONDUIT ROUTING.
- FIRST FLOOR CABLING SHALL BE RAN USING WIREMOLD RACEWAYS. REFERENCE SHEET FA-3.1 FOR EXACT WIREMOLD REQUIREMENTS.

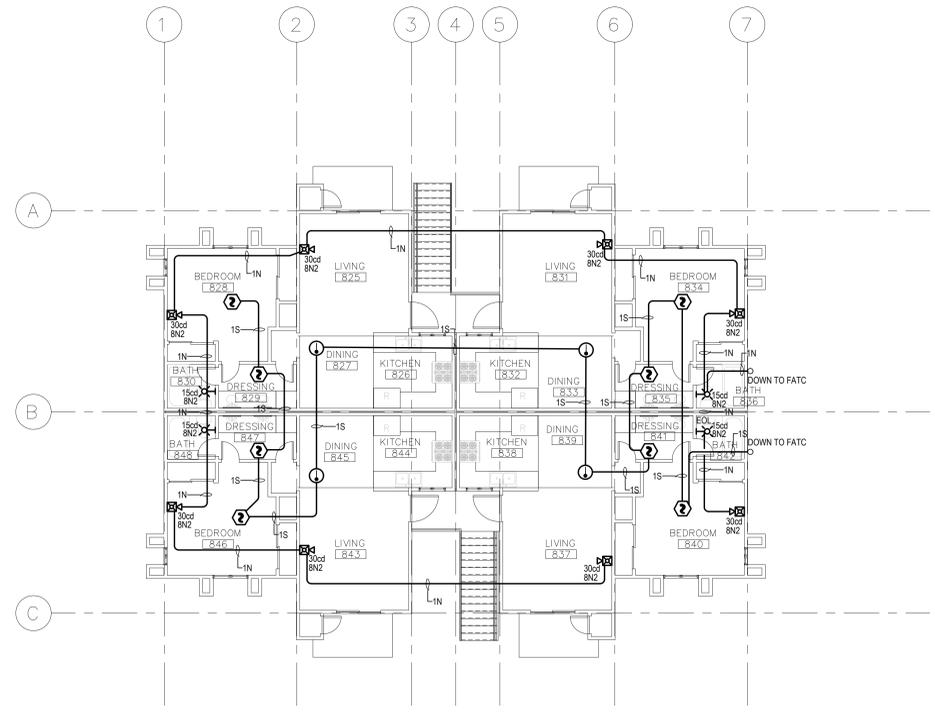

FIRE ALARM PLAN - BUILDING 8 SECOND FLOOR SCALE: 1/8" = 1'-0" 1

CONSTRUCTION NOTES

- PROVIDE J-BOX AT BUILDING BASE FOR LUG CONDUIT STUBUP. CONTINUE WIRING FROM J-BOX INTO ELECTRICAL CLOSET TO THE NEW FATC IN EXPOSED SURFACE CONDUIT.
- ROUTE FIRE ALARM CIRCUITS FROM FATC IN EXPOSED SURFACE CONDUIT THROUGH WALL. CONTINUE CONDUIT BELOW GRADE AND STUB OUTSIDE EXISTING WATER HEATER CLOSET AND INTO CLOSET.

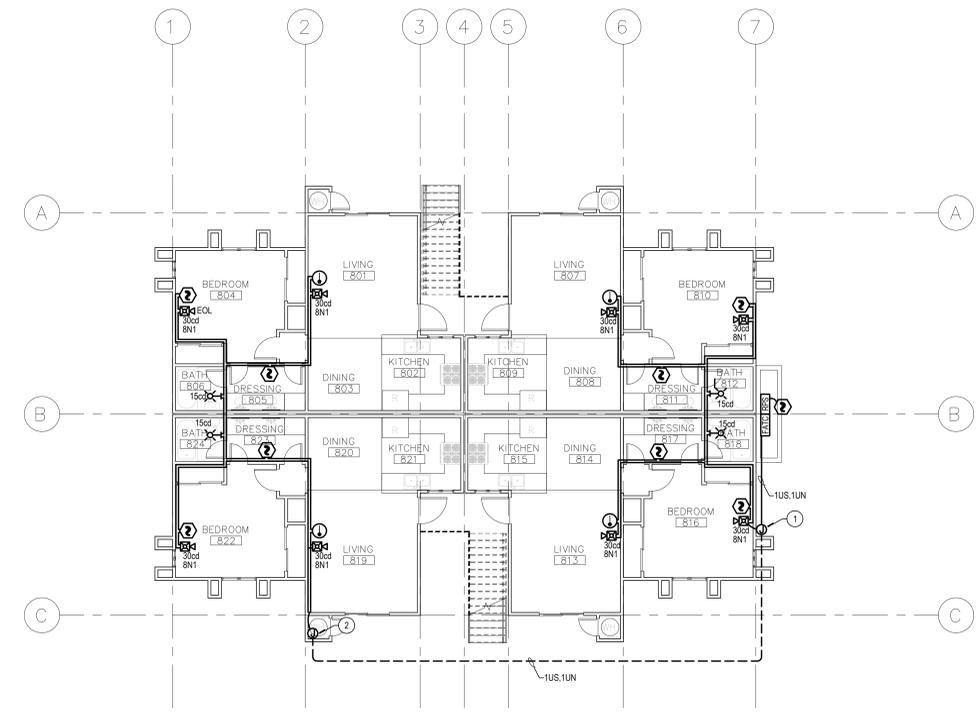

FIRE ALARM PLAN - BUILDING 8 FIRST FLOOR SCALE: 1/8" = 1'-0" 2



UNIVERSITY OF CALIFORNIA, RIVERSIDE
FALKIRK SITE AND SEISMIC IMPROVEMENTS - SUMMER 2019
3429 CANYON CREST DRIVE
RIVERSIDE, CA 92507

REVISIONS

1	ADDENDUM 1	6/14/19
2	ADDENDUM 2	6/26/19

UCR PROJECT #: 956390
UCR CAAN #: P5673
DATE: 06-14-2019
DRAWN: S.V

INSPECTIONS REQUIRED
UC RIVERSIDE
Office of Planning, Design & Construction
Signed: CBO: Blair S. Bellows
Building, Safety and Compliance Division
CAMPUS BUILDING PERMIT
ALL WORK SHALL BE SUBJECT TO THE USGS REVIEW

APPROVED
UC Riverside
Planning, Design and Construction
Campus Building Official
Signature: Robert K. Williams
Building & Safety Division
Campus Building Permit

OFFICE OF THE STATE FIRE MARSHAL
APPROVED FIRE AND PANIC ONLY
07/02/2019
Approval of this plan does not authorize or approve any emission or deviation from applicable regulations. Final approval is subject to field inspection. One set of approved plans shall be available on the project site at all times.
Reviewed by: [Signature]


FIRE ALARM FLOOR PLAN - BUILDING 8
FA8-2.1

RL PROJECT 2019 05 07 FALKIRK SITE AND SEISMIC IMPROVEMENTS BY FALC/DOR/PAK - 2019-06-26 - SHAMEL VELA

DESIGNATION	TYPE
S	#18/4 FPLP SHIELDED FIRE CABLE (DATA LOOP)
N	#12/2 FPLP FIRE CABLE (HORN/VISUAL)
D	#18/4 FPLP FIRE CABLE (REMOTE ANNUNCIATOR)
E	2#14THWN AWG BUILDING WIRE
'U' - DESIGNATES UNDERGROUND RATED CABLING	

GENERAL NOTES


- ALL WIRING AND CABLING SHOWN IN UNDERGROUND INSTALLATIONS SHALL BE RATED FOR UNDERGROUND USE.
- REFERENCE ELECTRICAL DRAWINGS FOR EXACT CONDUIT ROUTING.
- FIRST FLOOR CABLING SHALL BE RAN USING WIREMOLD RACEWAYS. REFERENCE SHEET FA-3.1 FOR EXACT WIREMOLD REQUIREMENTS.

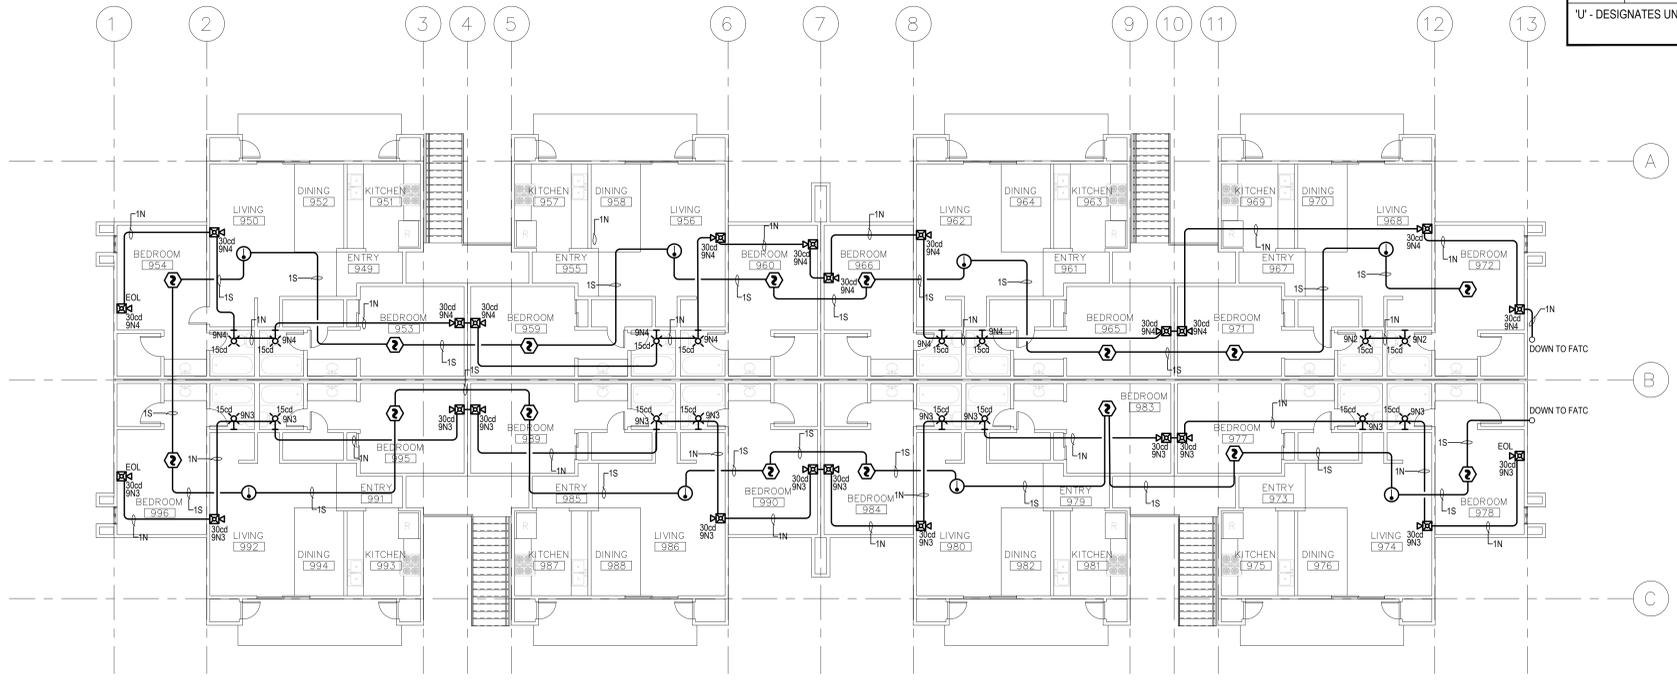

FIRE ALARM PLAN - BUILDING 9 SECOND FLOOR SCALE: 1/8" = 1'-0" 1

CONSTRUCTION NOTES

- PROVIDE J-BOX AT BUILDING BASE FOR LUG CONDUIT STUBUP. CONTINUE WIRING FROM J-BOX INTO ELECTRICAL CLOSET TO THE NEW FATC IN EXPOSED SURFACE CONDUIT.
- ROUTE FIRE ALARM CIRCUITS FROM FATC IN EXPOSED SURFACE CONDUIT THROUGH WALL. CONTINUE CONDUIT BELOW GRADE AND STUB OUTSIDE EXISTING WATER HEATER CLOSET AND INTO CLOSET.

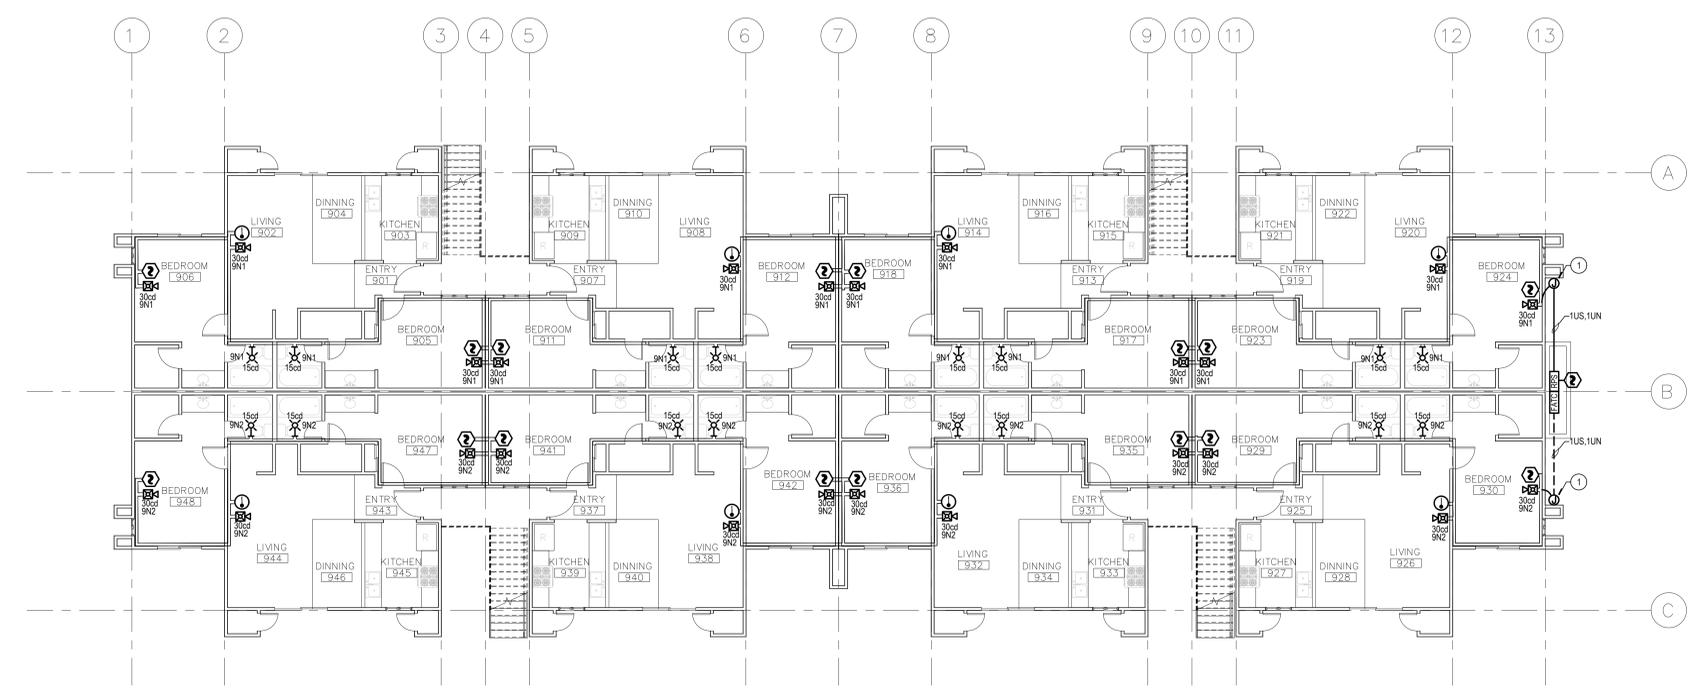

FIRE ALARM PLAN - BUILDING 9 FIRST FLOOR SCALE: 1/8" = 1'-0" 2

miyamoto.
 1901 East Alton Avenue, Suite 100
 Santa Ana, CA 92705
 T: (949) 979-1170
 mmiyamoto@miyamoto.com



231 W. Highland Ave., Suite #100
 San Bernardino, CA 92408
 T: (909) 399-0700
 Fax: (909) 399-0700
 Email: ccs@designwater.com
DESIGN WEST ENGINEERING
 MECHANICAL - ELECTRICAL - ENERGY CONSULTANTS

UNIVERSITY OF CALIFORNIA, RIVERSIDE
 FALKIRK SITE AND SEISMIC IMPROVEMENTS - SUMMER 2019
 3429 CANYON CREST DRIVE
 RIVERSIDE, CA 92507

REVISIONS	ADDENDUM	DATE
1	ADDENDUM 1	6/14/19
2	ADDENDUM 2	6/26/19

UCR PROJECT #: 956390
 UCR CAAN #: P5673
 DATE: 06-14-2019
 DRAWN: S.V

INSPECTIONS REQUIRED
 UC RIVERSIDE
 Office of Planning, Design & Construction
 Signed CBO: Robert K. Williams
 Building, Safety and Compliance Division
 CAMPUS BUILDING PERMIT
 ALL WORK SHALL BE IN ACCORDANCE WITH THE CALIFORNIA FIRE CODE

APPROVED
 UC Riverside
 Planning, Design and Construction
 Campus Building Official
 Signature: Robert K. Williams
 Building & Safety Division
 Campus Building Permit

OFFICE OF THE STATE FIRE MARSHAL
 APPROVED FIRE AND PANIC ONLY
 07/02/2019
 Approval of this plan does not authorize or approve any erection or deviation from applicable regulations. Final approval is subject to field inspection. One set of approved plans shall be available on the project site at all times.
 Reviewed by: [Signature]

FIRE ALARM FLOOR PLAN - BUILDING 9
FA9-2.1

RL PROJECT 2019/07/FALKIRK/4.0/00 IMPROVEMENTS BY FALC/DR/PR/AN - 2019.06.28 - S.M.A.E.L.E.A.

DESIGNATION	TYPE
S	#18/4 FPLP SHIELDED FIRE CABLE (DATA LOOP)
N	#12/2 FPLP FIRE CABLE (HORN/VISUAL)
D	#18/4 FPLP FIRE CABLE (REMOTE ANNUNCIATOR)
E	2#14THWN AWG BUILDING WIRE
'U' - DESIGNATES UNDERGROUND RATED CABLING	

GENERAL NOTES


- ALL WIRING AND CABLING SHOWN IN UNDERGROUND INSTALLATIONS SHALL BE RATED FOR UNDERGROUND USE.
- REFERENCE ELECTRICAL DRAWINGS FOR EXACT CONDUIT ROUTING.
- FIRST FLOOR CABLING SHALL BE RAN USING WIREMOLD RACEWAYS. REFERENCE SHEET FA-3.1 FOR EXACT WIREMOLD REQUIREMENTS.

miyamoto.
 1901 East Alton Avenue, Suite 100
 Santa Ana, CA 92705
 T: (949) 579-1770
 mmyamotointernational.com



221 W. High Street, Suite #100
 San Bernardino, CA 92408
 POC: (909) 393-0700
 Email: ccs@designwatereng.com

DESIGN WEST ENGINEERING
 MECHANICAL • ELECTRICAL • ENERGY CONSULTANTS

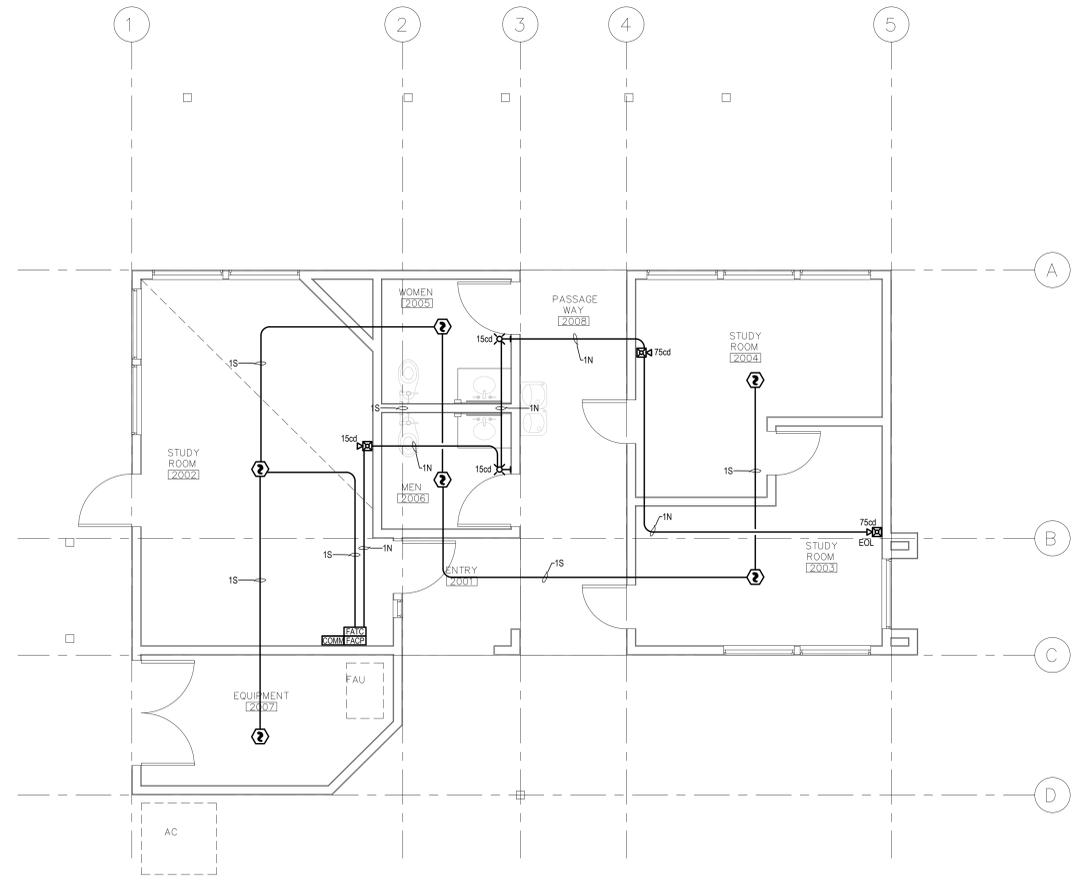

CONSTRUCTION NOTES

UNIVERSITY OF CALIFORNIA, RIVERSIDE
FALKIRK SITE AND SEISMIC IMPROVEMENTS - SUMMER 2019
 3429 CANYON CREST DRIVE
 RIVERSIDE, CA 92507

REVISIONS

1	ADDENDUM 1	6/14/19
2	ADDENDUM 2	6/26/19

UCR PROJECT #: 956390
 UCR CAAN #: P5673
 DATE: 06-14-2019
 DRAWN: S.V

INSPECTIONS REQUIRED
 UC RIVERSIDE
 Office of Planning, Design & Construction
 Signed CBO: *Robert K. Williams*
 Building, Safety and Compliance Division
 CAMPUS BUILDING PERMIT
 ALL WORK SHALL BE REVIEWED FOR THE UTILITY DIVISION

APPROVED
 UC Riverside
 Planning, Design and Construction
 Campus Building Official
 Signature: *Robert K. Williams*
 Building & Safety Division
 Campus Building Permit

OFFICE OF THE STATE FIRE MARSHAL
 APPROVED FIRE AND PANIC ONLY
07/02/2019
 Approval of this plan does not authorize or approve any emission or deviation from applicable regulations. Final approval is subject to field inspection. One set of approved plans shall be available on the project site at all times.
 Reviewed by: *Heath Johnson*
 Fire and Life Safety Division

FIRE ALARM FLOOR PLAN - BUILDING 20
FA20-2.1

FIRE ALARM FLOOR PLAN - BUILDING 20 SCALE: 1/8" = 1'-0" 1

PL PROJECT 2019 05 07 FALKIRK SITE AND SEISMIC IMPROVEMENTS BY FABRIZIO BRYAN - 20190507 - SAMEL DELA




REVISIONS


1	ADDENDUM 1	6/14/19
2	ADDENDUM 2	6/26/19

UCR PROJECT #: 956390
UCR CAAN #: P5673
DATE: 06-14-2019
DRAWN: S.V.


FIRE ALARM
DETAILS
FA-3.1

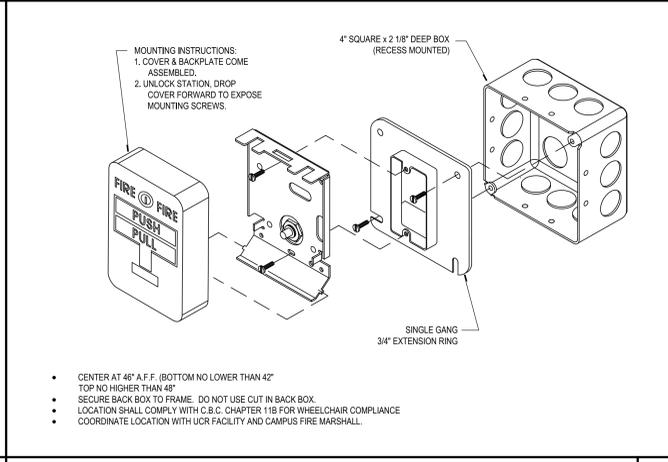


SEMI-FLUSH WEATHER-PROOF PULL STATION 1

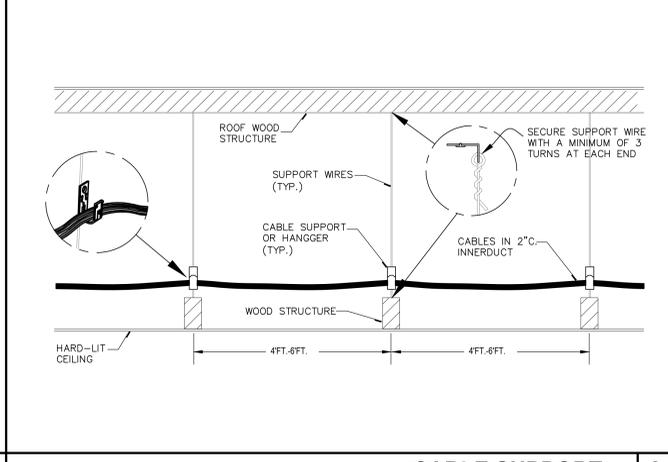


CABLE SUPPORT 2

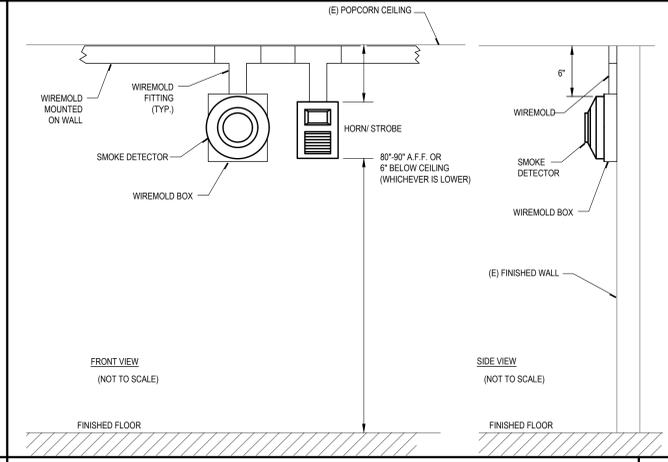


FIRST FLOOR DEVICE MOUNTING 5

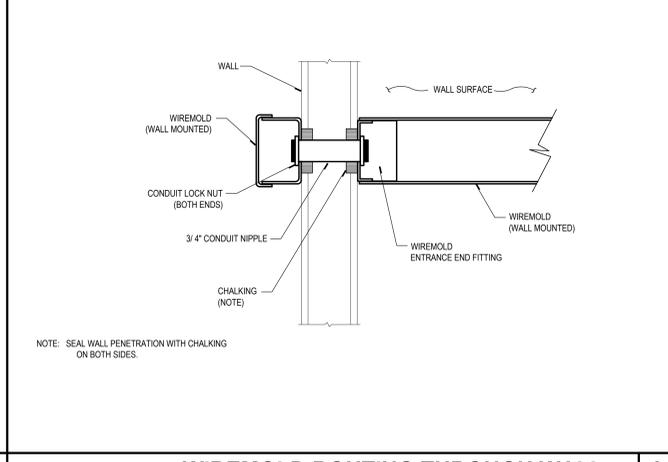


WIREMOLD ROUTING THROUGH WALL 6

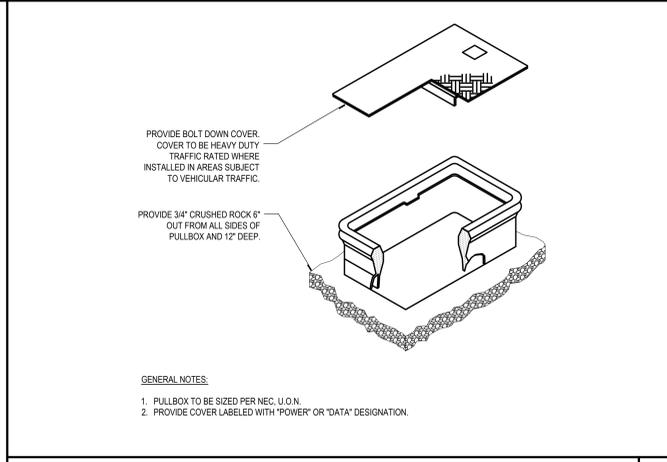


PULL BOX INSTALLATION 9

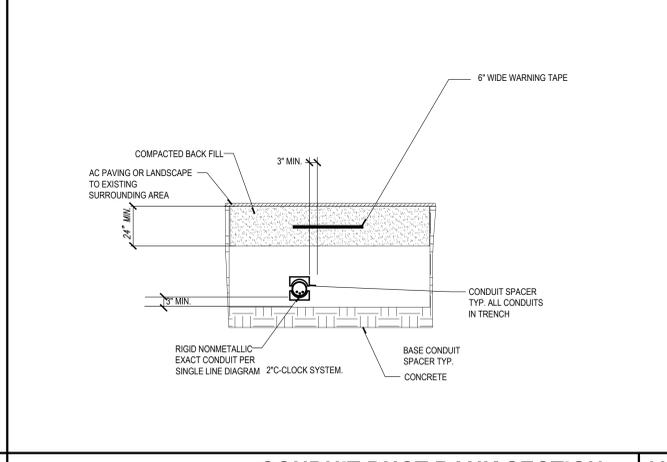


CONDUIT DUCT BANK SECTION 10

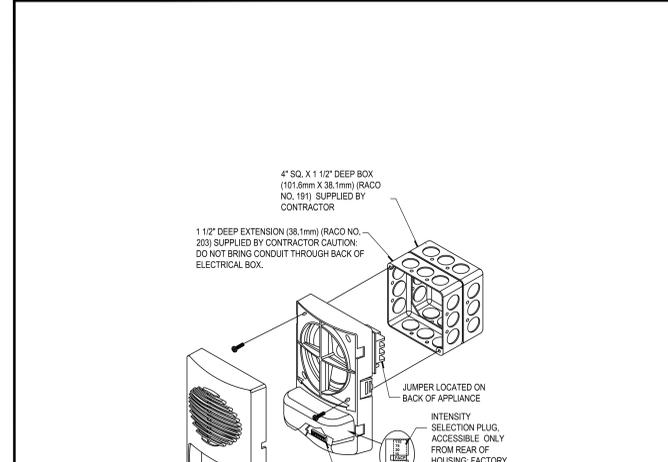


SPEAKER STROBE MOUNTING REQUIREMENTS 13

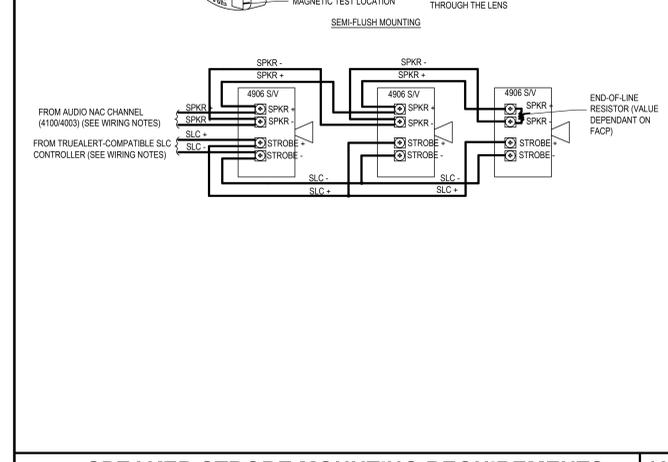

SPEAKER STROBE MOUNTING REQUIREMENTS 13

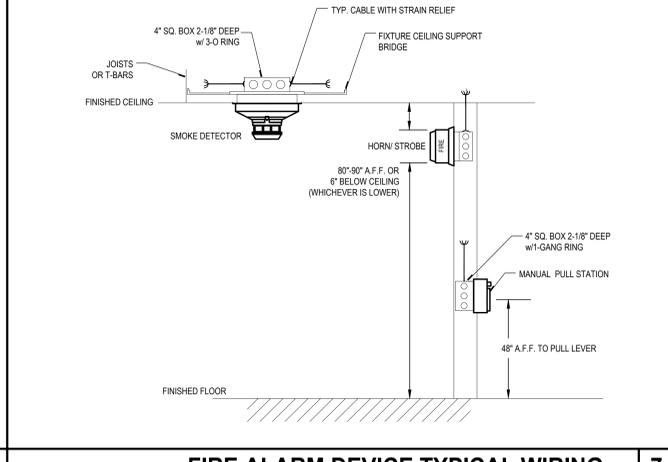

FIRE ALARM DEVICE TYPICAL WIRING 7

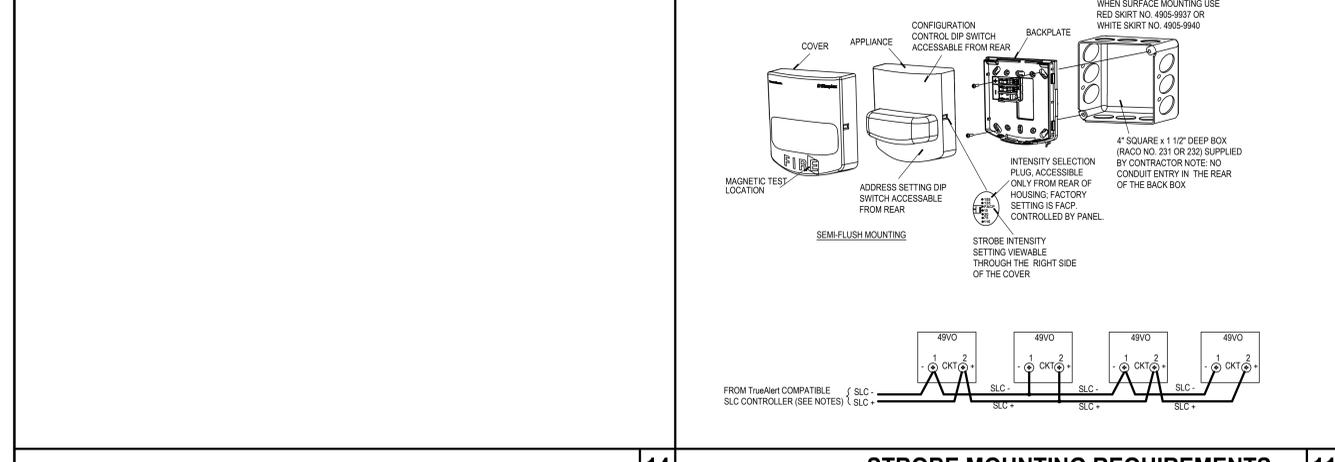


STROBE MOUNTING REQUIREMENTS 11

WIRE SIZE	THIN (7/16")	O.D.	400BAC	800BAC	2300BAC	2300BACD
14 AWG	0.111 (2.8)	0.111 (2.8)	5	5	15	6
12 AWG	0.130 (3.3)	0.130 (3.3)	3	5	14	6
10 AWG	0.164 (4.2)	0.164 (4.2)	0	4	12	5


CABLE/WIRE SIZE	O.D.	400	800	2300	2300D	
UNSHIELDED TWISTED PAIR	4-Par, 24 AWG Cat. 3	0.190 (4.8)	1	3	11	5
4-Par, 24 AWG Cat. 5e	0.210 (5.3)	1	3	9	4	
4-Par, 24 AWG Cat. 6	0.250 (6.3)	1	2	6	3	
4-Par, 24 AWG Cat. 6a*	0.264 (6.7)	0	1	3	1	
25-Par, 24 AWG	0.410 (10.4)	0	0	2	1	
COAXIAL	RGEU	0.270 (6.9)	0	1	5	2
FIBER	Zip Cord 0.118 x 0.157 (3 x 4)	1	3	12	6	
	Round 8 Strand Fiber	0.187 (4.8)	1	3	12	6
	Round 6 Strand Fiber	0.256 (6.5)	1	2	6	3

400BAC, 800BAC, 2300BAC, 2300BACD Series Raceway Ordering Information

Catalog No./Item	Description/Specifications
400BAC	400BAC-WH Low profile, two-piece raceway with snap-on cover - Available in 5' (1.525m) and length. Supplied with wide adhesive tape along entire length of base.
800BAC	800BAC-WH
2300BAC	2300BAC-WH
2300BACD	2300BACD-WH

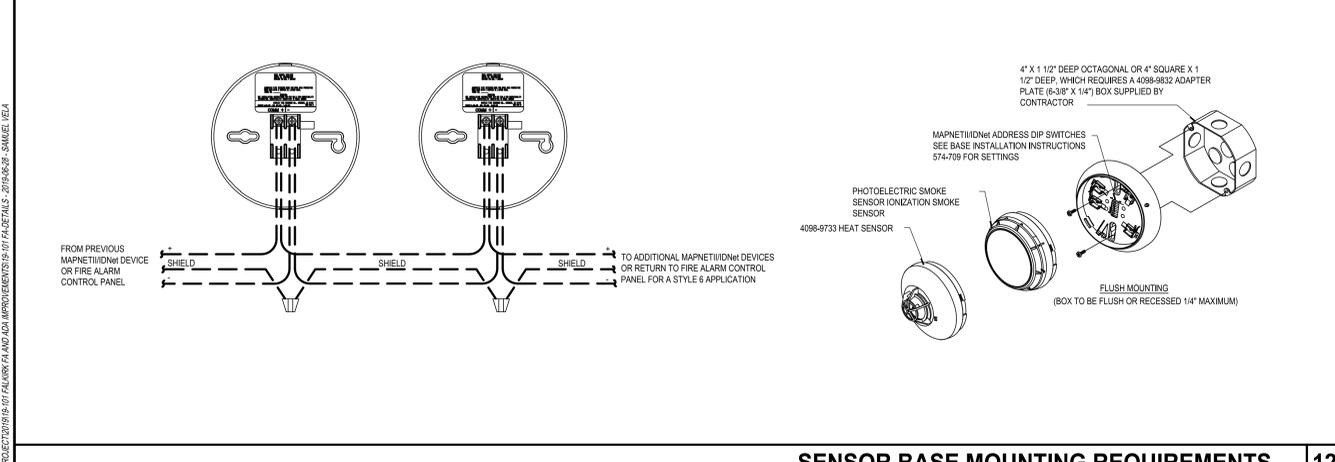

SENSOR BASE MOUNTING REQUIREMENTS 12

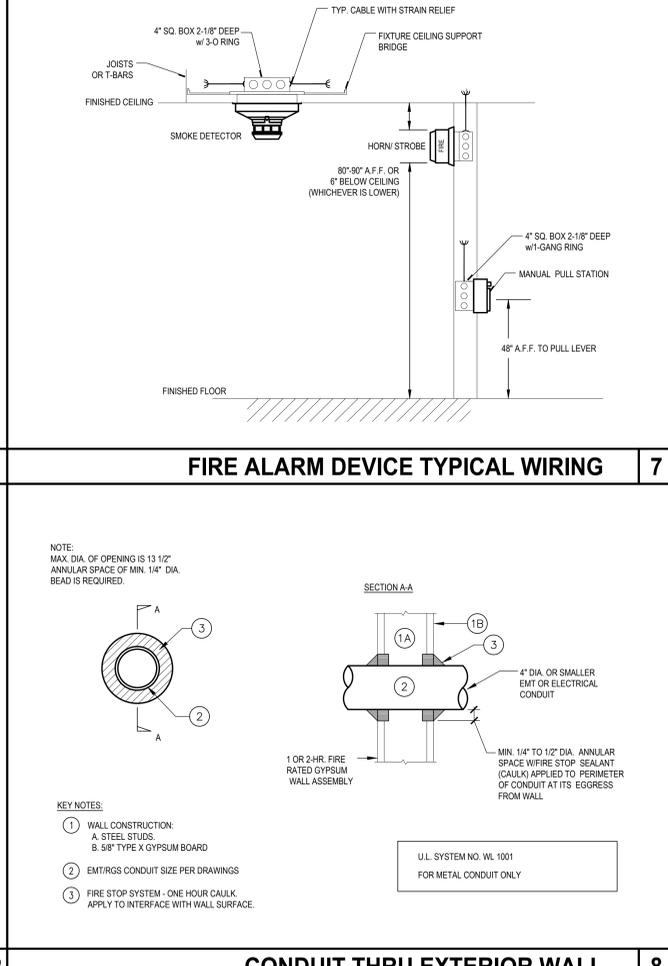

CONDUIT THRU EXTERIOR WALL 8

WIREMOLD 2400 RACEWAY SYSTEM 4

RL PROJECT 2019 05 07 FALKIRK SITE AND SEISMIC IMPROVEMENTS - 07/FACE DETAILS - 2019-05-28 - SAMPLE 1/EA